


1/23/95 Field check ok
 per above + S.T. Co's
 room per C.O.'s of
 12/9/88 + previous
 OK CB

SITE PLAN

LAKHANPAL RESIDENCE
 11694 FARMSIDE RD, ELLICOTT CITY, MD

1" = 50'-0"

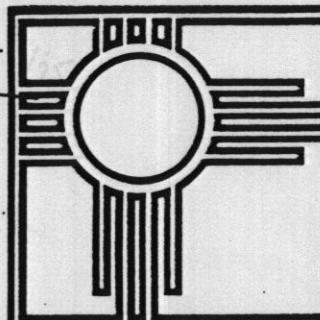

**STEWART
 MC CREADY**
 ARCHITECTS PA

8329 MAIN STREET
 ELLICOTT CITY, MD 21043
 FAX: (410) 465-7737
 (410) 465-7687