

APPLICATION

A 28410

P _____

SEWAGE DISPOSAL TESTING

STATE OF MARYLAND - DEPARTMENT OF HEALTH AND MENTAL HYGIENE

HOWARD COUNTY HEALTH DEPARTMENT
ENVIRONMENTAL HEALTH SERVICES
P. O. BOX 476, ELLICOTT CITY, MARYLAND 21043
TELEPHONE: 465-5000, EXT. 356

Septic Tank { *1-3 Bedrooms* 1000 gallons
4 Bedrooms 1250 gallons
see separate sheet for spec

DATE May 12, 1978

TO: THE COUNTY HEALTH OFFICER
ELLICOTT CITY, MARYLAND

I, HEREBY, APPLY FOR THE NECESSARY TEST IN ORDER TO CONSTRUCT (OR RECONSTRUCT) A SEWAGE DISPOSAL SYSTEM.

PROPERTY OWNER Woodmark, Inc. Dr. Mrs. Sae Manspeaker
8369 Reservoir Road
ADDRESS 9267 Balto. Nat'l. Pike Fulton, Md 20757 PHONE 461-2889 490-5275

PROPERTY LOCATION:

SUBDIVISION Farside LOT NO. 16 15

ROAD AND DESCRIPTION Rt. 40 west to left on Rt. 111, left on Folly Quarter, Left on
Homewood, 1 mile to property on left 11694 Farside Road.

SIZE OF LOT 3 plus acres TYPE BLDG. 4
NUMBER OF BEDROOMS

IF NOT SINGLE RESIDENCE DESCRIBE _____

THE SYSTEM INSTALLED UNDER THIS APPLICATION IS ACCEPTABLE ONLY UNTIL PUBLIC FACILITIES BECOME AVAILABLE.

SIGNATURE OF APPLICANT [Signature]

APPROVED BY Raymond Hodga FOR Dry Well DATE 10/25/79
(KIND OF SYSTEM)


REJECTED BY _____ FOR _____ DATE _____
(KIND OF SYSTEM)

HOLD PENDING FURTHER TESTS _____ DATE _____

REASONS FOR REJECTION OR HOLDING 10/25/79 FINAL PLAT OK

BLDG. PERMIT SIGNED
AND RETURNED [Signature]
Serial #53458 SFD.

THIS IS NOT A PERMIT

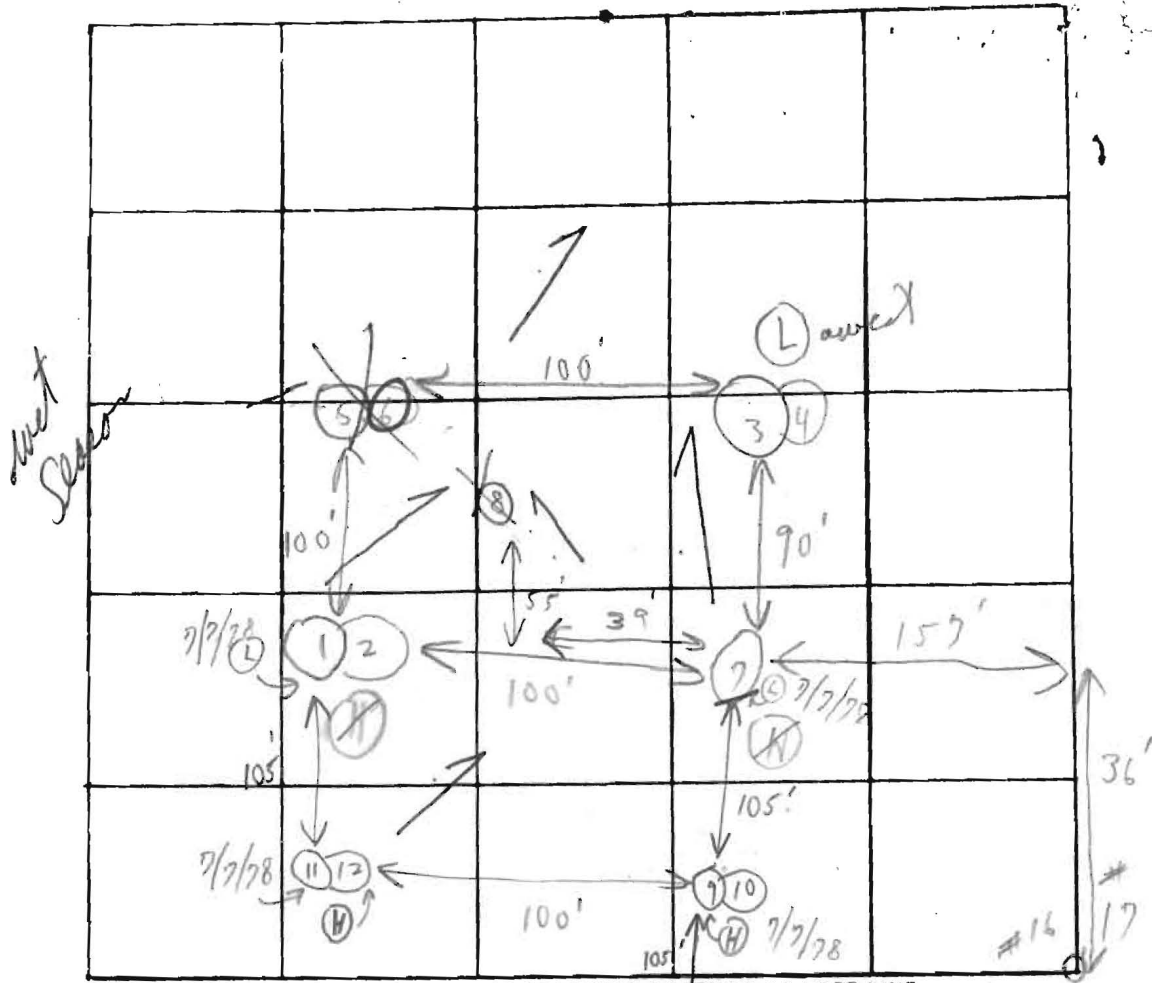

INDICATE NORTH - NAME ADJOINING ROADWAY AS BASE LINE

Unmanned

DATE	TEST NO.	DEPTH	PRE-WET		TEST - 1" DROP		TIME
			START	STOP	START	STOP	
7/6/78	1	4'	2:27	3:29	3:29	3:36	7m
	2	11 1/2'	3:28	3:27	3:29	3:31	1 1/2-2m
	3	4'	3:21	3:22	3:22	3:23	1m + refilled
	4	11 1/2'	3:20			3:21	1m
	5	4'					
	6	9-9 1/2' Water	15 min	9'			
	7	4-11'	Room				
	8	11' Pump + water					(12' deep)
7/7/78	9	3' Visual	11'	Room			
	(H) 10	4'	9:40	9:41	9:41	9:43	2m +
	(H) 11	4'	9:40	9:42	9:42	9:45	3m
	12	12'					

Soil Profile
Below
dry
room

Hold
+ to
retent
in differ
area
wait 4'
3 min w/

REMARKS

Use Open field not tree 821

TYPE OF SOIL

TESTED BY


C.B. & J.D.

ALSO PRESENT:

came yesterday

FAR SIDE

Lot 15

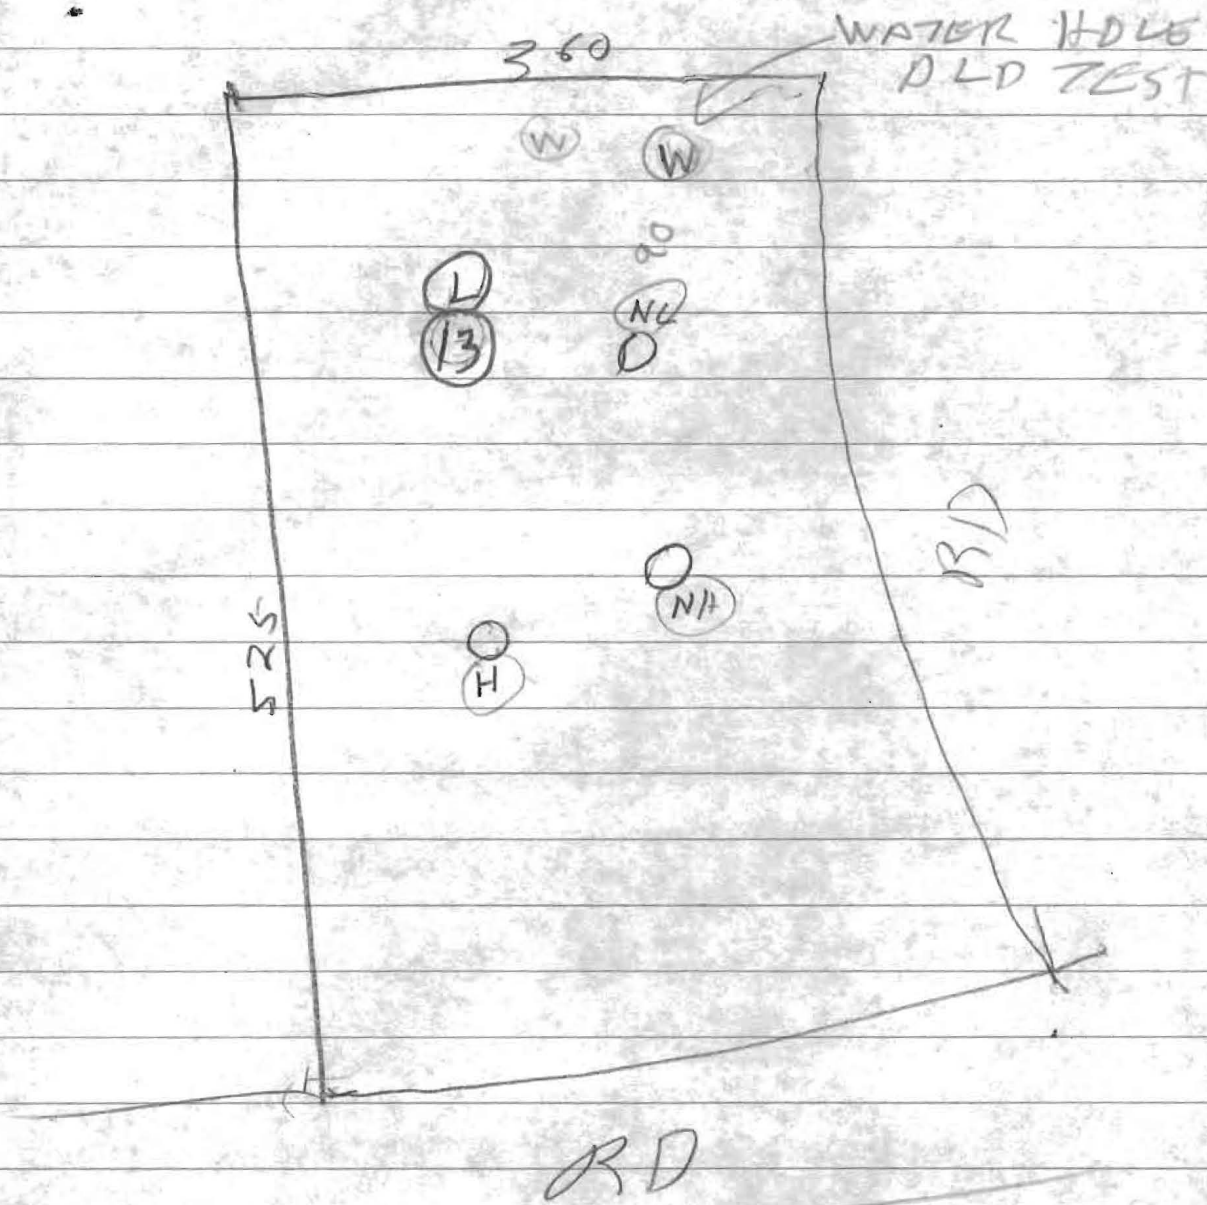

Date	Hole	Depth	
9/21/78	13\1	13 1/2	ALL SAND DRY