

12/19/03 - PM

PUB. SEWER STATUS VERIFIED BY _____

ISSUE DATE: 12/18/03
APPROVAL DATE: 12/19/03

PERMIT

P 520003
A REPAIR

ON-SITE SEWAGE DISPOSAL SYSTEM HOWARD COUNTY HEALTH DEPARTMENT BUREAU OF ENVIRONMENTAL HEALTH

03-289532

Edward Linsenmeyer P & H IS PERMITTED TO INSTALL ALTER

ADDRESS: 9304 Migan Road, Randallstown PHONE NUMBER: 410-922-8172
SUBDIVISION: Berndell Estates LOT NUMBER: 20

ADDRESS: 830 Windy Knoll Road PROPERTY OWNER: Patricia Straat

SEPTIC TANK CAPACITY (GALLONS): 1000
PUMP CHAMBER CAPACITY (GALLONS): N/A
NUMBER OF BEDROOMS: 3
SQUARE FEET PER BEDROOM: 210
LINEAR FEET OF TRENCH REQUIRED: 140

TRENCHES:	Trench to be <u>2</u> feet wide. Inlet <u>5</u> feet below original grade. Bottom maximum depth <u>8</u> feet below original grade. Effective area begins at <u>5</u> feet below original grade. <u>3</u> feet of stone below distribution pipe.
LOCATION:	<u>On Contour 10' CTC</u>
PURPOSE:	Septic system is failing. Call for inspection when the ground has been opened so sanitarian can recommend repair.

PLANS APPROVED: [Signature] DATE: 12/19/03

- NOTE: PERMIT VOID AFTER 2 YEARS
- NOTE: CONTRACTOR RESPONSIBLE FOR SCHEDULING A PRE-CONSTRUCTION INSPECTION FOR ALL INSTALLATIONS
- NOTE: WATERTIGHT SEPTIC TANKS REQUIRED
- NOTE: ALL PARTS OF SEPTIC SYSTEM SHALL BE 100 FEET FROM ANY WATER WELL
- NOTE: MANHOLE RISERS REQUIRED ON ALL SEPTIC TANKS AND PUMP CHAMBERS

NEITHER THE HOWARD COUNTY COUNCIL NOR THE HEALTH DEPARTMENT IS RESPONSIBLE FOR THE SUCCESSFUL OPERATION OF ANY SYSTEM PERMITTEE RESPONSIBLE FOR OBTAINING FINAL APPROVAL ON THIS PERMIT CALL 410-313-2640 FOR INSPECTION OF SEPTIC SYSTEM


(A)

NOT TO SCALE

6' deep - 10:37 / 10:46 / 10:57 → 11 min

Topsoil
Orange Red
silty clay

5'
Brown/Tan
clay loam

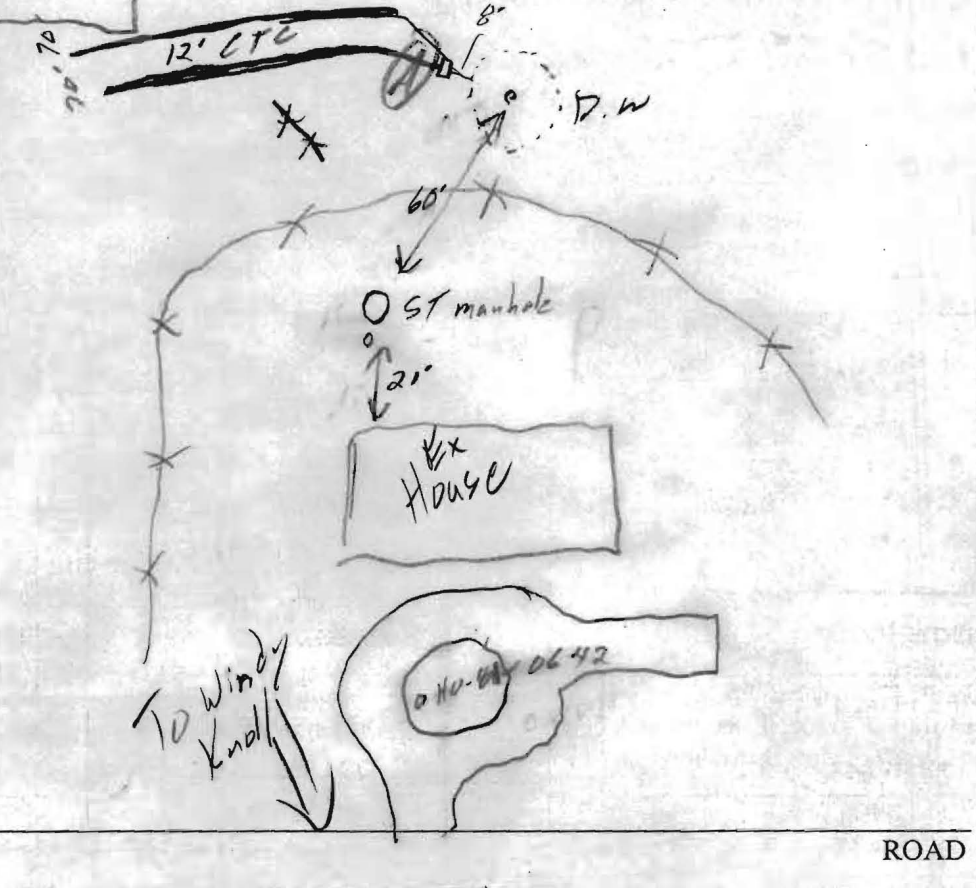

TRENCH/DRAINFIELD DATA		
WIDTH	INLET	BOTTOM
2'	5'	8'
NUMBER OF TRENCHES		2
TOTAL LENGTH		140
ABSORPTION AREA		420 ft
DISTRIBUTION BOX LEVEL		<input checked="" type="checkbox"/>
DISTRIBUTION BOX BAFFLE		<input checked="" type="checkbox"/>
DISTRIBUTION BOX PORT		<input type="checkbox"/>

SEPTIC TANK DATA	
SEPTIC TANK 1 LEVEL	EX 1000
CAPACITY	_____ GAL
SEAM LOC	_____
TANK LID DEPTH	_____
BAFFLES	_____
BAFFLE FILTER	_____
MANHOLE LOC	_____
6" PORT LOC	_____
WATERTIGHT TEST	_____
SEPTIC TANK 2 LEVEL	_____
CAPACITY	_____ GAL
SEAM LOC	_____
TANK LID DEPTH	_____
BAFFLES	_____
BAFFLE FILTER	_____
MANHOLE LOC	_____
6" PORT LOC	_____
WATERTIGHT TEST	_____

PRE-CONSTRUCTION 12/18/03 - See specs on front SU

INSTALLATION 12/18/03 - 1st trench installed, OK to cover (50)
12/19/03 - OK to cover all work

FINAL INSPECTOR [Signature] DATE OF APPROVAL 12/19/03