



DATE SYSTEM APPROVED 7/12/41 INSPECTOR [Signature]

REMARKS \_\_\_\_\_

ASSESSMENT AREA 16/2 SQ. FT.

SEPAGE PITS, INSIDE DIRECTION 63 FT. DEPTH BELOW INLET 10 FT.

NUMBER OF TRENCHES \_\_\_\_\_ TOTAL BOTTOM AREA \_\_\_\_\_

GRAVEL DEPTH \_\_\_\_\_ IN. TOTAL LENGTH \_\_\_\_\_ FT.


TILE FIELD DEPTH \_\_\_\_\_ FT. TRENCH WIDTH \_\_\_\_\_ FT.

DISTRIBUTION BOX LEVEL N79


SEPTIC TANK LEVEL [check]

PERMIT CARD [check]

CLEANOUTS ST OK OR do

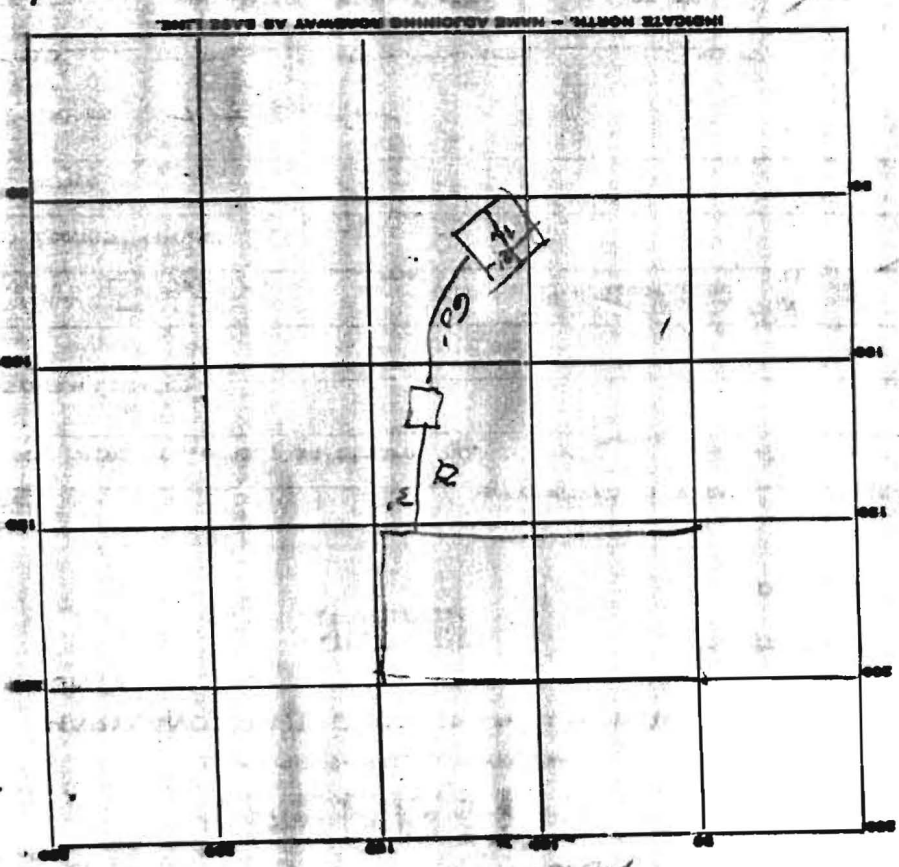

1213.00  
IND 2.3  
1" CROSS  
K1. MASH  
K1. YAS  
21. YAS  
63  
= 63  
4/41

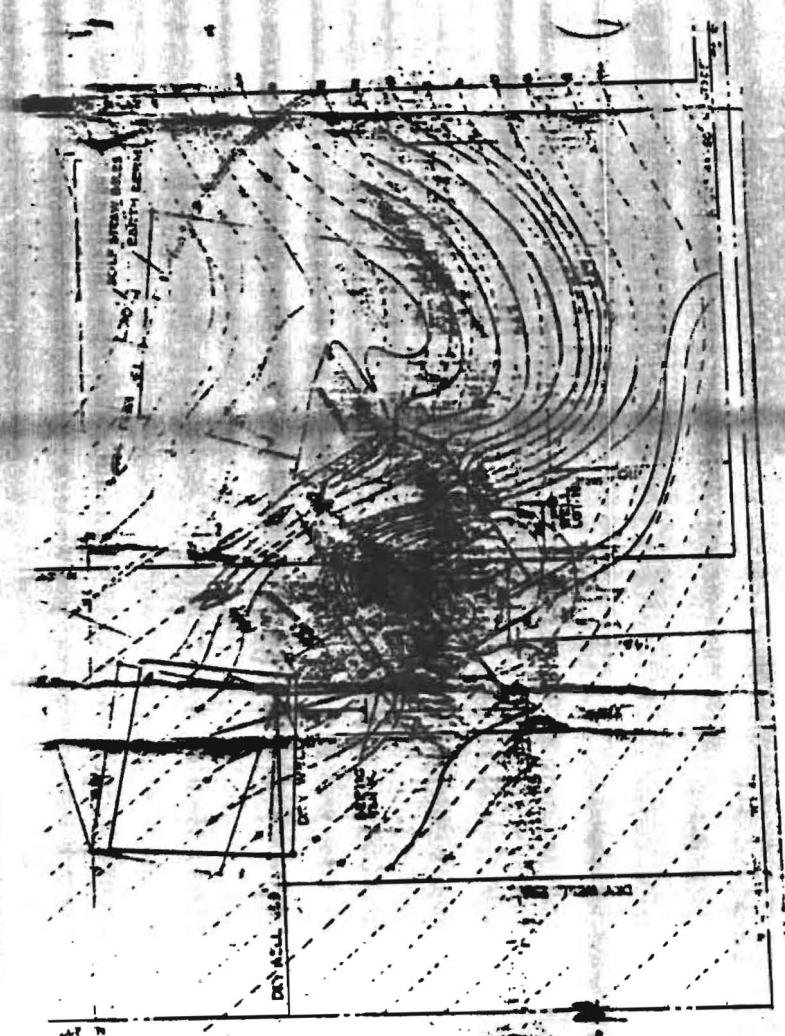

Sketch  
OK by LWHZ 3/31/76