

3916
THIS REPORT MUST BE SUBMITTED WITHIN 30 DAYS AFTER WELL COMPLETION
FILL IN THIS FORM COMPLETELY
COUNTY NUMBER

STATE OF MARYLAND
WATER RESOURCES ADMINISTRATION
TAVES STATE OFFICE BLDG., ANNAPOLIS, MD. 21401
WELL COMPLETION REPORT

DATE RECEIVED (MAY USE ONLY)
DATE WELL COMPLETED
DEPTH OF WELL
DRILLERS IDENTIFICATION NO.

OWNER: Gene Bone
LAST NAME
STREET OR RFD: 8727 Jackman Blvd.
POST OFFICE: Thurston Md.

WELL LOG

STATE THE KIND OF FORMATIONS PENETRATED, THEIR COLOR, DEPTH, THICKNESS AND IF WATER SEAGING

DESCRIPTION (USE ADDITIONAL SHEETS IF NECESSARY)	FEET		WATER SEAGING
	FROM	TO	
Top Soil	0	2	
Brown Shale	2	11	
Brown Slate	11	40	
Blue Slate	40	50	
Brown Slate	50	55	
Blue Slate	55	80	

WELL DESCRIPTION

GRouting RECORD
WELL HAS BEEN GROUTED (CIRCLE APPROPRIATE BOX)
TYPE OF GROUTING MATERIAL (CIRCLE ONE)
CEMENT M
BENTONITE CLAY C
NO. OF BAGS 500
GALLONS OF WATER 25
DEPTH OF GROUT SEAL (TO NEAREST FOOT)
FROM 0 FT. TO 17 FT.

CASING RECORD
CASING TYPES (INSERT APPROPRIATE CODE BELOW)
STEEL Y
CONCRETE C
PLASTIC PL
OTHER O
MAIN CASING TYPE ST
NOMINAL DIAMETER TOP (NEAREST INCH) 6
TOTAL DEPTH OF MAIN CASING (NEAREST FOOT) 22

OTHER CASING (IF USED)
DIAMETER (INCH) _____ DEPTH (FEET) FROM TO _____

SCREEN RECORD
SCREEN TYPE (INSERT APPROPRIATE CODE BELOW)
STEEL S
BRASS OR BRONZE B
PL P
OY O
OTHER O

DEPTH OF WELL
C 2
DEPTH (NEAREST WHOLE FOOT)
FROM 20 TO 80
SLOT SIZE 1. _____ 2. _____ 3. _____

CIRCLE APPROPRIATE BOXES
A WELL WAS ABANDONED AND SEALED WHEN THIS WELL WAS COMPLETED
E ELECTRIC LOG OBTAINED
P TEST WELL CONVERTED TO PRODUCTION WELL

I HEREBY CERTIFY THAT I HAVE COMPLIED WITH ALL CONDITIONS STATED ON THE ABOVE-CAPTIONED "PERMIT TO DRILL WELL", AND THAT INFORMATION CONTAINED IN THIS REPORT IS TRUE, ACCURATE, AND COMPLETE TO THE BEST OF MY KNOWLEDGE, INFORMATION AND BELIEF.

DRILLERS NAME
PLEASE PRINT: S. F. Carter
SIGNATURE: S. F. Carter

DIAMETER OF CEMENT _____ (NEAREST INCH)
TRAVEL PACK _____
IF WELL DRILLED WAS A PLUMBING WELL CIRCLE ONE P
MAY USE ONLY (NOT TO BE FILLED IN BY DRILLER)
TELEPHONE NUMBER _____
LOG INDICATOR _____
OTHER DATA AVAILABLE _____


PUMPING TEST

HOURS PUMPED (TO NEAREST HOUR) 2
PUMPING RATE (GALLONS PER MINUTE TO NEAREST GALLON) 40
METHOD USED TO MEASURE PUMPING RATE Bucket
WATER LEVEL (DISTANCE FROM LAND SURFACE) BEFORE PUMPING 90
AFTER PUMPING 80
TYPE OF PUMPER USED (CIRCLE APPROPRIATE ONE)
A JET PUMP
B PROVER
Y TURBINE
C CENTRIFUGAL
R ROTARY
O OTHER (SPECIFY BELOW)
J JET
S SUBMERSIBLE

PUMP INSTALLED

TYPE OF PUMP (WRITE APPROPRIATE LETTERS IN ONE - SEE ABOVE: A, C, J, P, R, S, T, O)
DRILLER WILL INSTALL PUMP (CIRCLE APPROPRIATE BOX) YES NO
CAPACITY: GALLONS PER MINUTE (TO NEAREST GALLON) _____
PUMP HOLES DEPTH _____
PUMP COLUMN LENGTH (NEAREST FOOT) _____
CASING HEIGHT (CIRCLE APPROPRIATE BOX AND ENTER CASING HEIGHT)
+ ABOVE LAND SURFACE
- BELOW LAND SURFACE

LOCATION OF WELL ON LOT

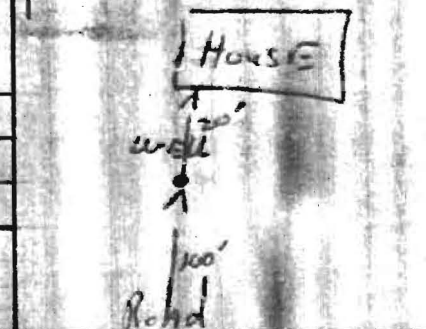

C1 0732

SEQUENCE NO. (DEP USE ONLY)

STATE OF MARYLAND WELL COMPLETION REPORT

THIS REPORT MUST BE SUBMITTED WITHIN 45 DAYS AFTER WELL IS COMPLETED.

(THIS NUMBER IS TO BE PUNCHED IN GOLS. 34 ON ALL CARDS)

COUNTY NUMBER A23489Z

DATE RECEIVED

DATE WELL COMPLETED 10/23/80

Depth of Well 22 144 26 (TO NEAREST FOOT)

PERMIT NO. FROM "PERMIT TO DRILL WELL" 40-81-0642

OWNER Montgomery 855 Windy Knoll SUBDIVISION Brendell Estates

Virginia first name TOWN Slacks Corner SECTION LOT 20

WELL LOG Not required for driven wells

STATE THE KIND OF FORMATIONS PENETRATED, THEIR COLOR, DEPTH, THICKNESS AND IF WATER BEARING

Table with columns: DESCRIPTION (U-6 additional sheets if needed), FEET (FROM, TO), check if water bearing. Entries: Brown shale 0-15, Gray granite 15-144.

GROUTING RECORD

WELL HAS BEEN GROUTED (Circle Appropriate Box) TYPE OF GROUTING MATERIAL CEMENT [CM] BENTONITE CLAY [BC] NO. OF BAGS 5 NO. OF POUNDS 470 GALLONS OF WATER 30 DEPTH OF GROUT SEAL (to nearest foot) from 0 to 24 ft.

CASING RECORD casing types insert appropriate code below: ST CO STEEL CONCRETE PL OT PLASTIC OTHER

MAIN CASING TYPE Nominal diameter (nearest inch) Total depth of main casing (nearest foot)

OTHER CASING (if used) diameter inch depth (feet) from to

SCREEN RECORD screen type or open hole insert appropriate code below: STY BTR HO STEEL BRASS OPEN BRONZE HOLE PL OT PLASTIC OTHER

Table for screen depth: EACH SCREEN, DEPTH (nearest ft.), SLOT SIZE, DIAMETER OF SCREEN (NEAREST INCH)

GRAVEL PACK IF WELL DRILLED WAS FLOWING WELL INSERT F IN BOX 66

DEP USE ONLY (NOT TO BE FILLED IN BY DRILLER) TELESCOPE CASHING LOG INDICATOR OTHER DATA

C 3

PUMPS TEST HOURS PUMPED (nearest hour) 31 PUMPING RATE (gal. per min. to nearest gal.) 75 METHOD USED TO MEASURE PUMPING RATE: Ciri WATER LEVEL (distance from land surface) BEFORE PUMPING 30 WHEN PUMPING 49 TYPE OF PUMP USED (for test) A air P piston T turbine C centrifugal R rotary O other (describe below) J jet B submersible

PUMP INSTALLED DRILLER WILL INSTALL PUMP YES (NO) IF DRILLER INSTALLS PUMP, THIS SECTION MUST BE COMPLETED FOR ALL WELLS EXCEPT HOME USE TYPE OF PUMP INSTALLED MAKE (A.S.I.P.A.S.T.) IN BOX - SEE ABOVE: CAPACITY: GALLONS PER MINUTE (to nearest gallon) PUMP HORSE POWER PUMP COLUMN LENGTH (nearest ft.) CASING HEIGHT (circle appropriate box and enter casing height) LAND SURFACE (nearest foot)

LOCATION OF WELL ON LOT SHOW PERMANENT STRUCTURE SUCH AS BUILDING, SEPTIC TANKS, AND/OR LANDMARKS AND INDICATE NOT LESS THAN TWO DISTANCES (MEASUREMENTS TO WELL)



CIRCLE APPROPRIATE LETTER A WELL WAS ABANDONED AND SEALED WHEN THIS WELL WAS COMPLETED E ELECTRIC LOG OBTAINED P TEST WELL CONVERTED TO PRODUCTION WELL

I HEREBY CERTIFY THAT THIS WELL HAS BEEN CONSTRUCTED IN ACCORDANCE WITH COMAR 10.17.13 "WELL CONSTRUCTION" AND IN CONFORMANCE WITH ALL CONDITIONS STATED IN THE ABOVE CAPTIONED PERMIT, AND THAT THE INFORMATION PRESENTED HEREIN IS ACCURATE AND COMPLETE TO THE BEST OF MY KNOWLEDGE.

DRILLER'S IDENT. NO. 234 DRILLER'S SIGNATURE (MUST MATCH SIGNATURE ON APPLICATION)

SITE SUPERVISOR (sign. of driller or journeyman responsible for sitework if different from permittee)

HEALTH