

4-12' Lined  
on 12,000 ft.

# APPLICATION

A 20472  
P \_\_\_\_\_

*Preliminary*

SEWAGE DISPOSAL TESTING

STATE OF MARYLAND - DEPARTMENT OF HEALTH AND MENTAL HYGIENE

HOWARD COUNTY HEALTH DEPARTMENT *3 BR - 1170 gal 57*  
ENVIRONMENTAL HEALTH SERVICES *4 BR - 1250 gal 57*  
P. O. BOX 476, ELLICOTT CITY, MARYLAND 21043  
TELEPHONE: 465-8000, EXT. 350

DISTRICT 1  
DATE 8/2/76

\* Dry well (s): to have 138 sq ft. effective absorbent sidewall area per bedroom below the first 5 ft of ground at original grade. Being rilet into dry well at 4 ft below original grade. Maximum depth of 21 ft to be 12 ft. Locate dry well(s) ~~15~~ <sup>10</sup> ft from the 714.57' property line, and ~~15~~ <sup>10</sup> ft from the 753.44' (right of way dimension) property line. \* Dig trenches to be used. Call this office for permission and recommendation.

TO: THE COUNTY HEALTH OFFICER  
ELLICOTT CITY, MARYLAND

I, HEREBY, APPLY FOR THE NECESSARY TEST IN ORDER TO CONSTRUCT (OR RECONSTRUCT) A SEWAGE DISPOSAL SYSTEM. Location A ok as per retest 8/19/76 WNZ

PROPERTY OWNER L A N, INC.  
ADDRESS (Mrs. Lillian E. Podell) PHONE \_\_\_\_\_  
Any questions call: JOHN GLEN  
465-7700, Ext. 25

PROPERTY LOCATION:  
SUBDIVISION \_\_\_\_\_ LOT NO. 78  
ROAD AND DESCRIPTION Route 32 & River Road

SIZE OF LOT 5.032 ACRES TYPE BLDG. 3 OF 4  
NUMBER OF BEDROOMS (Single Entry, Drily.)  
IF NOT SINGLE RESIDENCE DESCRIBE \_\_\_\_\_

THE SYSTEM INSTALLED UNDER THIS APPLICATION IS ACCEPTABLE ONLY UNTIL PUBLIC FACILITIES BECOME AVAILABLE.

SIGNATURE OF APPLICANT /s/ Mrs. Lillian E. Podell BLDG. PERMITS SIGNED AND RETURNED 4/6/76

APPROVED BY William H. Zapp FOR Dry well DATE 10/28/74  
(KIND OF SYSTEM)


REJECTED BY \_\_\_\_\_ FOR \_\_\_\_\_ DATE \_\_\_\_\_  
(KIND OF SYSTEM)

HOLD PENDING FURTHER TESTS  WNZ DATE 8/23/74

REASONS FOR REJECTION OR HOLDING further testing  
All holes must be certified

## THIS IS NOT A PERMIT



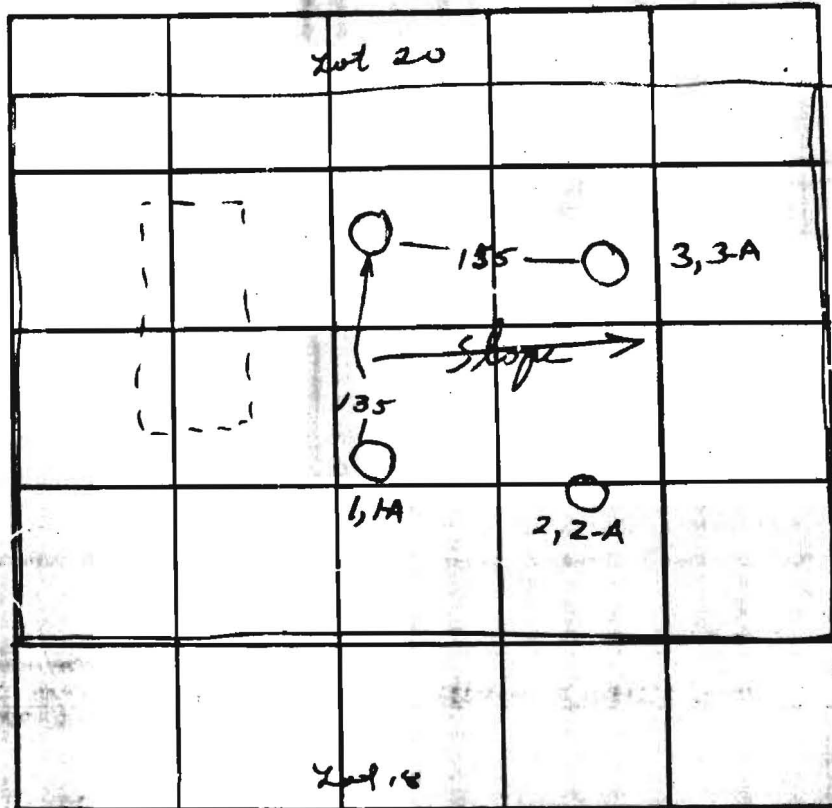

$\frac{45}{3}$   
125

Lot 19

INDICATE NORTH - NAME ADJOINING ROADWAY AS BASE LINE.  
RIVER RD

DATE	TEST NO.	DEPTH	PRE-WET		TEST - 1" DROP		TIME	
			START	STOP	START	STOP		
9/4/74	1	4	3:32	3:34	3:34	3:37	3	
	1-A	12	3:32	3:35	3:35	3:40	5	
	2	4	3:36	3:39	3:39	3:45	6	
	2-A	12	3:36	3:42	3:42	3:50	8	
	3	5	3:45	3:47	3:47	3:51	4	
	3-A	11	3:45	3:50	3:50	3:59	9	
	4	12	visual; air to test; dry					

$\bar{t} = 35\% = 6m$   
100#/BR  
 $120\% = 20\%$   
5N  
120#/BR  
Inlet @ 4'

REMARKS \_\_\_\_\_

TYPE OF SOIL Loose, sandy

TESTED BY WVZ

ALSO PRESENT: owner

