

6/30/77 - appeal
afternoon

PERMIT

SEWAGE DISPOSAL SYSTEM

MARYLAND STATE DEPARTMENT OF HEALTH

HOWARD COUNTY

ELLICOTT CITY

DISTRICT 4th

DATE 6/13/77

INDEXED

S. Barton Truesdell

IS PERMITTED TO INSTALL X ALTER

ADDRESS 8A Crescent Road, Greenbelt, Maryland 20770 PHONE 474-7417

A SEWAGE DISPOSAL SYSTEM LOCATED AT

SUBDIVISION Daisy Hill Estates ROAD Union Chapel Road LOT Parcel F

PROPERTY OWNER S. Barton & Marlene H. Truesdell

ADDRESS SAME AS ABOVE

SPECIFICATIONS 3 bedrooms

DRAIN FIELD DEPTH FEET, BOTTOM AREA SQ. FT.

SEEPAGE PITS ABSORBENT SIDE-WALL AREA SQ. FT.

SEPTIC TANK CAPACITY 1000 GALLONS

FOR GARBAGE GRINDER, INCREASE DISPOSAL AREA 25% & TANK CAPACITY 50%.

OTHER DRY WELL - 435 sq. ft. sidewall area below the inlet. Inlet at 4 ft. below original grade with maximum depth of the dry well to be 12 ft. below original grade. To locate the dry well site: 1.) Start at the corner of the right-of-way and measure along lot line which is 465 ft. long. 2.) Measure 295 ft.. 3.) Turn a right angle at that point and measure 187 ft. This is dry well site.

NOTE: NO DRY WELL IS TO EXCEED 15 FOOT IN DIAMETER.

NOTE: ALL PIPE FROM HOUSE TO DISPOSAL AREA MUST BE CAST IRON.

PERMIT VOID AFTER THREE YEARS.

NOTE: INSTALL STAND PIPE ON SEPTIC TANK AND DRY WELL. STAND PIPES MUST BE 6 INCHES


PLANS APPROVED BY Raymond Hodges DATE 5/27/71

IN DIAMETER. CAST IRON, CONCRETE OR TERRA COTTA ACCEPTED.

FILL SEPTIC TANK AND DISTRIBUTION BOX WITH WATER BEFORE CALLING FOR AN INSPECTION. COVER NO WORK UNTIL INSPECTED AND APPROVED.

NEITHER THE HOWARD COUNTY COMMISSIONERS NOR THE HEALTH DEPARTMENT IS RESPONSIBLE FOR THE SUCCESSFUL OPERATION OF ANY SYSTEM.

215943

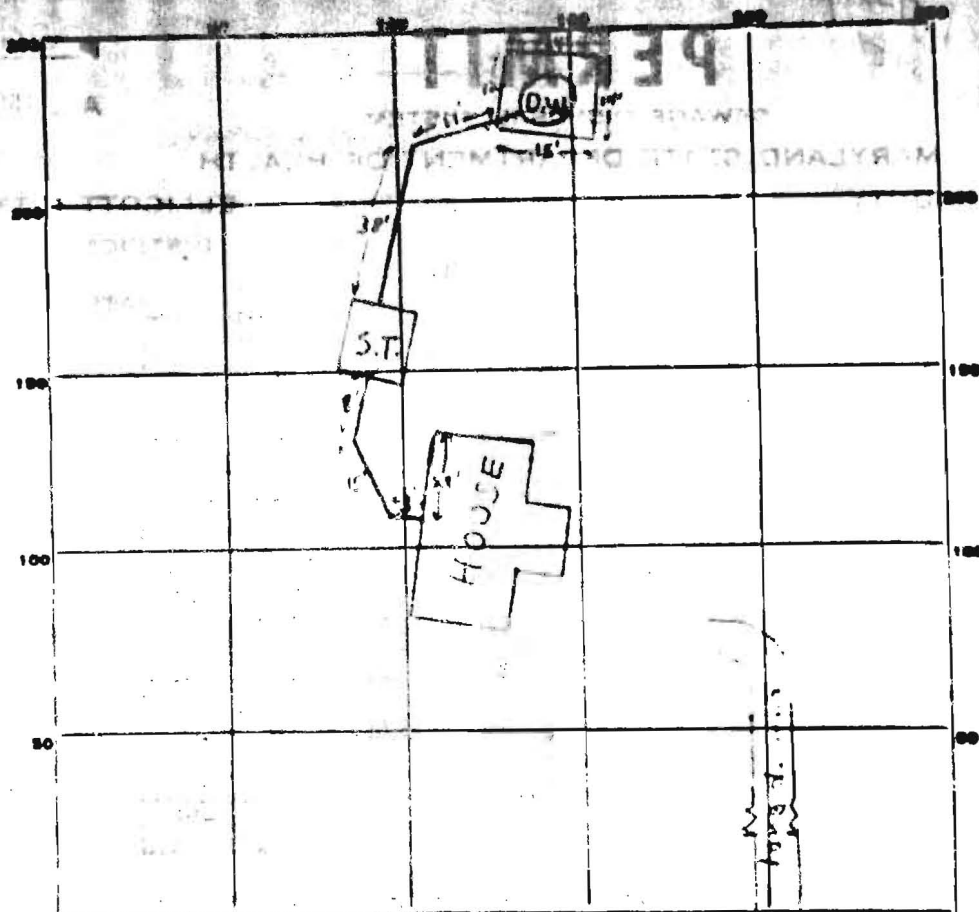

INDICATE NORTH - NAME ADJOINING ROADWAY AS BASE LINE.

Union Chapel Road

PERMIT CARD 1000-100

SEPTIC TANK, LEVEL 1000 gal

CLEANOUTS 1 ✓

DISTRIBUTION BOX, LEVEL 0.0

TILE FIELD, DEPTH FT. TRENCH WIDTH FT.

GRAVEL DEPTH IN. TOTAL LENGTH FT.

NUMBER OF TRENCHES TOTAL BOTTOM AREA

SEEPAGE PITS, INSIDE DIAMETER 5.5 FT. DEPTH BELOW INLET 9' (8' diff) FT.

ABSORBENT AREA 440 SQ. FT.

REMARKS 1/2" D. pipe at 40' on line to 10' in. to P.F.

DATE SYSTEM APPROVED 6/3/77 INSPECTOR F. Thirion