

APPLICATION

SEWAGE DISPOSAL TESTING

MARYLAND STATE DEPARTMENT OF HEALTH

HOWARD COUNTY 1000 Gallon Tank

ELLICOTT CITY

DISTRICT

DATE

3/3/77

1:30 P.M.
visual hole

A-15723
P-

Dry Well 4:5 sp ft sidewalk area
to be located with maximum depth
at time of test of 12 FT
To locate the Dry Well 8 ft. Observe at corner of the Dry Well
8 ft. measure along the line which is 45 ft. long 2 measures
298 FT. Turn a right angle at that point
TO THE COUNTY HEALTH OFFICER
ELICOTT CITY, MARYLAND measure 187 ft. This is Dry Well hole

I, HEREBY, APPLY FOR THE NECESSARY TESTS IN ORDER TO CONSTRUCT OR RECONSTRUCT A SEWAGE DISPOSAL SYSTEM.

PROPERTY OWNER J. Barton & Marlene H. Truesell

ADDRESS 8A Crescent Road, Greenbelt, Md 20770

PROPERTY LOCATION

Home 474-7417
Work 404-426 7734

SUBDIVISION Delray Hill Estates LOT NO. Parcel "Y"

ROAD AND DESCRIPTION Union Chapel Road, 350' east of Delray Road

OCCUPANT None PHONE

PERSON TO CONSTRUCT SYSTEM

ADDRESS PHONE

SIZE OF LOT 9.5007 acres TYPE BLDG Three

IF NOT SINGLE RESIDENCE DESCRIBE

BLDG. PERMITS None
AND RETURNED 3/4/77
506.20

SIGNATURE OF APPLICANT Delray Hill, Joint Venture, By [Signature]


APPROVED BY [Signature] FOR [Signature] DATE 5/12/77

REJECTED BY FOR DATE

HOLD PENDING FURTHER TESTS DATE

REASONS FOR REJECTION OR HOLDING

THIS IS NOT A PERMIT

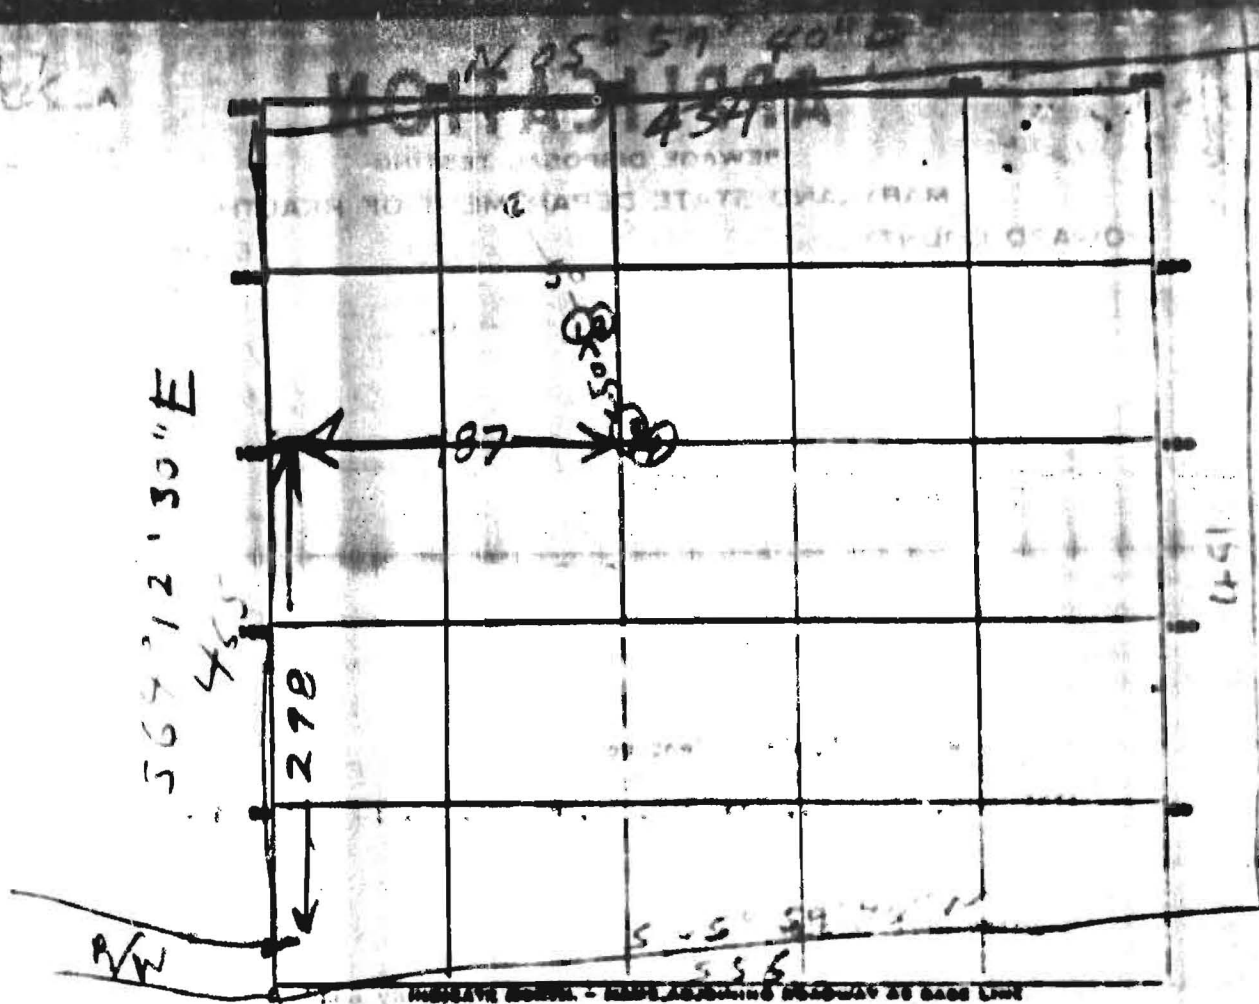

DATE	TEST NO.	DEPTH	PRE-WET START	STOP	TEST - 1" DEEP START	STOP	TIME
5/20/71	1	10"	957	1007	1007	1024	10
	2	4 1/2	959	1002	1002	1010	8
	3	10	1000	1002	1002	1014	12
	4	4 1/2	1001	1006	1006	1014	8
	5	12	SAME PLACE AS (4) NO WATER SAND & ROCK				
	6	10	Same place as (4) silty 100-holes				

BOIL AUGER FINDING

TESTED BY

REMARKS

4

4

