

PERMIT

SEWAGE DISPOSAL SYSTEM

MARYLAND STATE DEPARTMENT OF HEALTH

HOWARD COUNTY

INDEXED

ELLICOTT CITY

DISTRICT 4th

DATE 12/14/73

Russell W. Allen

IS PERMITTED TO INSTALL ALTER

ADDRESS 30 East Pleasant Hill Road, Owings Mills, Md.

PHONE 356-4959

A SEWAGE DISPOSAL SYSTEM LOCATED AT _____

SUBDIVISION Gerber Knoll

ROAD 1140 Underwood Road

LOT ?

PROPERTY OWNER Roland & Phyllis M Link.

ADDRESS 7300 Castlemoor Road, Baltimore, Md. 21207

Phone: 944-5842

SPECIFICATIONS 3 bedrooms

DRAIN FIELD _____ DEPTH _____ FEET, BOTTOM AREA _____ SQ. FT.

SEEPAGE PITS _____ ABSORBENT SIDE-WALL AREA _____ SQ. FT.

SEPTIC TANK CAPACITY 1000 GALLONS

FOR GARBAGE GRINDER, INCREASE DISPOSAL AREA 25% & TANK CAPACITY 50%.

absorbent area to begin at

OTHER DRY WELL - 150 sq. ft. per bedroom above maximum depth and below inlet. Inlet depth 7 ft. Maximum depth 13 ft. Locate dry well 275 ft. from front lot line and 45 ft. from right lot line as seen when facing property from Underwood Road.

NOTE: ALL PIPE FROM HOUSE TO DRY WELL MUST BE CAST IRON.

PERMIT VOID AFTER THREE YEARS.

NOTE: INSTALL STAND PIPE ON SEPTIC TANK AND DRY WELL.

PLANS APPROVED BY Howard L. Snyder

DATE 12/1/72

FILL SEPTIC TANK AND DISTRIBUTION BOX WITH WATER BEFORE CALLING FOR AN INSPECTION. COVER NO WORK UNTIL INSPECTED AND APPROVED.


NEITHER THE HOWARD COUNTY COMMISSIONERS NOR THE HEALTH DEPARTMENT IS RESPONSIBLE FOR THE SUCCESSFUL OPERATION OF ANY SYSTEM.

! Springs will be used & Russell W. Allen will be responsible for the system

Russell W. Allen

17679

DATE SYSTEM APPROVED

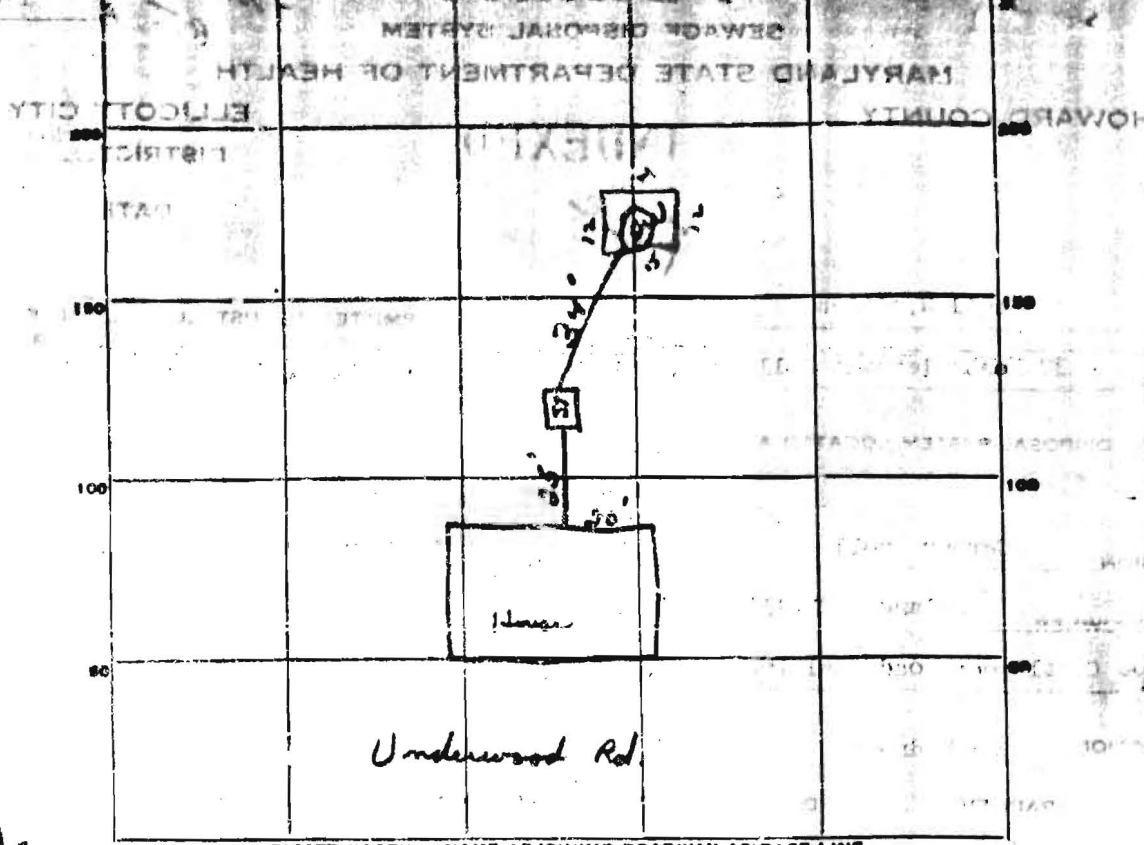

Sept 15/57

PERMIT CARD

SEPTIC TANK, LEVEL OK CLEANOUTS OK

DISTRIBUTION BOX, LEVEL _____

TILE FIELD, DEPTH _____ FT. TRENCH WIDTH _____ FT.

GRAVEL DEPTH _____ IN. TOTAL LENGTH _____ FT.

NUMBER OF TRENCHES _____ TOTAL BOTTOM AREA _____

SEEPAGE PITS, INSIDE DIAMETER 15 1/4 FT. DEPTH BELOW INLET 9 FT.

ABSORBENT AREA 477 SQ. FT.

REMARKS _____

APPROVED 3/20/57 INSPECTOR R. Turner