

APPLICATION

SEWAGE DISPOSAL TESTING

MARYLAND STATE DEPARTMENT OF HEALTH

HOWARD COUNTY

ELLICOTT CITY

DISTRICT 5th

DATE 12/21/72

*Recorded
2-12' hole
50 ft. apart
12/1/72
1067m*

TO: THE COUNTY HEALTH OFFICER
ELLICOTT CITY, MARYLAND

I, HEREBY, APPLY FOR THE NECESSARY TESTS IN ORDER TO CONSTRUCT OR RECONSTRUCT A SEWAGE DISPOSAL SYSTEM.

PROPERTY OWNER Francis & Jeanne Dickson

ADDRESS 7

Any questions call Mrs. Link,
Stepley Walters,
462-0900

PROPERTY LOCATION:

SUBDIVISION "Garber Knoll"

LOT NO. 2

ROAD AND DESCRIPTION Underwood Road approx 1 1/2 miles in off Rt. 97

approx 1/4 mi. past the sign

OCCUPANT _____ PHONE _____

PERSON TO CONSTRUCT SYSTEM _____

ADDRESS _____ PHONE _____

SIZE OF LOT 3 1/2 acres TYPE BLDG. 3 or 4 bedrooms
NUMBER OF BEDROOMS

IF NOT SINGLE RESIDENCE DESCRIBE _____

SIGNATURE OF APPLICANT /s/ Roland Barth


APPROVED BY _____ FOR _____ DATE _____
(KIND OF SYSTEM)

REJECTED BY _____ FOR _____ DATE _____
(KIND OF SYSTEM)

HOLD PENDING FURTHER TESTS _____ DATE _____

REASONS FOR REJECTION OR HOLDING _____

THIS IS NOT A PERMIT

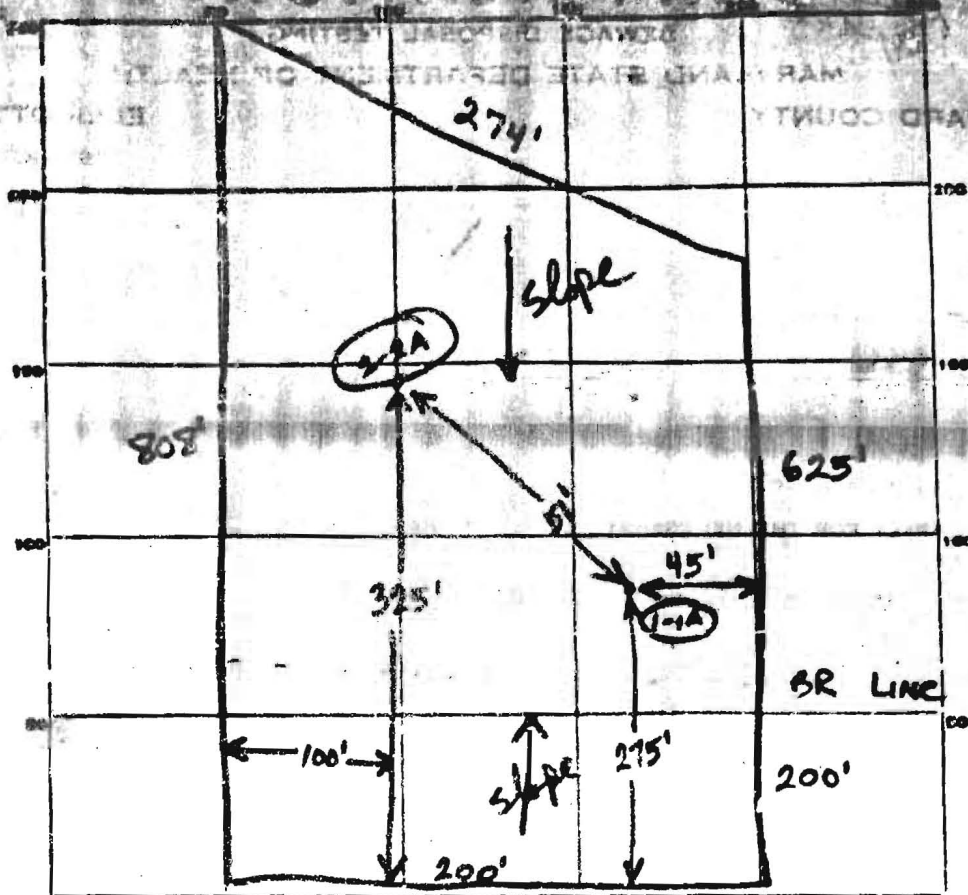

INDICATE NORTH - NAME ADJOINING ROADWAY AS BASE LINE.

Underwood Rd

| DATE | TEST NO. | DEPTH | PRE-WET | | TEST - 1" DROP | | TIME |
|------|----------|-------|---------|------|----------------|------|------|
| | | | START | STOP | START | STOP | |
| 12/1 | 1 | 7' | 215 | 220 | 220 | 228 | 8 |
| | 1A | 13' | 220 | 226 | 226 | 238 | 12 |
| | 2 | 6' | 140 | 142 | 142 | 150 | 8 |
| | 2A | 12' | 150 | 154 | 154 | 209 | 15 |
| | | | | | | | |
| | | | | | | | |
Av Time
11 min

SOIL AUGER FINDING

TESTED BY

REMARKS

HIS

Dry Well at **1-1A**
 Julet 6'
 Max Depth 13'