

12/9/65

Approved
12/8/65
R.F.

PERMIT

SEWAGE DISPOSAL SYSTEM

MARYLAND STATE DEPARTMENT OF HEALTH

HOWARD COUNTY

INDEXED

ELLICOTT CITY

DISTRICT 3

DATE 11/15/65

Hallinger Bros. IS PERMITTED TO INSTALL 5 ALTER

ADDRESS Wheaton, Maryland PHONE ET 8-4527

A SEWAGE DISPOSAL SYSTEM LOCATED AT _____

SUBDIVISION Three Park Estates ROAD Taylor Park Road LOT 25, Sec. 3

PROPERTY OWNER Debra Corp.

ADDRESS _____

SPECIFICATIONS 3 bedrooms

DRAIN FIELD _____ DEPTH _____ FEET, BOTTOM AREA _____ SQ. FT.

SEEPAGE PITS _____ ABSORBENT SIDE-WALL AREA _____ SQ. FT.

SEPTIC TANK CAPACITY 750 GALLONS

FOR GARBAGE GRINDER, INCREASE DISPOSAL AREA 25% & TANK CAPACITY 50%.


OTHER Dry well - 10 ft. in dia. by 11 ft. deep below the inlet located
45 ft. from the front property line and 118 ft. off the left side property line
as seen when facing the lot from Taylor Park Rd. Locate inlet at 3 ft.
below original grade.

PLANS APPROVED BY J. Haggard DATE 3/30/65

FILL SEPTIC TANK AND DISTRIBUTION BOX WITH WATER BEFORE CALLING FOR AN INSPECTION. COVER NO WORK UNTIL INSPECTED AND APPROVED.

NEITHER THE HOWARD COUNTY COMMISSIONERS NOR THE HEALTH DEPARTMENT IS RESPONSIBLE FOR THE SUCCESSFUL OPERATION OF ANY SYSTEM.

109713

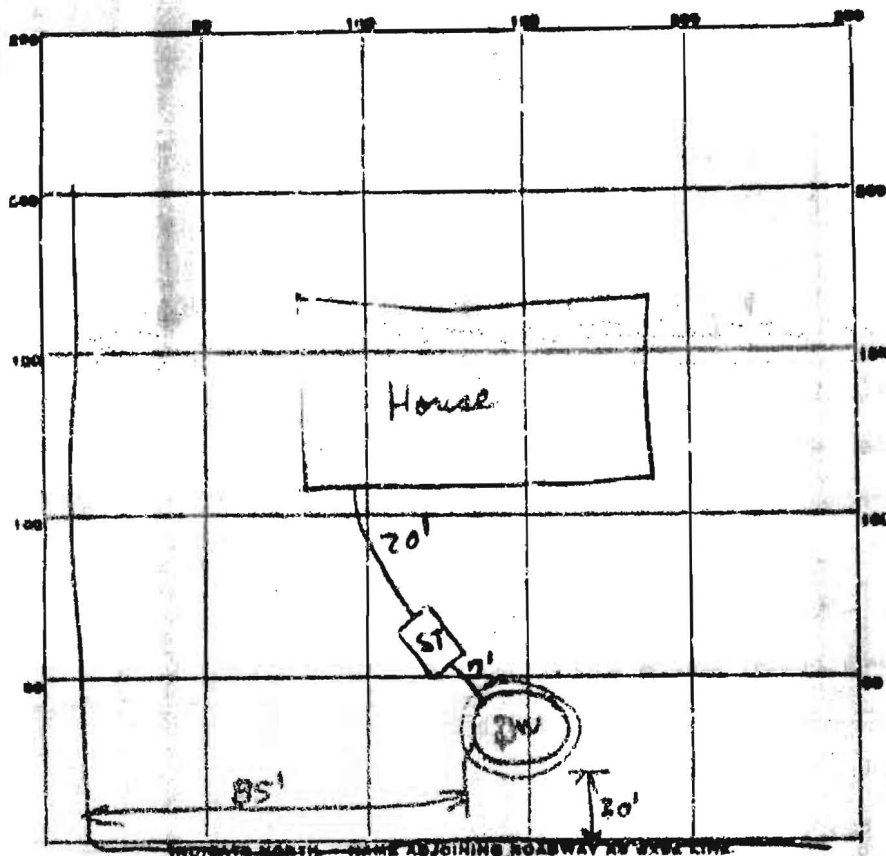

Taylor Pk. Rd.

PERMIT CARD OK

SEPTIC TANK, LEVEL OK

CLEANOUTS OK

DISTRIBUTION BOX, LEVEL _____

TILE FIELD, DEPTH _____ FT. TRENCH WIDTH _____ FT.

GRAVEL DEPTH _____ IN. TOTAL LENGTH _____ FT.

NUMBER OF TRENCHES _____ TOTAL BOTTOM AREA _____

SEEPAGE PITS, INSIDE DIAMETER 12 FT. DEPTH BELOW INLET 10 FT.

ABSORBENT AREA 376 SQ. FT.

REMARKS _____

DATE SYSTEM APPROVED

12/8/65

INSPECTOR

P. E. [Signature]

1:50 PM