

APPLICATION

SEWAGE DISPOSAL TESTING

MARYLAND STATE DEPARTMENT OF HEALTH

HOWARD COUNTY

ELLCOTT CITY

Septic Tank 750 gallons

DISTRICT 3

Dry well 10 ft. in dia. by 11 ft. deep below the inlet located 45 ft. from the front property line and 118 ft. off the left side property line as seen when facing the lot from Taylor Park Rd. Locate inlet at 3 ft. below original grade. DATE 3-30-65

TO: THE COUNTY HEALTH OFFICER
ELLCOTT CITY, MARYLAND

I, HEREBY, APPLY FOR THE NECESSARY TESTS IN ORDER TO CONSTRUCT (OR RECONSTRUCT) A SEWAGE DISPOSAL SYSTEM.

PROPERTY OWNER The Debra Corporation

ADDRESS 122 Dunlaggin Rd., Ellicott City, Md. PHONE HQ 5-2224

PROPERTY LOCATION

SUBDIVISION River Park Estates LOT NO. 25, Sec. 3

ROAD AND DESCRIPTION Taylor Park Road

OCCUPANT PHONE

PERSON TO CONSTRUCT SYSTEM

ADDRESS PHONE

SIZE OF LOT 44,020 sq. ft. TYPE BLDG. 3

IF NOT SINGLE RESIDENCE DESCRIBE

SIGNATURE OF APPLICANT /s/ R. W. Griffith


APPROVED BY J. Hanning FOR DATE 3-30-65

REJECTED BY FOR DATE

HOLD PENDING FURTHER TESTS DATE

REASONS FOR REJECTION OR HOLDING

THIS IS NOT A PERMIT

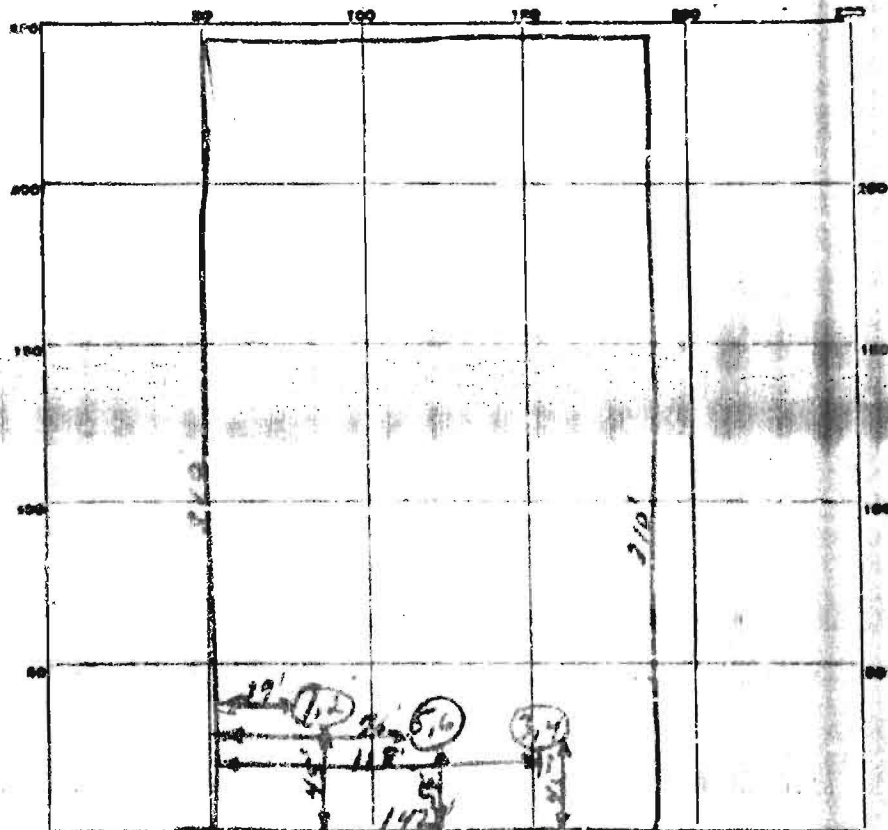

INDICATE NORTH - HAVE ADJOINING ROADWAY AS BASE LINE.

Taylor Park Road

DATE	TEST NO.	DEPTH	PRE-WET		TEST - 1" DROP		TIME
			START	STOP	START	STOP	
3-30-65	1. Sand	9 1/2	11:42	11:49	11:49	12:05	67 min.
	2. Pot	5	11:43				
	3. Sand	9 1/2	11:45	11:49	11:49	12:05	67 min.
	4. Pot	5	11:46	11:48	11:48	11:52	4 min.
	5. Sand	8 1/2	12:00	12:30	12:30	12:40	10 min.
	6. Pot	5	12:21	12:25	12:25	12:35	10 min.

SOIL AUGER FINDING

TESTED BY *H.T.*

REMARKS

Good sand after top 4 ft.

ALSO PRESENT

Typical

LOT NO. *25 sec 3*