

APPLICATION

SEWAGE DISPOSAL TESTING

A 17536

P _____

MARYLAND STATE DEPARTMENT OF HEALTH

HOWARD COUNTY

ELLICOTT CITY

DISTRICT 4th

DATE 10/10/72

TO: THE COUNTY HEALTH OFFICER
ELLICOTT CITY, MARYLAND

I, HEREBY, APPLY FOR THE NECESSARY TESTS IN ORDER TO CONSTRUCT (OR RECONSTRUCT) A SEWAGE DISPOSAL SYSTEM.

PROPERTY OWNER Charles Smith

ADDRESS Triadelphia Road, Glenwood, Md.

Any questions call Mr. Weller,
PHONE 442-2102

PROPERTY LOCATION:

SUBDIVISION _____ LOT NO. _____

ROAD AND DESCRIPTION Triadelphia Road - 1/4 mile past Roxbury Road on left hand side
of road. Lot is marked.

OCCUPANT _____ PHONE _____

PERSON TO CONSTRUCT SYSTEM _____

ADDRESS _____ PHONE _____

SIZE OF LOT 5.000 acres TYPE BLDG. 3 or 4 bedrooms

IF NOT SINGLE RESIDENCE DESCRIBE _____

SIGNATURE OF APPLICANT R. Norman Miller


APPROVED BY C. Streat FOR 10/11/72 DATE 10/11/72

REJECTED BY _____ FOR _____ DATE _____

HOLD PENDING FURTHER TESTS _____ DATE _____

REASONS FOR REJECTION OR HOLDING _____

THIS IS NOT A PERMIT

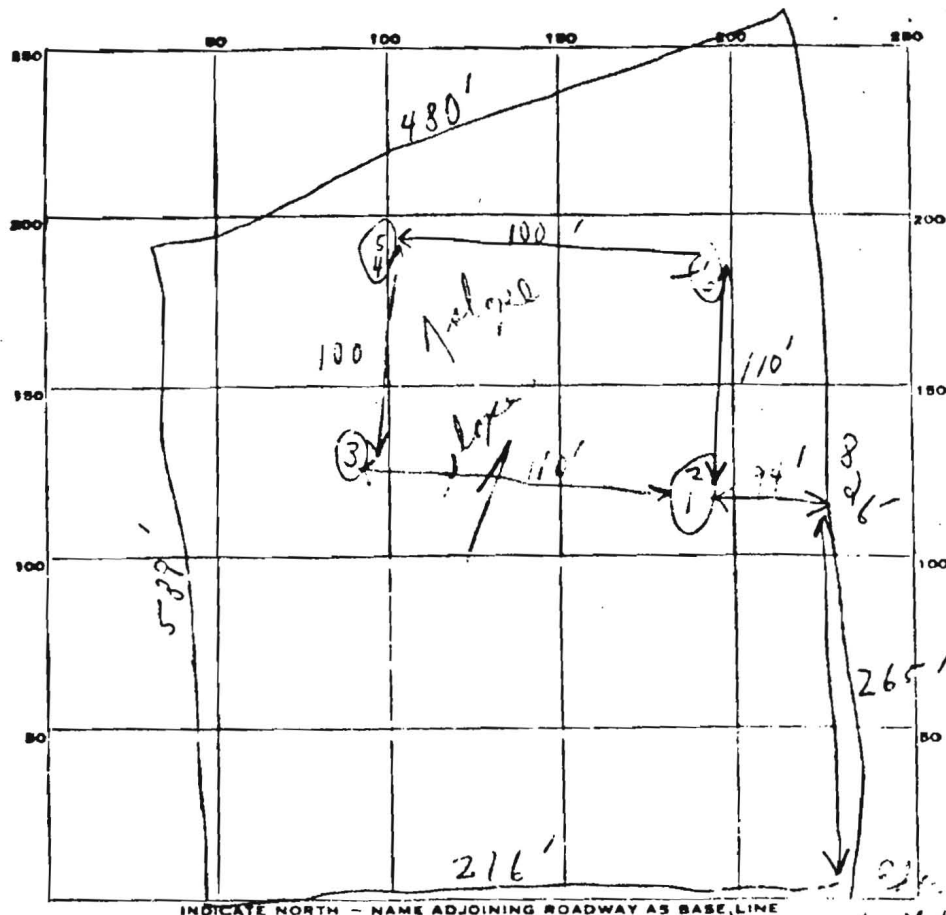

Travel this Road


Side of road
Lot 10 or more!

[illegible]

SOIL AUGER FINDING

TESTED BY

REMARKS

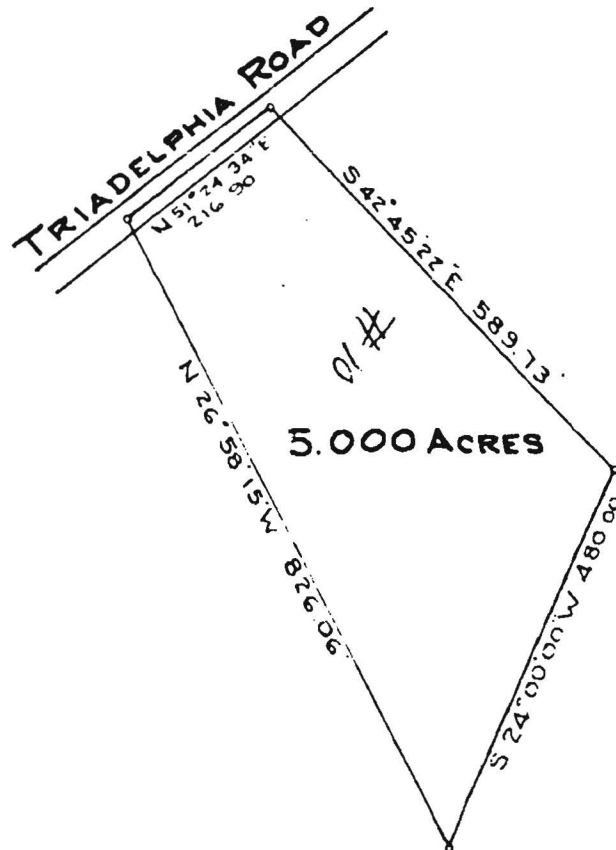

PLAT OF SURVEY
FOR
CHARLES SMITH
FIFTH ELECTION DISTRICT-HOWARD COUNTY
GLENWOOD, MARYLAND.

SCALE 1 in. = 200 FT SEPTEMBER 28, 1972

Claude M. Skinner, Jr.

Claude M Skinner, Jr.
Reg. Professional Engineer &
Land Surveyor No 2237



A 3450-10

OWNER - DAVID GRANT

BLINDER - PAUL C THOMPSON & SONS, INC.

190.928

TRIADELPHIA ROAD

216.90'

150'

WATER WELL
EXIST. ELEV 100'

150'

F.P. 104'
BASE 96'

PORCH

TANK

DRY WELL

INV. ELEV. 94.5'

INV. ELEV. 94'

EXIST. ELEV. 95.8'

INV. ELEV. 92'

EXIST. ELEV. 96'

ELEV. AT TIME OF PERCOLATION TEST 95'

95'