

PUB. SEWER STATUS VERIFIED BY \_\_\_\_\_

ISSUE DATE: 3/22/2004

P 520110

APPROVAL DATE: 3/29/04

A REPAIR

**PERMIT**

**INDEXED**

→ Cell # (301) 370-0653  
Doug -  
McKeever  
of Woodmac

**ON-SITE SEWAGE DISPOSAL SYSTEM  
HOWARD COUNTY HEALTH DEPARTMENT  
BUREAU OF ENVIRONMENTAL HEALTH**

To Be Installer

04-331249

Michael Musgrove

IS PERMITTED TO INSTALL ☐ ALTER ☒

ADDRESS: 15887 Union Chapel Road

PHONE NUMBER: 240-228-6442

SUBDIVISION: Daisy Hill Estates

LOT NUMBER: Parcel P

ADDRESS: 15887 UNION CHAPEL ROAD  
Same as above

PROPERTY OWNER: Michael Musgrove

SEPTIC TANK CAPACITY (GALLONS): \_\_\_\_\_

PUMP CHAMBER CAPACITY (GALLONS): \_\_\_\_\_

NUMBER OF BEDROOMS: 3

SQUARE FEET PER BEDROOM: 210

LINEAR FEET OF TRENCH REQUIRED: 130

+ 60' } 130' of Trench  
+ 70' }

2' Wide

Stone From 5'-9'

Will Fit in Area

TRENCHES:	Trench to be _____ feet wide. Inlet _____ feet below original grade. Bottom maximum depth _____ feet below original grade. Effective area begins at _____ feet below original grade. _____ feet of stone below distribution pipe.
LOCATION:	
PURPOSE:	Existing septic system has failed. Call for inspection when ground is opened so sanitarian can recommend repair.

PLANS APPROVED: \_\_\_\_\_

DATE: \_\_\_\_\_

NOTE: PERMIT VOID AFTER 2 YEARS

NOTE: CONTRACTOR RESPONSIBLE FOR SCHEDULING A PRE-CONSTRUCTION INSPECTION FOR ALL INSTALLATIONS

NOTE: WATERTIGHT SEPTIC TANKS REQUIRED

NOTE: ALL PARTS OF SEPTIC SYSTEM SHALL BE 100 FEET FROM ANY WATER WELL

NOTE: MANHOLE RISERS REQUIRED ON ALL SEPTIC TANKS AND PUMP CHAMBERS

**NEITHER THE HOWARD COUNTY COUNCIL OR THE HEALTH DEPARTMENT IS  
RESPONSIBLE FOR THE SUCCESSFUL OPERATION OF ANY SYSTEM**

**PERMITTEE RESPONSIBLE FOR OBTAINING FINAL APPROVAL ON THIS PERMIT**

**CALL 410-313-2640 FOR INSPECTION OF SEPTIC SYSTEM**


**BUILDING PERMIT SIGNED**

**AND RETURNED**

413-05-100152988-SIN Room

P520110

NOT TO SCALE

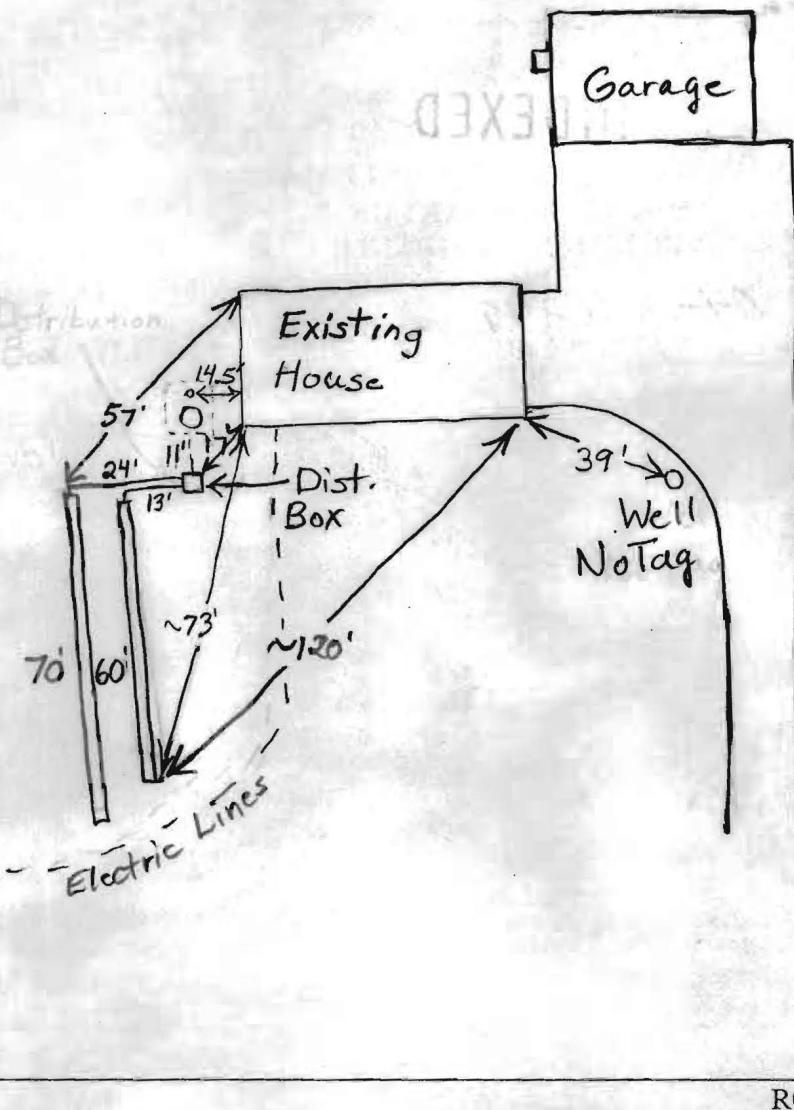

TRENCH/DRAINFIELD DATA		
WIDTH	INLET	BOTTOM
2	5	9
NUMBER OF TRENCHES		2
TOTAL LENGTH		130
ABSORPTION AREA		520 sq. ft.
DISTRIBUTION BOX LEVEL		
DISTRIBUTION BOX BAFFLE		
DISTRIBUTION BOX PORT		No

SEPTIC TANK DATA	
SEPTIC TANK 1 LEVEL	Existing
CAPACITY	_____ GAL
SEAM LOC	_____
TANK LID DEPTH	_____
BAFFLES	_____
BAFFLE FILTER	_____
MANHOLE LOC	_____
6" PORT LOC	_____
WATERTIGHT TEST	_____
SEPTIC TANK 2 LEVEL	N/A
CAPACITY	_____ GAL
SEAM LOC	_____
TANK LID DEPTH	_____
BAFFLES	_____
BAFFLE FILTER	_____
MANHOLE LOC	_____
6" PORT LOC	_____
WATERTIGHT TEST	_____

PRE-CONSTRUCTION 3/24/04 To install 2 trenches downhill of the existing trenches. Can fit 130' of trench and still avoid electric lines. Talked to installer (Doug McKeever) gave him O.K. to put system in during weekend. Leave trench ends open for inspection. (BB)

3/29/04 Trenches installed slightly off contour, probably to conserve area. Everything appears O.K. Alright to cover. (BB)

BUILDING PERMIT SIGNED  
AND RETURNED

FINAL INSPECTOR B. Baper DATE OF APPROVAL 3/29/04