

APPLICATION

SEWAGE DISPOSAL TESTING

MARYLAND STATE DEPARTMENT OF HEALTH

HOWARD COUNTY

ELLICOTT CITY

DISTRICT 4th

DATE 10/31/72

Preliminary

TO: THE COUNTY HEALTH OFFICER
ELLICOTT CITY, MARYLAND

I, HEREBY, APPLY FOR THE NECESSARY TESTS IN ORDER TO CONSTRUCT OR RECONSTRUCT A SEWAGE DISPOSAL SYSTEM.

PROPERTY OWNER Ann Siler

ADDRESS 1131 Univ. Blvd. W., Sill. Spg. Md.

PHONE 301-649-1500

PROPERTY LOCATION:

SUBDIVISION

LOT NO. Parcel 2

ROAD AND DESCRIPTION South Side of Univ. Chapel Rd., 400 ft. east of Daisy Road

OCCUPANT

PERSON TO CONSTRUCT SYSTEM Ann Siler

ADDRESS 81 2201 16th St NW 2001 00-01

SIZE OF LOT 56,388 sq. ft. TYPE BLDG 3

IF NOT SINGLE RESIDENCE DESCRIBE 2001 00-01

SIGNATURE OF APPLICANT

Ann Siler


APPROVED BY _____ FOR _____ DATE _____

REJECTED BY _____ FOR _____ DATE _____

HOLD PENDING FURTHER TESTS _____ DATE _____

REASONS FOR REJECTION OR HOLDING _____

THIS IS NOT A PERMIT

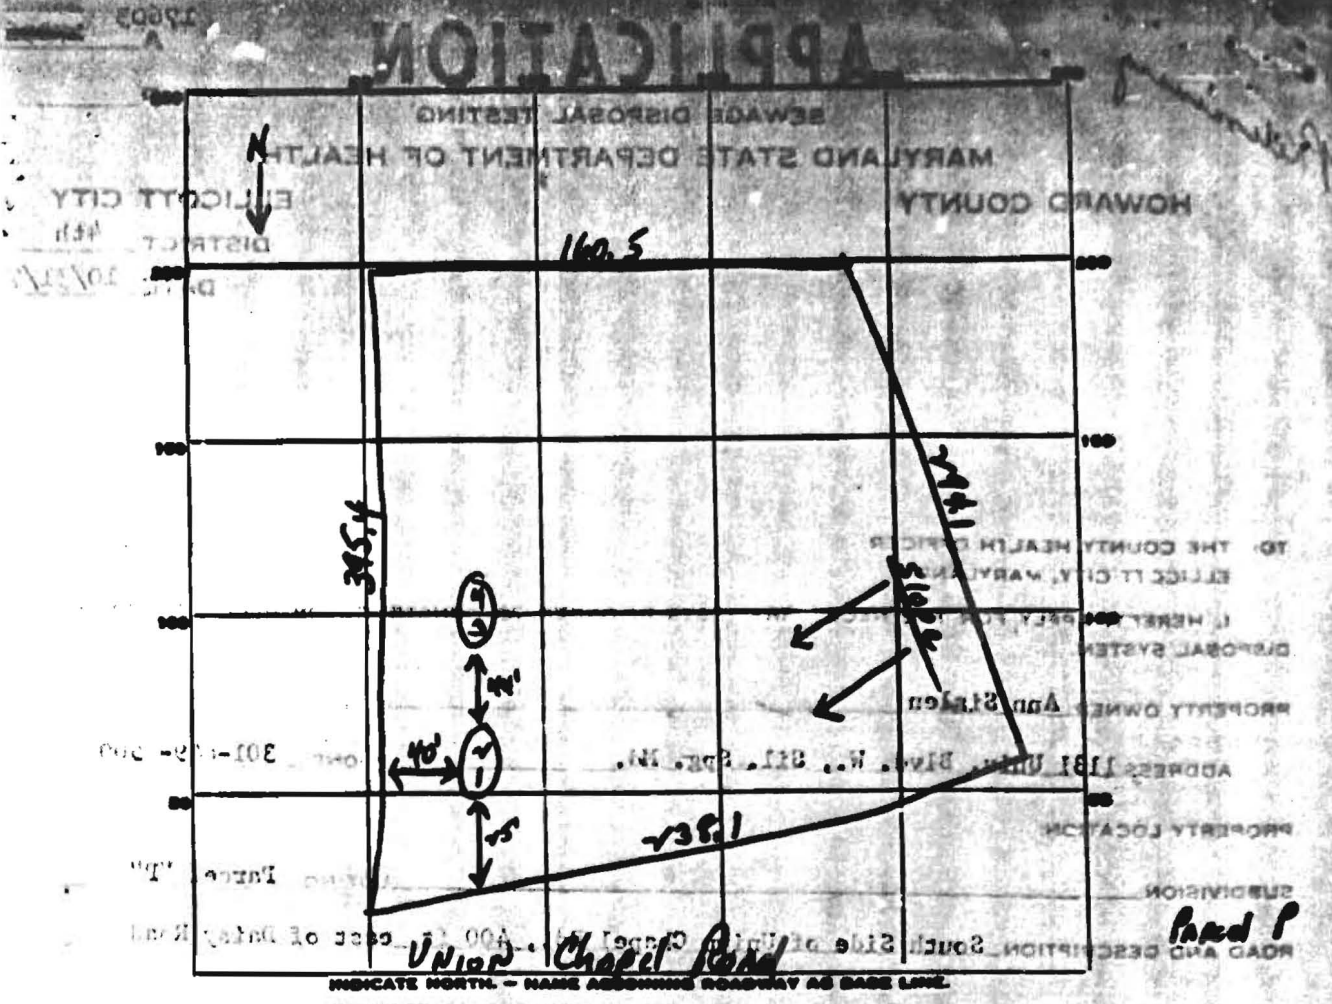

DATE	TEST NO.	DEPTH	PRE-WET		TEST - 1" DROP		TIME
			START	STOP	START	STOP	
	1	4 1/2'	10:01	10:08	10:08	10:17	9 min
	✓	10'	10:00	10:06	10:06	10:14	8 min
	3	5'	10:00	10:03	10:03	10:09	6 min
	Y	11'	10:00	10:06	10:06	10:16	10 min

SOIL AUGER FINDING _____

TESTED BY _____

REMARKS _____