


300/5215
SUN Room OK
ROAD
UNION CHAPEL
30.00'

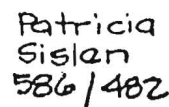


for the purpose of locating the improvements thereon, and the improvements are located as shown.

FISHER, COLLINS AND CARTER, INC.
CIVIL ENGINEERS AND LAND SURVEYORS
8388 COURT AVENUE
ELLCOTT CITY, MARYLAND 21043
(301) 461-2855

W.O.# 90383

This plac is not Intended for Use in
the establishm^{nt} of property lines.

PERSONAL LAND SURVY / 75

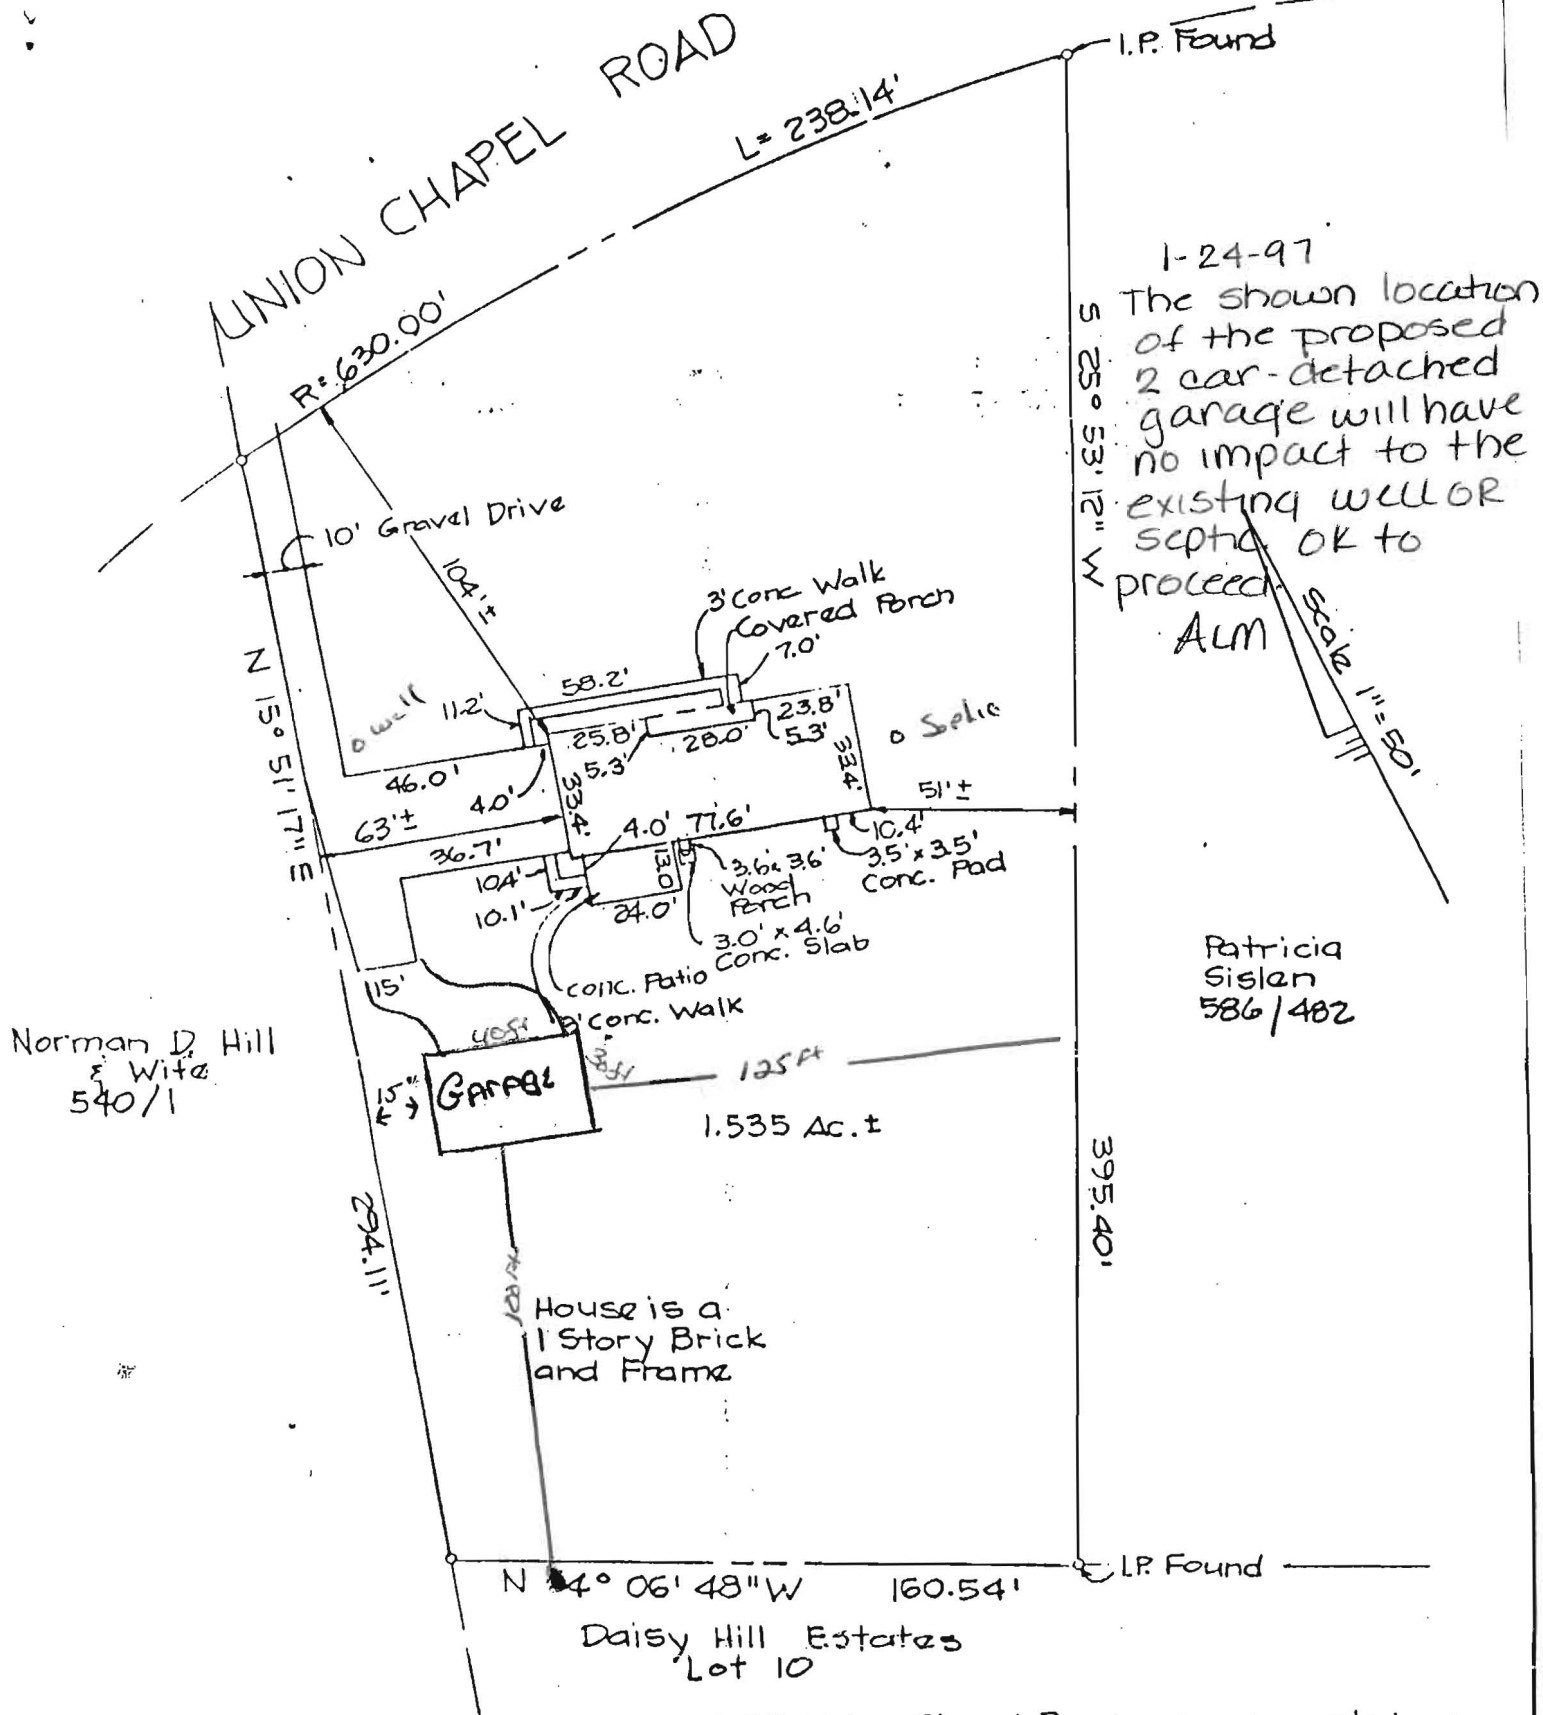


This is to certify that I have surveyed the property known as: 15887 Union Chapel Road as recorded among the Land Records of Howard County, Maryland in Liber 822 at Folio 426

for the purpose of locating the improvements thereon, and the improvements are located as shown.

Signed this 6th day of May 19 86

FISHER, COLLINS AND CARTER, INC.
CIVIL ENGINEERS AND LAND SURVEYORS
8388 COURT AVENUE
ELLCOTT CITY, MARYLAND 21043
(301) 461-2855

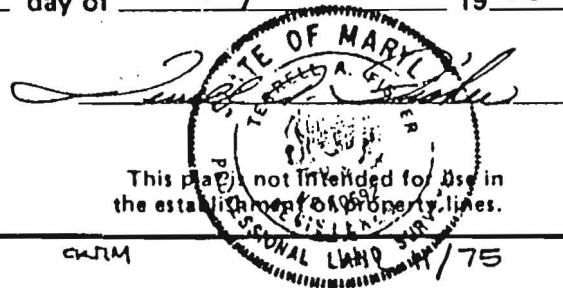

W.O. # 90383

ALM