

PUB. SEWER STATUS VERIFIED BY _____

ISSUE DATE: _____

APPROVAL DATE: _____

PERMIT

P _____

A 520335-A

ON-SITE SEWAGE DISPOSAL SYSTEM HOWARD COUNTY HEALTH DEPARTMENT BUREAU OF ENVIRONMENTAL HEALTH

IS PERMITTED TO INSTALL ☐ ALTER ☒

ADDRESS: _____ PHONE NUMBER: _____

SUBDIVISION: COLUMBIA HILLS LOT NUMBER: 17

ADDRESS: 9125 WINDING WAY PROPERTY OWNER: VIRGINIA
WHELLEY

SEPTIC TANK CAPACITY (GALLONS): _____

PUMP CHAMBER CAPACITY (GALLONS): _____

NUMBER OF BEDROOMS: _____

SQUARE FEET PER BEDROOM: _____

LINEAR FEET OF TRENCH REQUIRED: _____

TRENCHES:	Trench to be _____ feet wide. Inlet _____ feet below original grade. Bottom maximum depth _____ feet below original grade. Effective area begins at _____ feet below original grade. _____ feet of stone below distribution pipe.
LOCATION:	
PURPOSE:	Existing septic system has failed. Call for inspection when ground is opened so sanitarian can recommend repair.

PLANS APPROVED: _____ DATE: _____

NOTE: PERMIT VOID AFTER 2 YEARS

NOTE: CONTRACTOR RESPONSIBLE FOR SCHEDULING A PRE-CONSTRUCTION INSPECTION FOR ALL INSTALLATIONS

NOTE: WATERTIGHT SEPTIC TANKS REQUIRED

NOTE: ALL PARTS OF SEPTIC SYSTEM SHALL BE 100 FEET FROM ANY WATER WELL

NOTE: MANHOLE RISERS REQUIRED ON ALL SEPTIC TANKS AND PUMP CHAMBERS

**NEITHER THE HOWARD COUNTY COUNCIL OR THE HEALTH DEPARTMENT IS
RESPONSIBLE FOR THE SUCCESSFUL OPERATION OF ANY SYSTEM
PERMITTEE RESPONSIBLE FOR OBTAINING FINAL APPROVAL ON THIS PERMIT
CALL 410-313-2640 FOR INSPECTION OF SEPTIC SYSTEM**


**BUILDING PERMIT SIGNED
AND RETURNED**

4/29/04 B00147566 DECK

A520335-A


SITE INSPECTION SHEET

OWNER: Whelley PHONE #: _____
 ADDRESS: 9125 Winding Way CONTRACTOR: _____
Ellicott City WELL TAG #: ON Public Water
 SUBDIVISION: Columbia Hills LOT: _____ COUNTY #: _____
 PROPOSAL: BP001475660 - proposed DECK. NEED Site plan. Owner
Knows other prop. on septic & well. Will have those
addresses for us (nice of him) LOCATION DIAGRAM = S.T. pumped last
year - cannot find receipt.

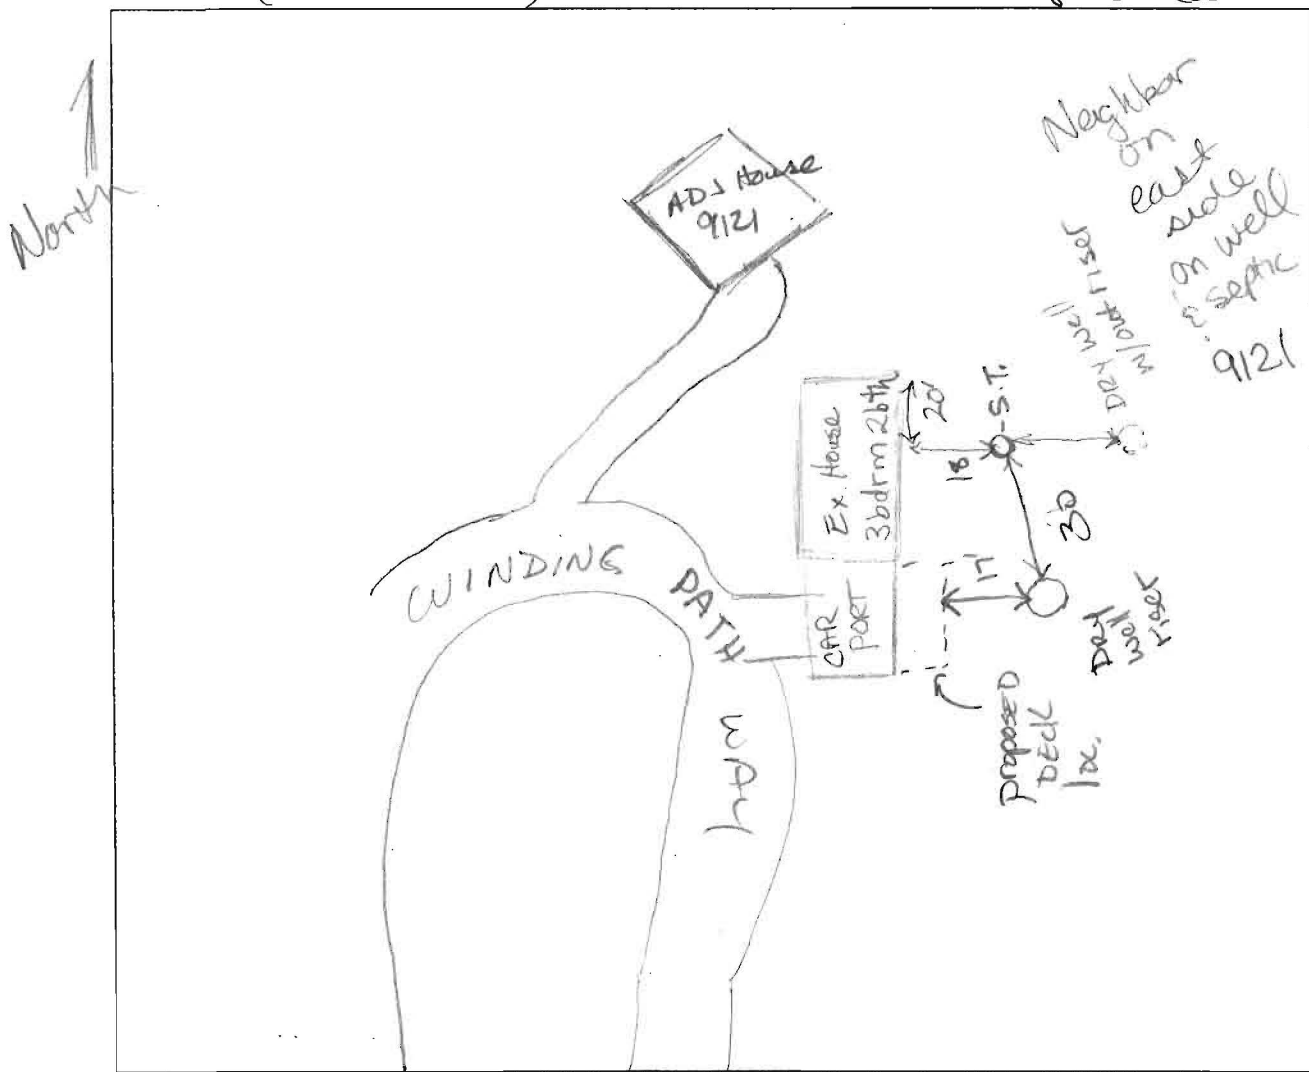

COMMENTS: 4/29/04 No basement service. Effluent level
OK. Pump out S.T. few years ago.

DATE: 4/29/04 INSPECTOR: Kane Noonan

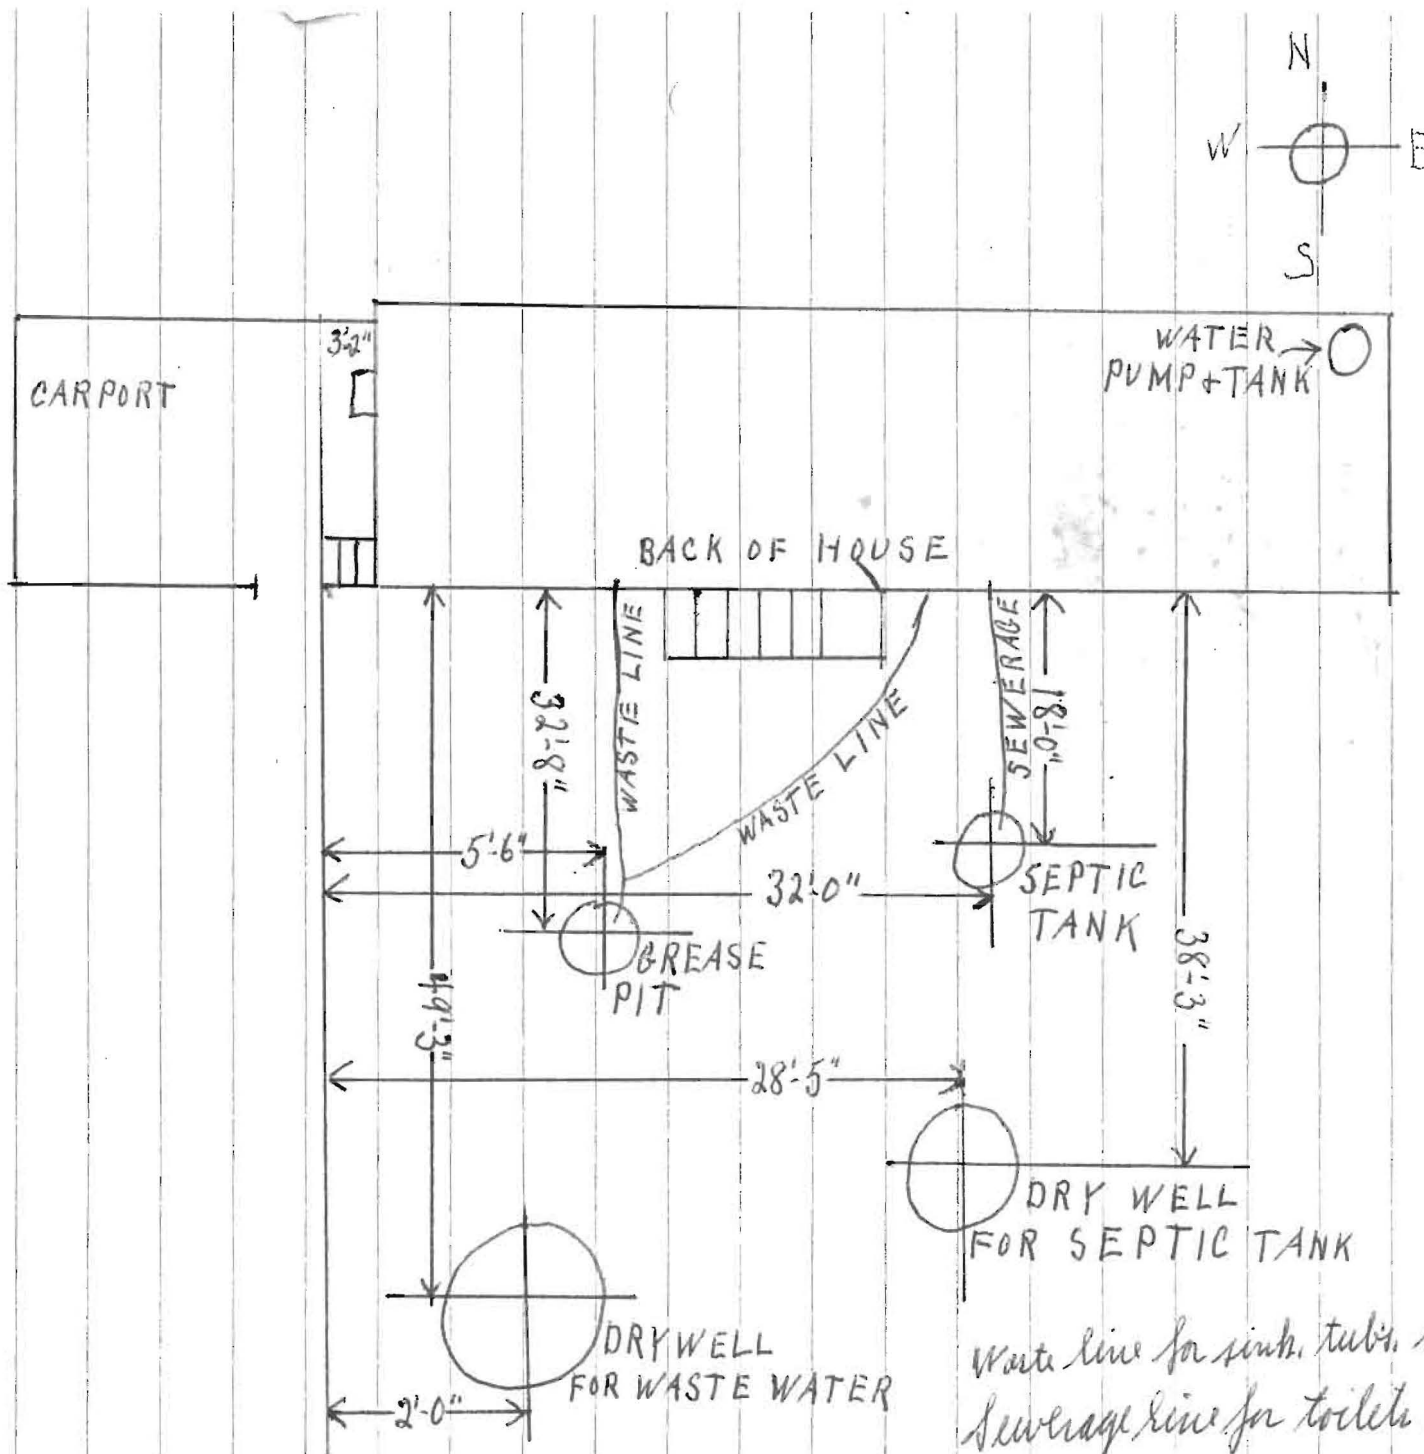

Waste line for sink, tub, shower + basin
Sewerage line for toilets only.