

SEPTIC SYSTEM TO BE
INSTALLED FIRST BEFORE
SEWAGE PERMIT IS
ISSUED.

PERMIT

P. 21384
A. 21384

MARYLAND STATE DEPARTMENT OF HEALTH

HOWARD COUNTY

ELLICOTT CITY

DISTRICT 3

DATE 11/3/76

INDEXED

Robert Jennings

IS PERMITTED TO INSTALL ☒ ALTER

ADDRESS Box 122, Harrover, Maryland 21076

PHONE 796-0090

A SEWAGE DISPOSAL SYSTEM LOCATED AT

SUBDIVISION (Residential Estates)

ROAD

13404
Triadelphia Road

LOT 23 A

PROPERTY OWNER Robert Jennings

A.C. HICKS (since 1986)

ADDRESS Same as above

SPECIFICATIONS 3 bedrooms

DRAIN FIELD DEPTH FEET, BOTTOM AREA SQ. FT.

SEEPAGE PITS ABSORBENT SIDE-WALL AREA SQ. FT.

SEPTIC TANK CAPACITY 1,000 GALLONS

SEWER PERMIT SECRET

AND RETURNED 7/15/77

Serial No. 32845

FOR GARAGE GRINDER, INCREASE DISPOSAL AREA 25% & TANK CAPACITY 50%.

OTHER Trench to have 180 sq. ft. effective sidewall absorption area per bedroom to begin

below the first 6 ft. of non-porous soil. Trench inlet at 5 ft. below original grade

and maximum depth permitted for trench is 12 ft. below original grade. Locate trench

120 ft. from the front lot line and 80 ft. from the right side line and proceed to dig

it on level ground toward the left side line as seen when facing the property from Tri-

adelphia Road. Call for inspection of trench before grinder is installed.

PLANS APPROVED BY Frank Skinner

DATE 1/23/76

NOTE: ALL PIPE FROM HOUSE TO DISPOSAL AREA MUST BE CAST IRON.


FILL SEPTIC TANK AND DISTRIBUTION BOX WITH WATER BEFORE CALLING FOR AN INSPECTION. COVER HO WORK
UNTIL INSPECTED AND APPROVED.

PERMIT VOID AFTER THREE YEARS.

NEITHER THE HOWARD COUNTY COMMISSIONERS NOR THE HEALTH DEPARTMENT IS RESPONSIBLE FOR THE
SUCCESSFUL OPERATION OF ANY SYSTEM.

NOTE: INSTALL STAND PIPE ON SEPTIC TANK. STAND PIPE MUST BE 4" IN DIA., CAST IRON
CONCRETE OR TERRA COTTA ACCEPTED.

21384

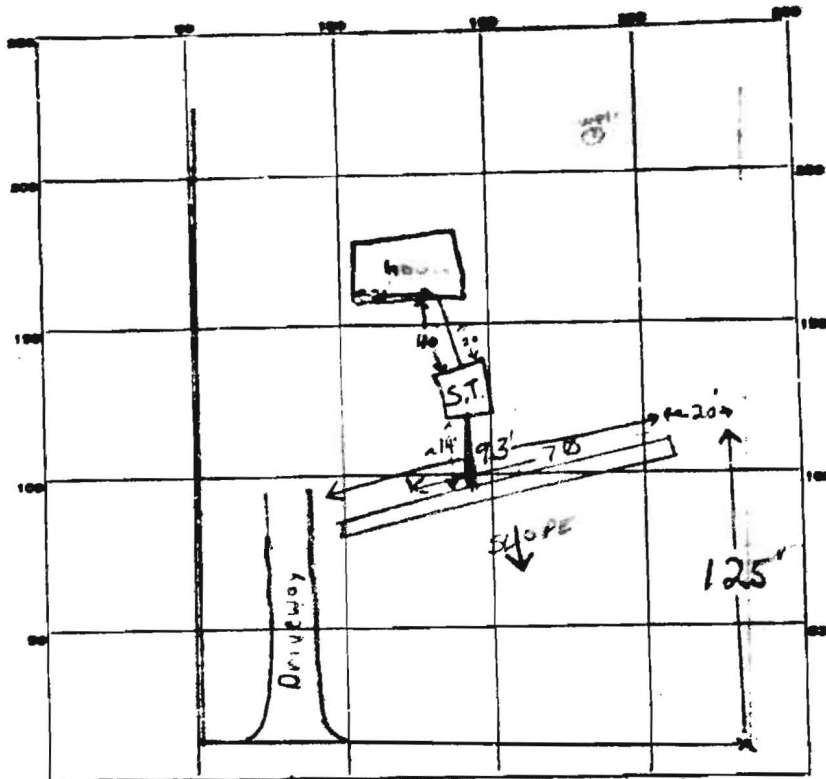

INDICATE NORTH - NAME ADJOINING ROADWAY AS BASE LINE.

Triadelphia Rd.

PERMIT CARD signed and sealed in S.

S.T. | trench

SEPTIC TANK, LEVEL ✓

CLEANOUT

O.K. | n.a.

DISTRIBUTION BOX, LEVEL n.a.

TILE FIELD, DEPTH 12 FT. TRENCH WIDTH 2 FT.

GRAVEL DEPTH 8 IN. TOTAL LENGTH 93 FT.

NUMBER OF TRENCHES 1 1/2 SIDEWALL 744

SEEPAGE PITS, INSIDE DIAMETER — FT. DEPTH BELOW GROUND — FT.

ABSORBENT AREA ±558 SQ. FT.

REMARKS 12/20/76 Trench dug in proper location but only 2 ft deep per F.S.

12/29/76 ~40 ft. of trench dug out to 11 ft. F.S.

12-29-76 - OK to place gravel in 1st 70' of trench - 1st 70' of trench dug to 12" HLB

12/30/76 O.K. to place gravel in trench saving 93' long 12' deep F.S.

12/30/76 gravel in trench to 5' in trench saving 5' F.S.

TRENCH OK INSTALL TANK 12/30/76 1/13/77

DATE SYSTEM APPROVED 8/8/77

INSPECTOR T. Shiner

8/1/77 Station pond, pipe and tank F.S.