


SITE INSPECTION SHEET

OWNER: Alonzo Hicks
 ADDRESS: 12904 Triadelphia Rd

DATE REQUESTED: 11/19/91
 DRILLER: Reichert
 WELL TAG # HO-PP-2003
 COUNTY # A 21384

PROPOSAL: Well has apparently collapsed around pump, but
H₂O is OK so far; owners want to drill rep. well to avoid
future problems

LOCATION DIAGRAM

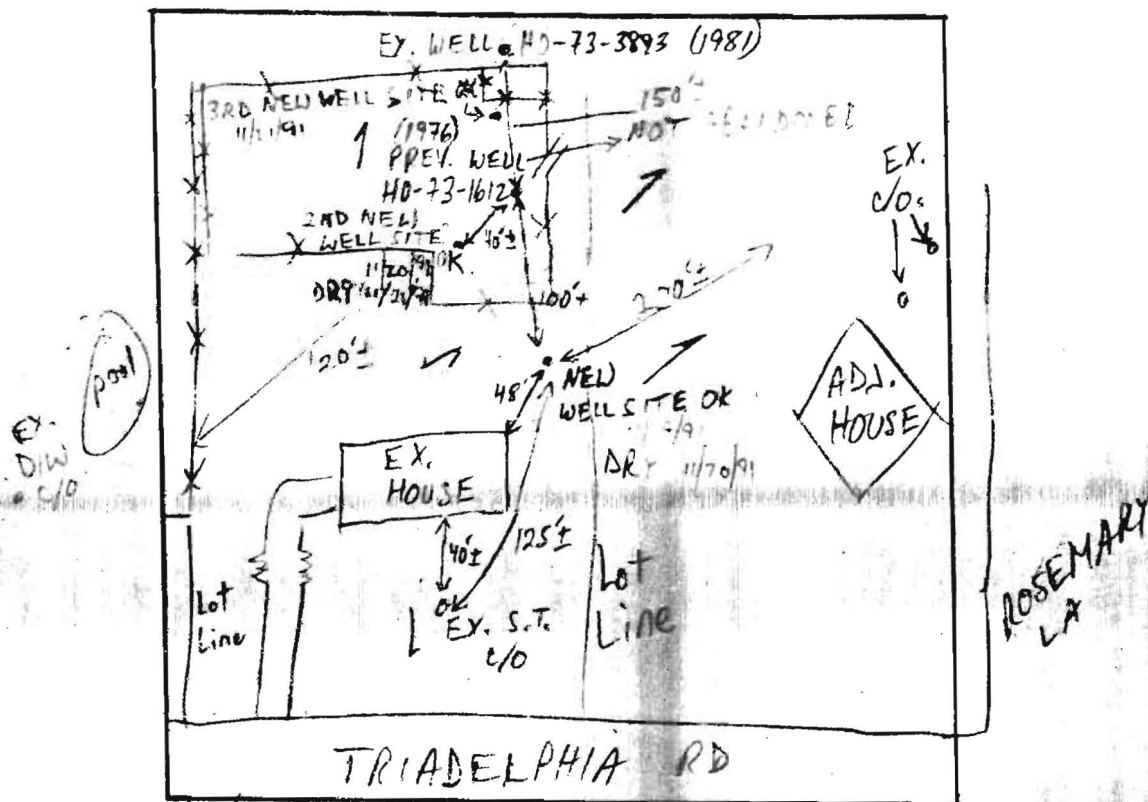

COMMENTS: 11/19/91 NEW SITE OK; OTHER WELLS TO BE
ABANDONED PER MRS. HICKS

DATE: 11/19/91 INSPECTOR: M. Riskin