

C1	4666	SEQUENCE NO. (IDENTIFY USE ONLY)	STATE OF MARYLAND WELL COMPLETION REPORT FILL IN THIS FORM COMPLETELY PLEASE PRINT OR TYPE	THIS REPORT MUST BE SUBMITTED WITHIN 45 DAYS AFTER WELL IS COMPLETED.
(THIS NUMBER IS TO BE PUNCHED IN COLS 3-6 ON ALL CARDS)				
ST/CO USE ONLY DATE RECEIVED	DATE WELL COMPLETED	Depth of Well (TO NEAREST FOOT)	PERMIT NO. FROM "PERMIT TO DRILL WELL"	
OWNER <u>H. P. ...</u>		TOWN <u>... 1384</u>		
STREET OFF RD <u>...</u>		SECTION <u>...</u> LOT <u>...</u>		
SUBDIVISION <u>ROSEMART ...</u>				

WELL LOG Not required for driven wells STATE THE KIND OF FORMATIONS PENETRATED, THEIR COLOR, DEPTH, THICKNESS AND IF WATER BEARING	GROUTING RECORD WELL HAS BEEN GROUTED (Circle Appropriate Box) TYPE OF GROUTING MATERIAL CEMENT C M BENTONITE CLAY B C NO. OF BAGS _____ NO. OF POUNDS _____ GALLONS OF WATER _____ DEPTH OF GROUT SEAL (to nearest foot) from _____ ft. to _____ ft. (enter 0 if from surface)																				
<table border="1" style="width:100%; border-collapse: collapse;"> <tr> <th style="font-size: x-small;">DESCRIPTION (Use additional sheets if needed)</th> <th style="font-size: x-small;">FEET FROM TO</th> <th style="font-size: x-small;">Check if water bearing</th> </tr> <tr> <td>#1 dry hole backfilled sealed</td> <td>0 500</td> <td></td> </tr> <tr> <td>#2 dry hole backfilled sealed</td> <td>0 300</td> <td></td> </tr> <tr> <td>#3 dry hole backfilled sealed</td> <td>0 300</td> <td></td> </tr> </table>	DESCRIPTION (Use additional sheets if needed)	FEET FROM TO	Check if water bearing	#1 dry hole backfilled sealed	0 500		#2 dry hole backfilled sealed	0 300		#3 dry hole backfilled sealed	0 300		CASING RECORD casing types insert appropriate code below								
DESCRIPTION (Use additional sheets if needed)	FEET FROM TO	Check if water bearing																			
#1 dry hole backfilled sealed	0 500																				
#2 dry hole backfilled sealed	0 300																				
#3 dry hole backfilled sealed	0 300																				
	<table border="1" style="width:100%; border-collapse: collapse;"> <tr> <td style="font-size: x-small;">MAIN CASING TYPE</td> <td style="font-size: x-small;">Nominal diameter top (main) casing (nearest inch)</td> <td style="font-size: x-small;">Total depth of main casing (nearest foot)</td> </tr> <tr> <td style="text-align: center;"> </td> <td style="text-align: center;"> </td> <td style="text-align: center;"> </td> </tr> </table>	MAIN CASING TYPE	Nominal diameter top (main) casing (nearest inch)	Total depth of main casing (nearest foot)																	
MAIN CASING TYPE	Nominal diameter top (main) casing (nearest inch)	Total depth of main casing (nearest foot)																			
	OTHER CASING (if used) diameter (nearest inch) depth (feet) from to <table border="1" style="width:100%; border-collapse: collapse;"> <tr> <td style="width: 30%; height: 20px;"></td> <td style="width: 30%; height: 20px;"></td> <td style="width: 30%; height: 20px;"></td> </tr> </table>																				
	SCREEN RECORD screen type or open hole insert appropriate code below																				
	<table border="1" style="width:100%; border-collapse: collapse;"> <tr> <td style="font-size: x-small;">ST STEEL</td> <td style="font-size: x-small;">BR BRASS</td> <td style="font-size: x-small;">HO OPEN HOLE</td> </tr> <tr> <td style="font-size: x-small;">PL PLASTIC</td> <td style="font-size: x-small;">OT OTHER</td> <td></td> </tr> </table>	ST STEEL	BR BRASS	HO OPEN HOLE	PL PLASTIC	OT OTHER															
ST STEEL	BR BRASS	HO OPEN HOLE																			
PL PLASTIC	OT OTHER																				
C2 DEPTH (nearest ft.) <table border="1" style="width:100%; border-collapse: collapse;"> <tr> <td style="width: 10%; text-align: center;">1</td> <td style="width: 10%; text-align: center;">2</td> <td style="width: 10%; text-align: center;">3</td> <td style="width: 10%; text-align: center;">4</td> <td style="width: 10%; text-align: center;">5</td> <td style="width: 10%; text-align: center;">6</td> <td style="width: 10%; text-align: center;">7</td> <td style="width: 10%; text-align: center;">8</td> <td style="width: 10%; text-align: center;">9</td> <td style="width: 10%; text-align: center;">10</td> </tr> <tr> <td style="text-align: center;">1</td> <td style="text-align: center;">2</td> <td style="text-align: center;">3</td> <td style="text-align: center;">4</td> <td style="text-align: center;">5</td> <td style="text-align: center;">6</td> <td style="text-align: center;">7</td> <td style="text-align: center;">8</td> <td style="text-align: center;">9</td> <td style="text-align: center;">10</td> </tr> </table>		1	2	3	4	5	6	7	8	9	10	1	2	3	4	5	6	7	8	9	10
1	2	3	4	5	6	7	8	9	10												
1	2	3	4	5	6	7	8	9	10												
LOCATION OF WELL ON LOT SHOW PERMANENT STRUCTURE SUCH AS BUILDING, SEPTIC TANKS, AND/OR LANDMARKS AND INDICATE NOT LESS THAN TWO DISTANCES (MEASUREMENTS TO WELL)																					

CIRCLE APPROPRIATE LETTER A A WELL WAS ABANDONED AND SEALED WHEN THIS WELL WAS COMPLETED E ELECTRIC LOG OBTAINED P TEST WELL CONVERTED TO PRODUCTION WELL I HEREBY CERTIFY THAT THIS WELL HAS BEEN CONSTRUCTED IN ACCORDANCE WITH COMAR 26.04.04 "WELL CONSTRUCTION" AND IN CONFORMANCE WITH ALL CONDITIONS SET FORTH IN THE ABOVE CAPTIONED PERMIT, AND THAT THE INFORMATION PRESENTED HEREIN IS ACCURATE AND COMPLETE TO THE BEST OF MY KNOWLEDGE.	GRUEL PACK IF WELL DRILLED WAS FLOWING WELL INSERT F IN BOX 08 USE ONLY (NOT TO BE FILLED IN BY DRILLER) T (E.R.O.S.) W.O. 70 72 74 75 76 TELESCOPE LOG OTHER DATA CASING INDICATOR
DRILLER'S IDENT. NO. <u>353</u>	
DRILLER'S SIGNATURE (MUST MATCH SIGNATURE ON APPLICATION)	
SITE SUPERVISOR (sign. of driller or journeyman responsible for sitework if different from permittee)	

H# 21007

MAP 22 4 1, 2001

REGION _____

AREA _____ RATING _____

ACKNOWLEDGMENT AND CONTROLS	DATE

Howard County Department of Health
BUREAU OF ENVIRONMENTAL HEALTH

RECORD OF INVESTIGATION

DISPOSITION	DATE

LOCATION 12904 Triad Rd. (Rosemary estate 23A)
 OWNER A.C. HICKS ADDRESS _____ PHONE 531-2614
 OCCUPANT A.C. HICKS ADDRESS _____ PHONE _____

COMPLAINANT Sams ADDRESS _____ PHONE _____

REASON FOR INVESTIGATION splitting drilled wells gone dry. Used a new well. Yesterday been out to site

CODES _____

RECEIVED BY B. Nigam DATE 2/18/87 ASSIGNED TO _____ DATE _____


DATE OF INVESTIGATION _____ TIME _____ WEATHER _____

REPORT Will place at least one (probably 2 stakes) to be approved

Existing well = 270' behind house

Septic (C/O's not visible) = 40' in front of house

Property owner: BERNSTEIN, BRANT
TRIAD RD.

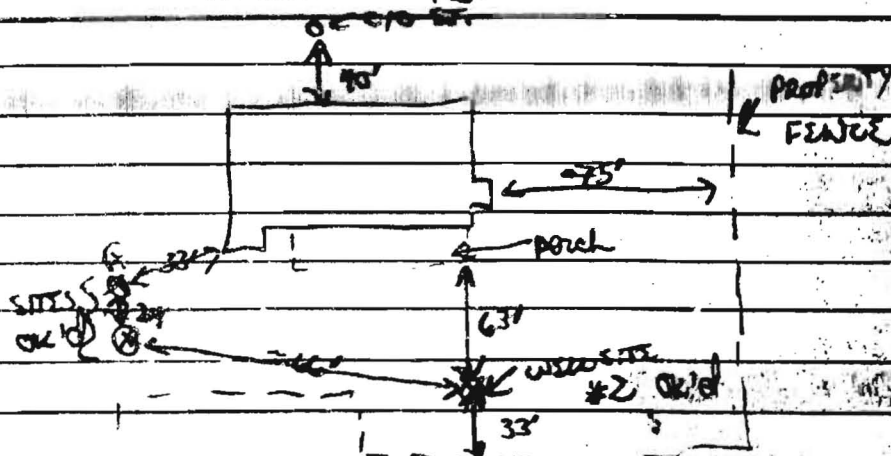

DATE SUBMITTED _____ SANITARIAN _____

HD-172

EXISTING WELL
NO 731612

4 100' TO 2ND WELL