


LOT 65

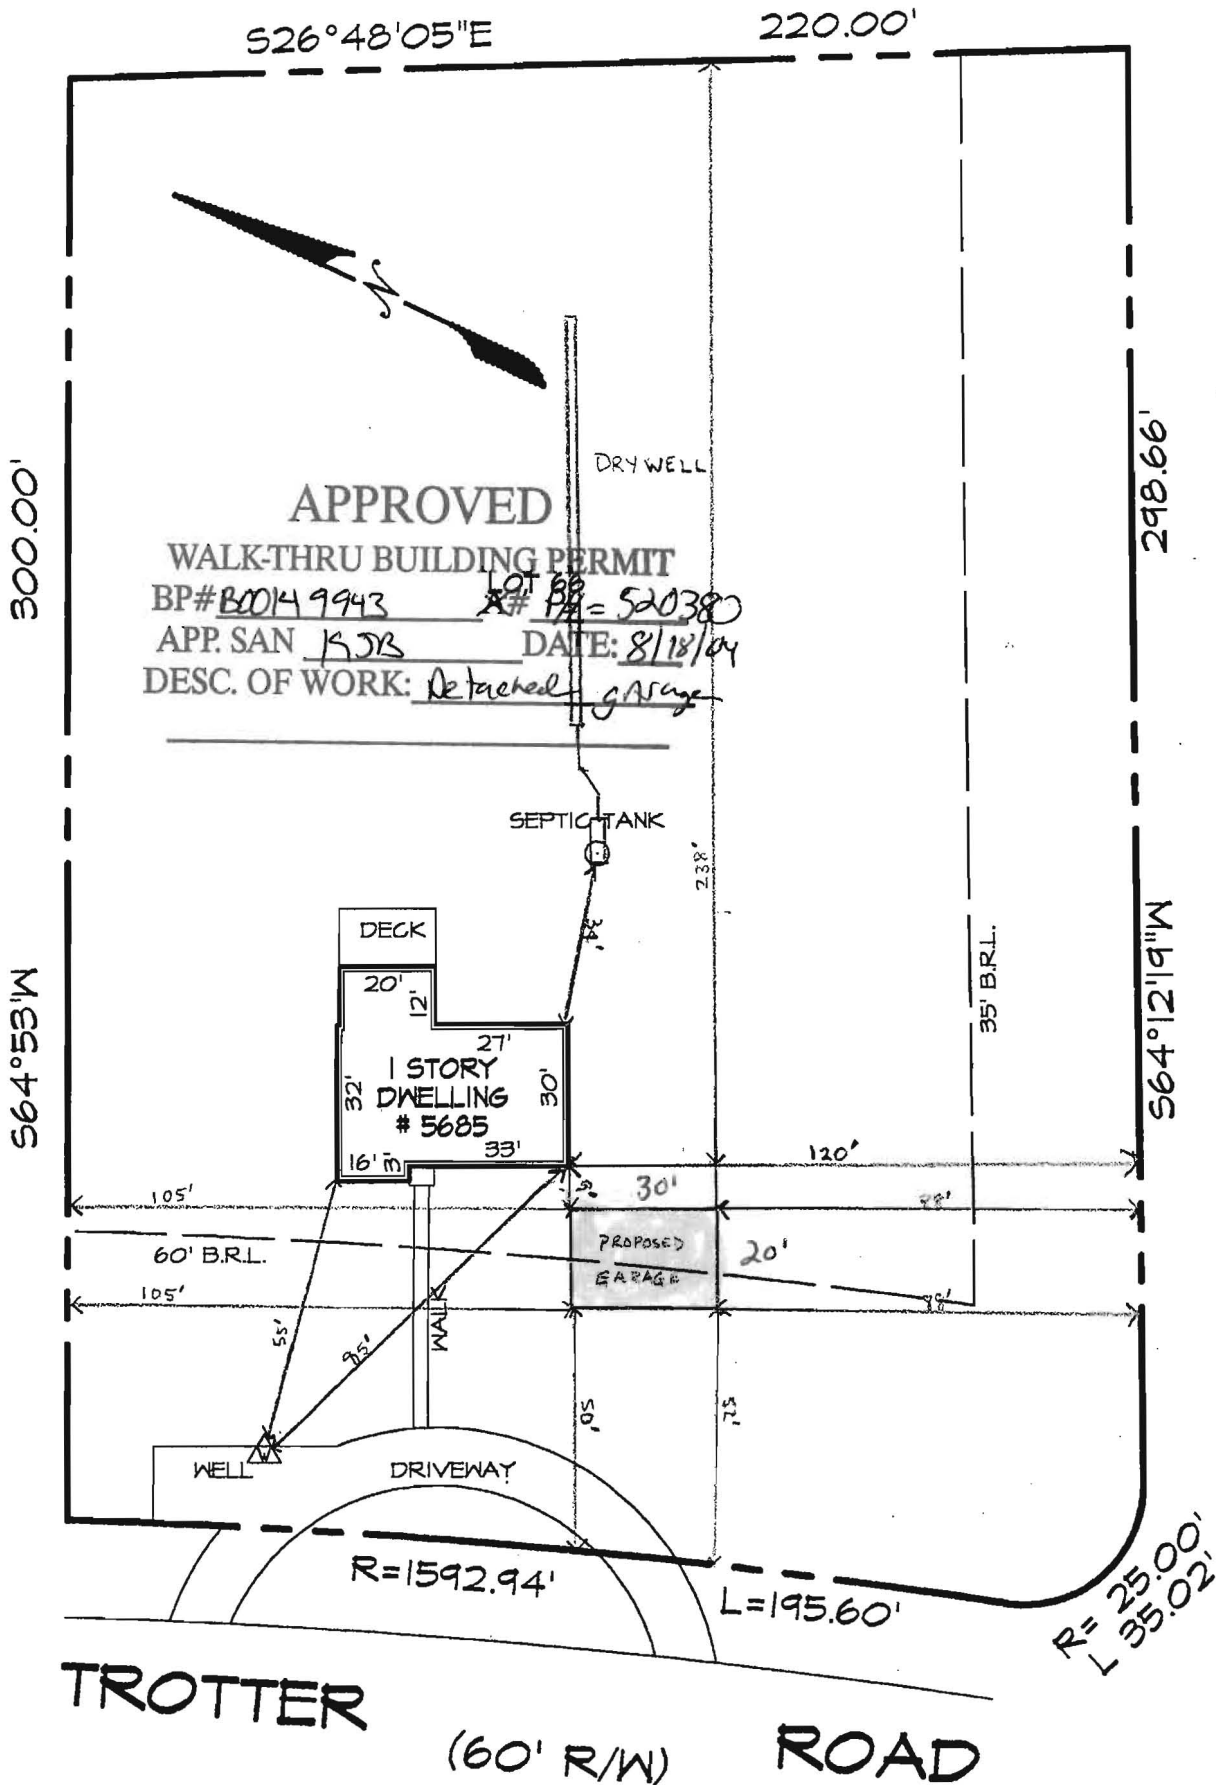

PAPER ROAD
 (50' R/W UNIMPROVED, SEE RECORD PLAT)

SURVEYORS CERTIFICATE

THIS LOCATION DRAWING HAS BEEN PREPARED IN ACCORDANCE WITH THE "MINIMUM STANDARDS OF PRACTICE FOR PROFESSIONAL SURVEYORS" AS ADOPTED BY THE STATE OF MARYLAND.

1. LOT 66, SECTION 2
 PLAT OF CRISWOOD MANOR
 PLAT LIBER 5, FOLIO 52