

11/29/72
11/29/72

PERMIT

17670 P520431-D

SEWAGE DISPOSAL SYSTEM

MARYLAND STATE DEPARTMENT OF HEALTH

HOWARD COUNTY

ELLICOTT CITY

DISTRICT 3rd

INDEXED

DATE 11/27/72

Jenkins Brothers

IS PERMITTED TO INSTALL ALTER X

ADDRESS Wallas Park, Ellicott City, Md.

PHONE 463-6646

A SEWAGE DISPOSAL SYSTEM LOCATED AT _____

SUBDIVISION _____

12704
Triadelphia Road
other side of Benson S/D - right side

PROPERTY OWNER Edward Frank III

ADDRESS Triadelphia Road, Ellicott City, Maryland

SPECIFICATIONS 1000 gallon tank

DRAIN FIELD _____ DEPTH _____ FEET, BOTTOM AREA _____ SQ. FT.

SEEPAGE PITS _____ ABSORBENT SIDE-WALL AREA _____ SQ. FT.

DEPTAIR SEPTIC TANK CAPACITY 1000 GALLONS

FOR GARBAGE GRINDER, INCREASE DISPOSAL AREA 22% & TANK CAPACITY 50%.

OTHER _____

PLANS APPROVED BY Donald W. Monaghan

DATE 11/27/72

FILL SEPTIC TANK AND DISTRIBUTION BOX WITH WATER BEFORE CALLING FOR AN INSPECTION. COVER NO WORK UNTIL INSPECTED AND APPROVED.


NEITHER THE HOWARD COUNTY COMMISSIONERS NOR THE HEALTH DEPARTMENT IS RESPONSIBLE FOR THE SUCCESSFUL OPERATION OF ANY SYSTEM.

BLDG. PERMIT SIGNED
AND RETURNED 12/19/72

Serial # 54737

1 Story Addition

17670

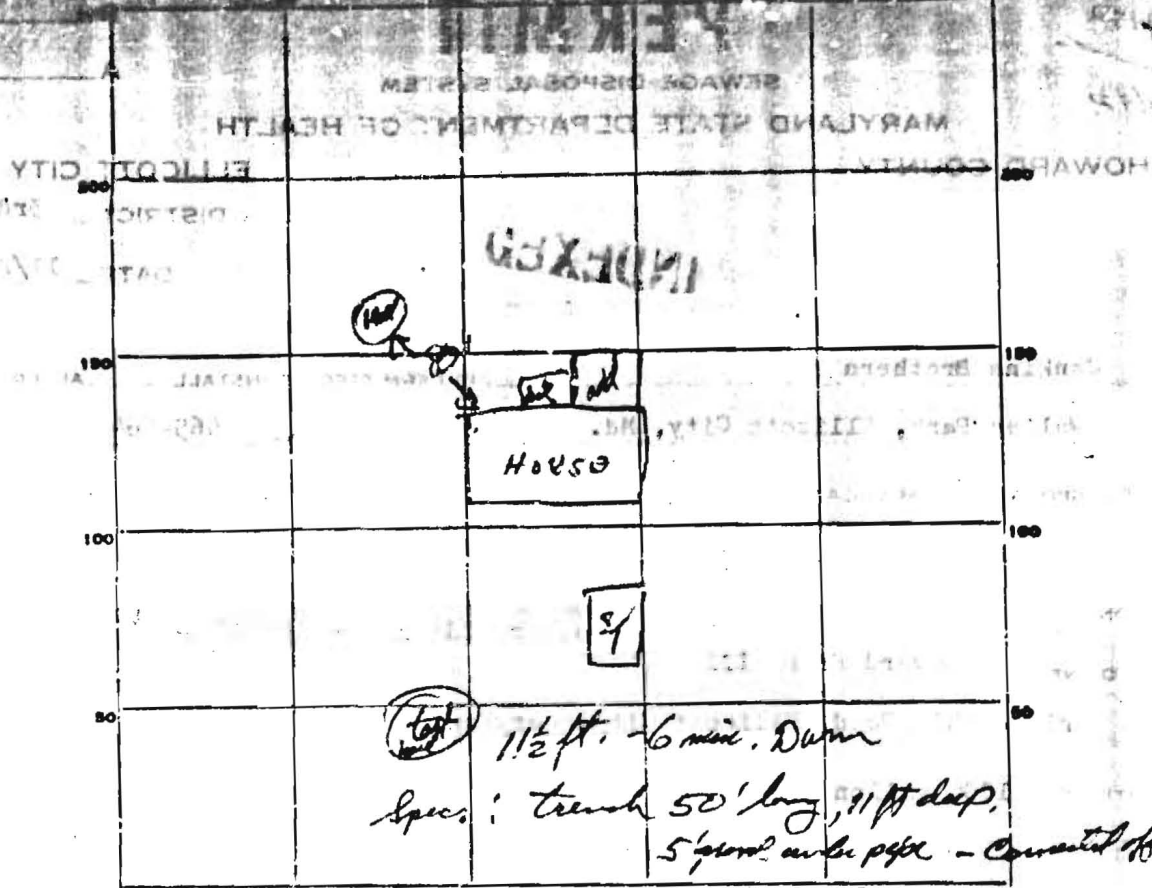

INDICATE NORTH. NAME ADJOINING ROADWAY AS BASE LINE.

PERMIT CARD _____

SEPTIC TANK, LEVEL _____ CLEANOUTS _____

DISTRIBUTION BOX, LEVEL _____

TILE FIELD, DEPTH _____ FT. TRENCH WIDTH _____ FT.

GRAVEL DEPTH _____ IN. TOTAL LENGTH _____ FT.

NUMBER OF TRENCHES _____ TOTAL BOTTOM AREA _____

SEEPAGE PITS, INSIDE DIAMETER _____ FT. DEPTH BELOW INLET _____ FT.

ABSORBENT AREA _____ SQ. FT.

REMARKS: 11/22/72. 1. Check connection of inlet & outlet pipes
 2. Check clean out pipe for tight fit
 3. Check inlet pipe to stop leaks
 4. Check outlet pipe to ensure proper slope.
 D.W.M.

DATE SYSTEM APPROVED: 11/22/72 INSPECTOR: Dr. Henry T.