

PUB. SEWER STATUS VERIFIED BY _____

ISSUE DATE: _____

P 520431-B

APPROVAL DATE: _____

A RE-INDEX

**PERMIT
INDEXED****ON-SITE SEWAGE DISPOSAL SYSTEM
HOWARD COUNTY HEALTH DEPARTMENT
BUREAU OF ENVIRONMENTAL HEALTH**IS PERMITTED TO INSTALL ☒ ALTER ☐

ADDRESS: _____ PHONE NUMBER: _____

SUBDIVISION: Daisy Hill Estates LOT NUMBER: Parcel FADDRESS: 15870 Union Chapel Road PROPERTY OWNER: _____

SEPTIC TANK CAPACITY (GALLONS): _____

PUMP CHAMBER CAPACITY (GALLONS): _____

NUMBER OF BEDROOMS: _____

SQUARE FEET PER BEDROOM: _____

LINEAR FEET OF TRENCH REQUIRED: _____

TRENCHES:	Trench to be _____ feet wide. Inlet _____ feet below original grade. Bottom maximum depth _____ feet below original grade. Effective area begins at _____ feet below original grade. _____ feet of stone below distribution pipe.
LOCATION:	
PURPOSE:	Reindex file 7/30/04

PLANS APPROVED: _____ DATE: _____

NOTE: PERMIT VOID AFTER 2 YEARS

NOTE: CONTRACTOR RESPONSIBLE FOR SCHEDULING A PRE-CONSTRUCTION INSPECTION FOR ALL INSTALLATIONS

NOTE: WATERTIGHT SEPTIC TANKS REQUIRED

NOTE: ALL PARTS OF SEPTIC SYSTEM SHALL BE 100 FEET FROM ANY WATER WELL

NOTE: MANHOLE RISERS REQUIRED ON ALL SEPTIC TANKS AND PUMP CHAMBERS

**NEITHER THE HOWARD COUNTY COUNCIL OR THE HEALTH DEPARTMENT IS
RESPONSIBLE FOR THE SUCCESSFUL OPERATION OF ANY SYSTEM
PERMITTEE RESPONSIBLE FOR OBTAINING FINAL APPROVAL ON THIS PERMIT
CALL 410-313-2640 FOR INSPECTION OF SEPTIC SYSTEM
BUILDING PERMIT SIGNED**

AND RETURNED

12/03 300145478 INDOOR PRIVATE RIDING ARENA

P520431-B

SITE INSPECTION SHEET

P520431-B

OWNER: McKil Residence PHONE #: _____


ADDRESS: 15870 Union Chapel Rd CONTRACTOR: _____

parcel 116 WELL TAG #: _____

SUBDIVISION: DAISY HILL^{EST} LOT: PARCEL F COUNTY #: A15943

PROPOSAL: BP00145478 - barn. Need to assess septic system usage / age & function.

LOCATION DIAGRAM

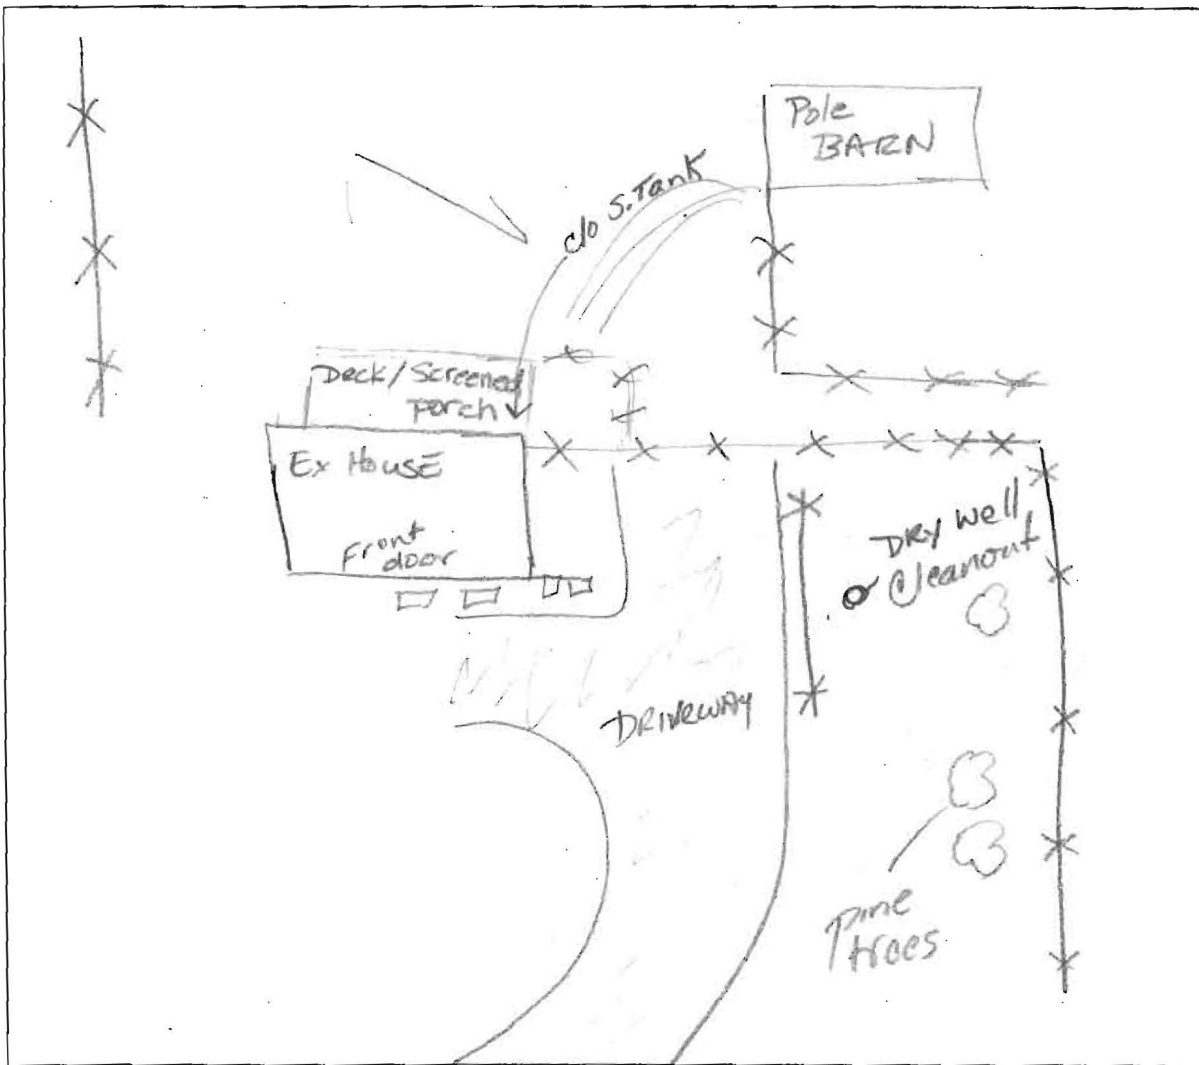

COMMENTS: SEPTIC TANK CLEANOUT UNDER TAIL DECK. Effluent level Approx 3 1/2' below grade. The dry well effluent level Approx 4' below grade. Previous specs require 4' inlet. Owner states house has 4 bedrooms. Repair + upgrade needed.

DATE: 12/24/03 INSPECTOR: Kacie Noonan

* NEED to Verify well tag # & location