

APPLICATION

SEWAGE DISPOSAL TESTING

MARYLAND STATE DEPARTMENT OF HEALTH

HOWARD COUNTY 1000 Gallon Tank

ELLICOTT CITY

DISTRICT

DATE

5/14/77

Dry Well 135 sq ft sidewalk area

Below the inlet with maximum depth
of 12 ft. made at time of perc test of 12 FT

To Locate the Dry Well 1st. Observe at the corner of the Right of
Way Measure along lot line which is 465 ft long 2 Measure
298 FT 3 Turn a right angle at that point
measure 187 ft. This is Dry Well

I, HEREBY, APPLY FOR THE NECESSARY TESTS IN ORDER TO CONSTRUCT OR RECONSTRUCT A SEWAGE
DISPOSAL SYSTEM.

J. Barton & Marlene H. Truesell

PROPERTY OWNER Daisy Hill, Joint Venture

8A Crescent Road, Greenbelt, Md. 20770

ADDRESS 1231 Univ. Blvd. N., Room 713, Silver Spg. Md. PHONE 669-1300

Home 474-7417

PROPERTY LOCATION:

Work 202-426-7734

SUBDIVISION Daisy Hill Estates

LOT NO. Parcel "F"

ROAD AND DESCRIPTION Union Chapel Road, 350' east of Daisy Road

OCCUPANT none

PHONE

PERSON TO CONSTRUCT SYSTEM

ADDRESS

PHONE

SIZE OF LOT 5.5007 acres

TYPE BLDG

Three

NUMBER OF BEDROOMS

IF NOT SINGLE RESIDENCE DESCRIBE

BLDG. PERMIT SIGNED

AND RETURNED

3/4/77

SIGNATURE OF APPLICANT

Daisy Hill, Joint Venture, By

Partner

APPROVED BY

FOR

(KIND OF SYSTEM)

DATE

5/12/77

REJECTED BY

FOR

(KIND OF SYSTEM)


DATE

HOLD PENDING FURTHER TESTS

DATE

REASONS FOR REJECTION OR HOLDING

THIS IS NOT A PERMIT

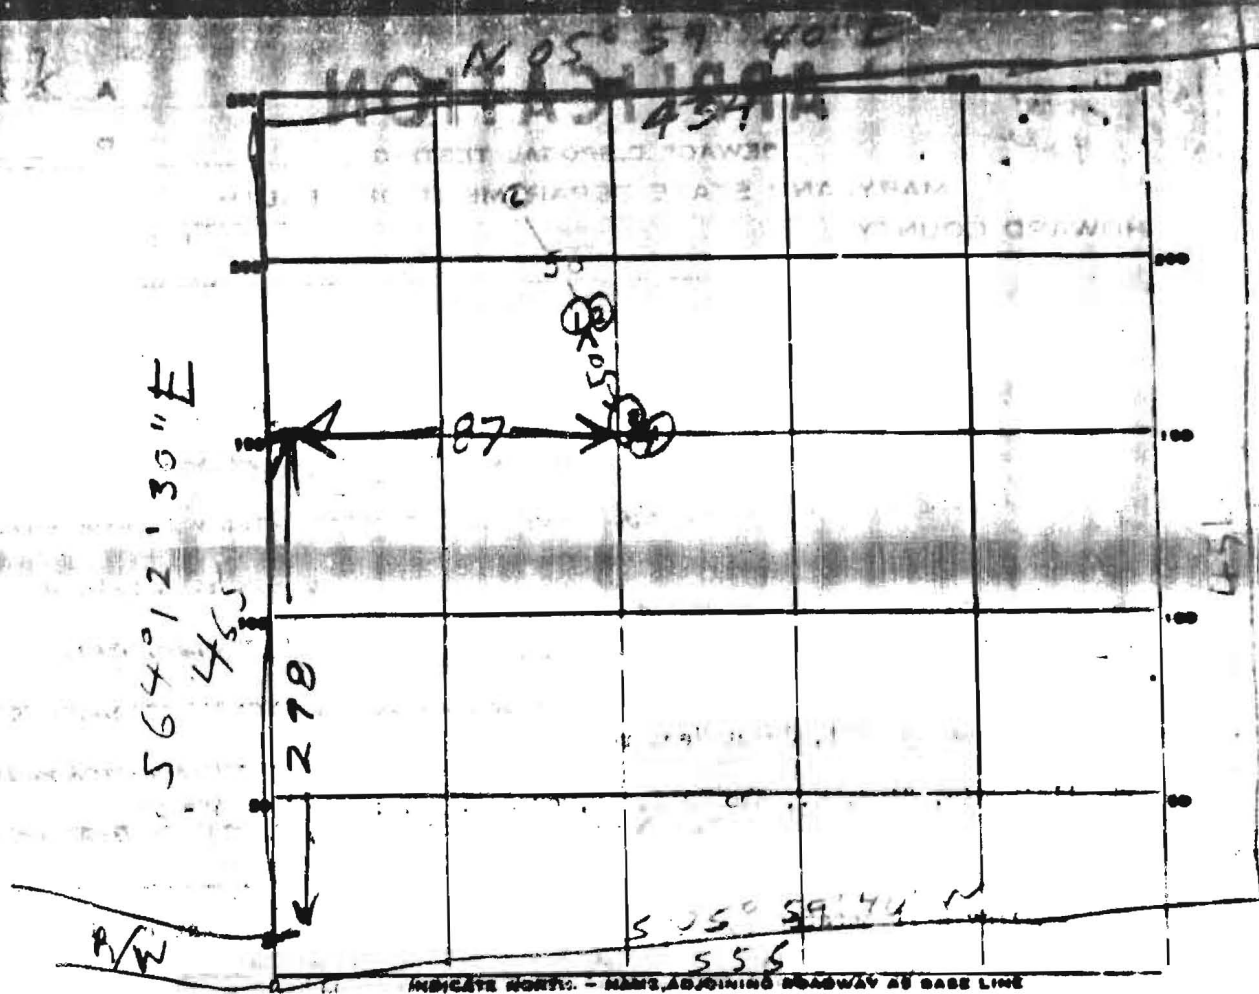

DATE	TEST NO.	DEPTH	PRE-WET		TEST - 1" DROP		TIME
			START	STOP	START	STOP	
2/2/71	1	10 1/2	957	12:11	1017	1029	1
1	2	4 1/2	959	12:12	1002	1010	3
	3	14 1/2	1000	1002	1002	1014	12
+	4	4 1/2	1001	1006	1006	1014	8
I	5	12	SAME PLACE AS (3) & (4)		SAND & ROCK		
3/1/71	1001	10'	Layer 1 to 4'		silty clay - hard		

SOIL AUGER FINDING

TESTED BY

REMARKS

A15943

Scale
1" = 100'

