




22098

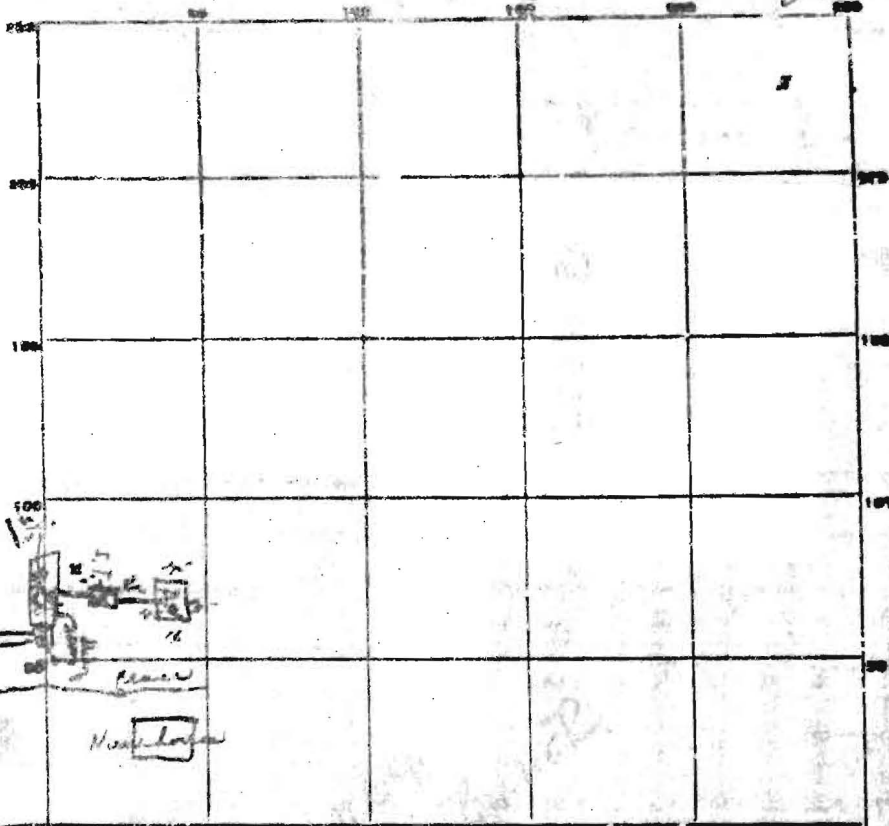

INDICATE NORTH - NAME ADJOINING ROADWAY AS BASE LINE.

PERMIT CARD Yes

S.T. OK D.W. OK

SEPTIC TANK LEVEL OK

CLEANOUTS OK OK

DISTRIBUTION BOX LEVEL N/A

Trench  
GRAVEL DEPTH 1 FT. TRENCH WIDTH 1 FT.

GRAVEL DEPTH 1 FT. TOTAL LENGTH 1 FT.

NUMBER OF TRENCHES 1 TOTAL BOTTOM AREA 1

SEEPAGE PITS, NUMBER 50 FT. DEPTH BELOW INLET 2.5-8 FT.

ABSORBENT AREA 435 SQ. FT.


50	51
906	2
2205	44
435	

REMARKS 2/28/78 checked and man all the way  
C.K.S.

CATL SYSTEM APPROVED 2/28/78 INSPECTOR C.K.S. [Signature]

22078

To  
C.B.

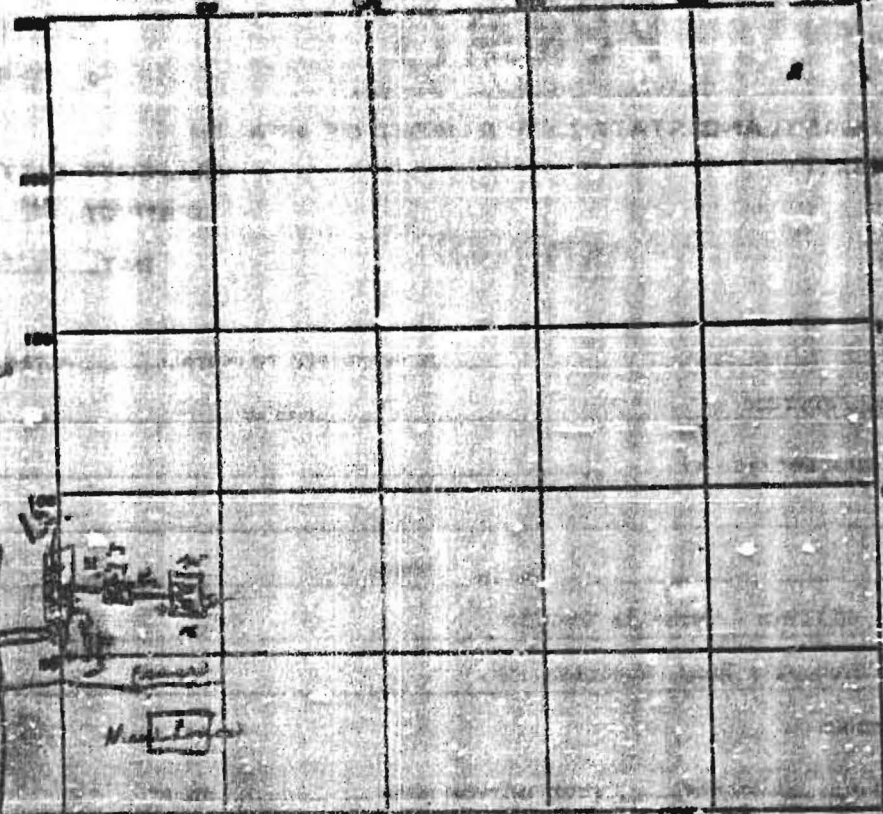

DESIGN TOTAL - NAME ADDRESS NUMBER OF BOX LINE.

POWER CORD Yes

WATER TANK LEVEL 1/2

CLEARANCE 5.1 P.W.  
OK OK

MIN. INSULATION BOX LEVEL N/A

TRAVERSE  
SLOPE DEPTH 1 FT. CROSS WIDTH 1 FT.

GRAVEL ANCHOR 1 FT. TYPICAL SPACING 1 FT.

NUMBER OF TRENCHES 1 TOTAL BOTTOM AREA 1

SEPARATE PITS, UNDESIRABLE 1 FT. DEPTH BELOW INLET 7.5 ft.

ABSORBENT AREA 425 sq. ft.

REMARKS 2/28/78 checked and OK all the way  
C.B.

DATE SYSTEM APPROVED 2/28/78 INSPECTOR C.B. Shank