

APPLICATION

A 21797

P _____

SEWAGE DISPOSAL TESTING

STATE OF MARYLAND · DEPARTMENT OF HEALTH AND MENTAL HYGIENE

HOWARD COUNTY HEALTH DEPARTMENT
ENVIRONMENTAL HEALTH SERVICES

P O BOX 476, ELLICOTT CITY, MARYLAND 21043
TELEPHONE 465-5000, EXT 356

DISTRICT 4

DATE 7/11/75

TO THE COUNTY HEALTH OFFICER
ELLICOTT CITY, MARYLAND

I, HEREBY, APPLY FOR THE NECESSARY TEST IN ORDER TO CONSTRUCT (OR RECONSTRUCT) A SEWAGE DISPOSAL SYSTEM.

PROPERTY OWNER John L. and Evelyn Keenan
C/O Chas. H. Steffey, Inc.
ADDRESS 9338 Baltimore Nat'l Pike PHONE 465-8500
Ellicott City, Md.

PROPERTY LOCATION

SUBDIVISION Rover Mill Estates - Addition LOT NO. 4

ROAD AND DESCRIPTION Rover Mill Rd. to Road A

SIZE OF LOT 3.0A. TYPE BLDG. 4 Bedroom
NUMBER OF BEDROOMS

IF NOT SINGLE RESIDENCE DESCRIBE _____

THE SYSTEM INSTALLED UNDER THIS APPLICATION IS ACCEPTABLE ONLY UNTIL PUBLIC FACILITIES BECOME AVAILABLE.

SIGNATURE OF APPLICANT John L. Keenan

APPROVED BY _____ FOR _____ DATE _____
(KIND OF SYSTEM)

REJECTED BY _____ FOR _____ DATE _____
(KIND OF SYSTEM)


HOLD PENDING FURTHER TESTS _____ DATE _____

REASONS FOR REJECTION OR HOLDING _____

THIS IS NOT A PERMIT

21797

TALL SHIPS DRIVE

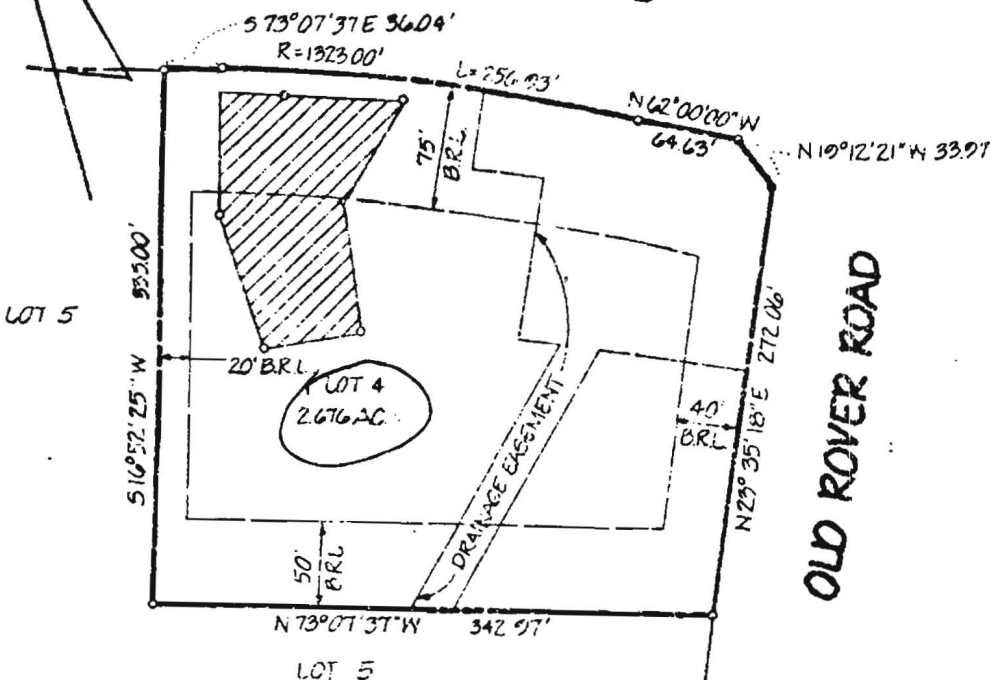

THIS AREA INDICATES A PRIVATE SEWAGE TREATMENT PLANT OF APPROXIMATELY 10,000 SQ. FT. A MARYLAND STATE DEPARTMENT OF HEALTH AND MENTAL HYGIENE INDIVIDUAL DISPOSAL IMPROVEMENTS OF ANY NATURE ARE RESTRICTED UNTIL PUBLIC SEWAGE IS AVAILABLE. ANY RESIDENTIAL STRUCTURES CONSTRUCTED ON THE SITES, THIS EASEMENT SHALL BECOME NULL AND VOID UPON CONNECTION TO A PUBLIC SEWAGE SYSTEM.

THE LOTS SHOWN HEREIN ARE THE MINIMUM OWNED AND LOT AREAS AS REQUIRED BY MARYLAND STATE DEPARTMENT OF HEALTH AND MENTAL HYGIENE.


APPROVED FOR PRIVATE SEWAGE SYSTEMS
HOWARD COUNTY HEALTH DEPARTMENT
Joan E. [Signature]
HEALTH OFFICER

PLAT REFERENCE: "ROVER MILLS ESTATES" - PLAT 3613

PERC CERTIFICATION PLAT	DATE: AUG. 1983	boender associates SUITE 102 107 TOWN & COUNTRY PROFESSIONAL BUILDING ELLICOTT CITY, MARYLAND 21043 201-496-7711
LOT 4 - ROVER MILL ESTATES	SCALE: 1" = 100'	
8TH ELECTION DISTRICT HOWARD COUNTY, MD	JOB NO.	

eng
for
plan

Lot 4

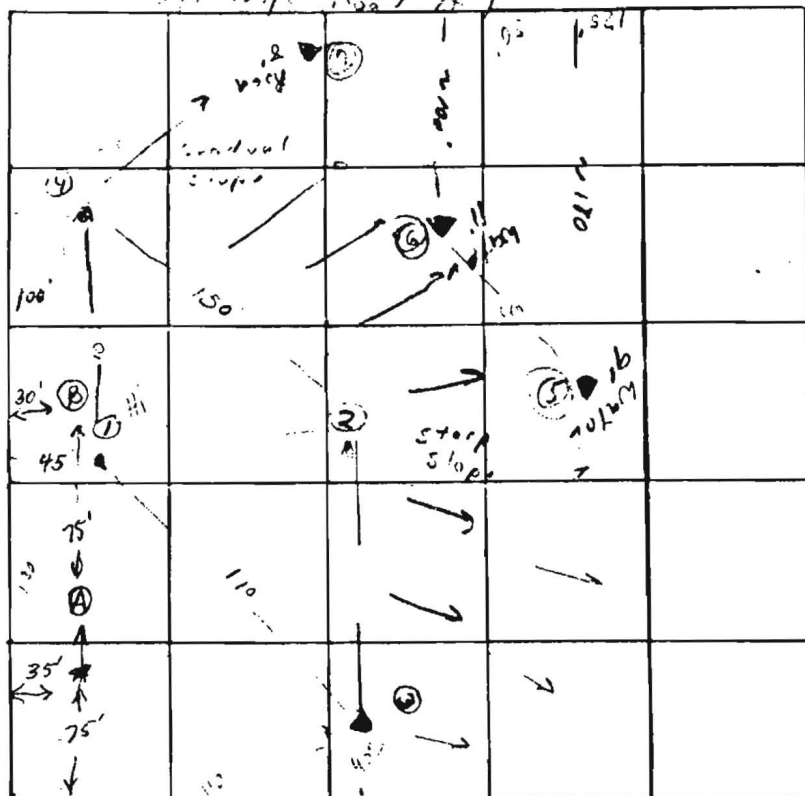

Lot 4
Rover Hill Est.
3 acres

4-9-84
AP# 68399
Tracy & Gene
NOBLE

INDICATE NORTH - NAME ADJOINING ROADWAY AS BASE LINE

(#14001 Tall Ships Dr.)

DATE	TEST NO	DEPTH	PRE-WET		TEST - 1" DROP		TIME
			START	STOP	START	STOP	
8-7-75	3	1'	1:25	1:30	1:45	1:50	1
	3	2'	1:35	1:40	1:50	1:55	1
	4	4'	2:05	2:10	2:20	2:25	1
	4	10 1/2'	2:55	3:01	3:01	1:10	9
		11'	3:05	3:10	3:10	3:15	1
		4'	3:15	3:20	3:20	3:25	1
	2	1'	3:25	3:30	3:30	3:35	1
	5	6' to 9'					
	6	4' to 11'		8-16-83	A-V -	12' both dry, no	
	7	5' to 8'			B-V -	12' inspection	

REMARKS

Cent. Ry. Holos. Elev d. 1 between 2+5 ~ 8'

TYPE OF SOIL

Silt loam 4- to 10' hole 3+4 hard at bottom

TESTED BY

ALSO PRESENT: