


Proposed Site Plan of the property known as #14001 Tall Ships Drive, 4TH Election District, Howard County, Maryland. Also known as Lot 4, as shown on the REVISED PLAT OF LOTS, 1 THROUGH 6, 27 AND 28, ROVER MILL ESTATES, which plat is recorded among the land records of Howard County as plat C.M.P. #4141.

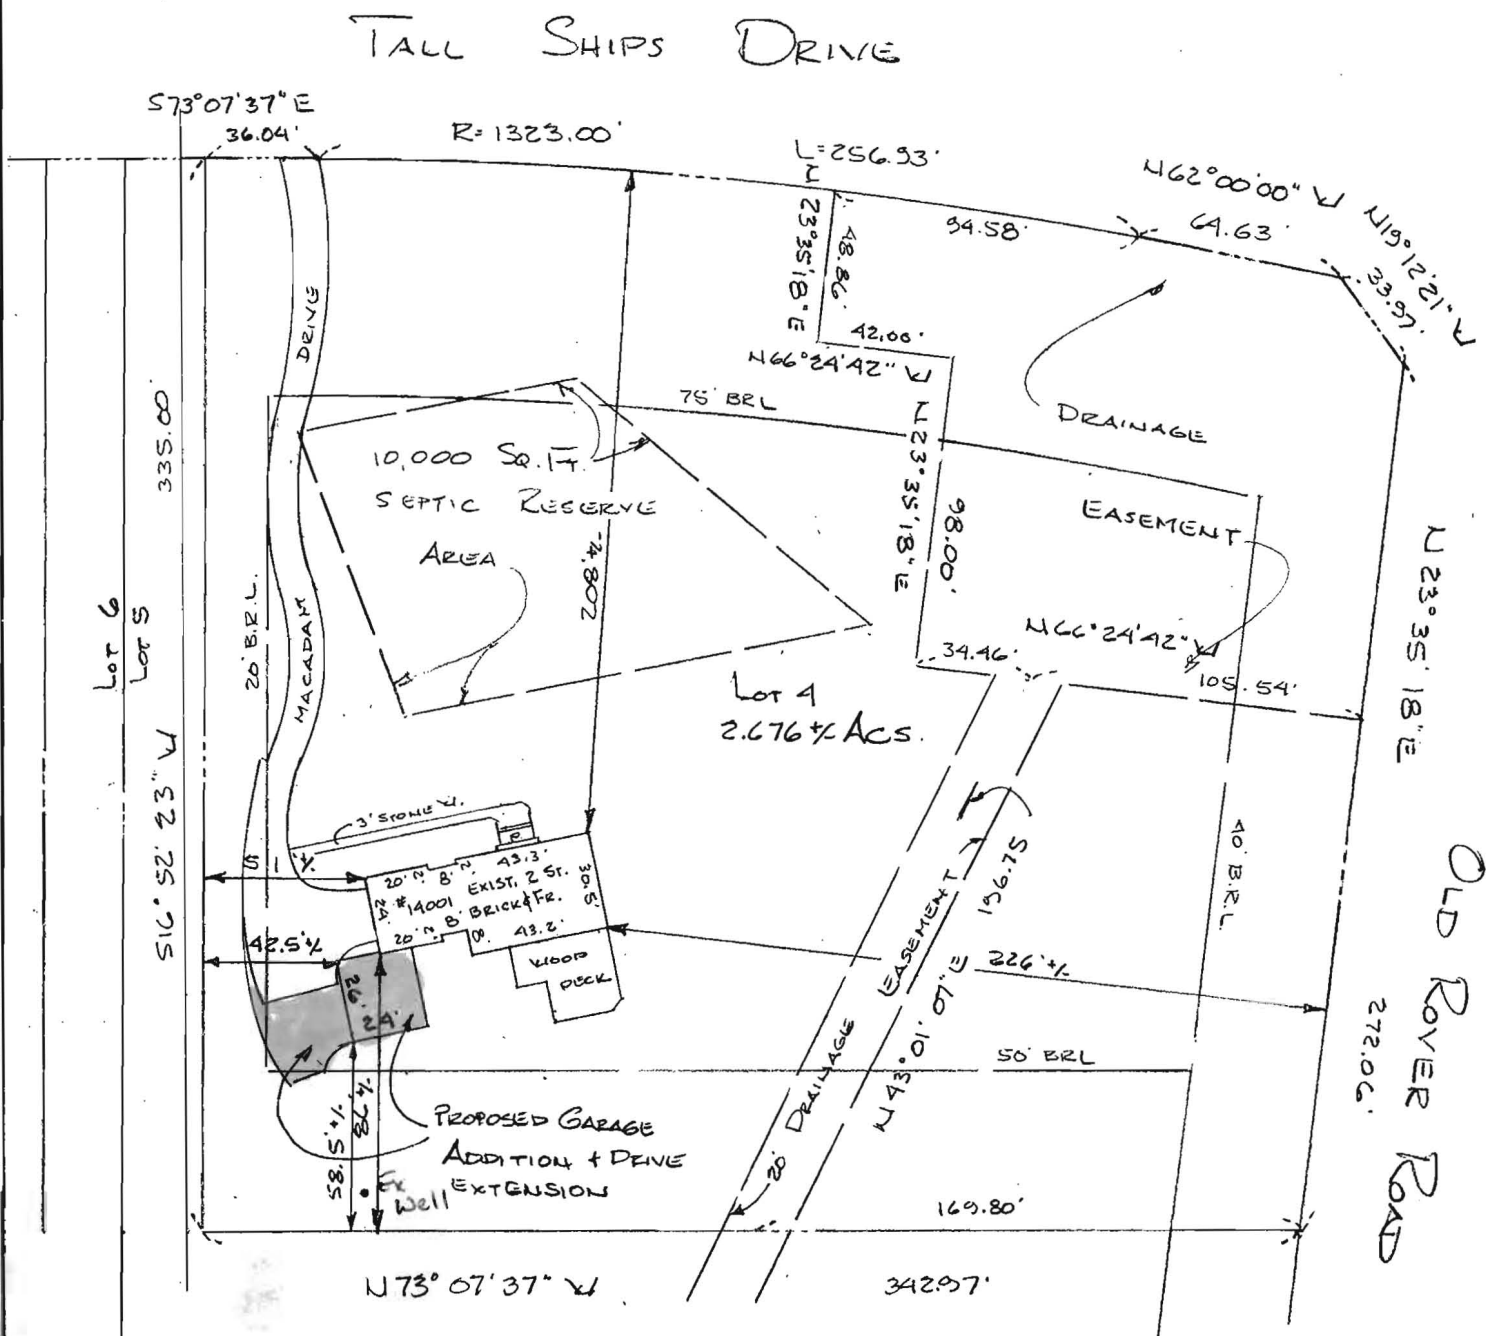

9/10/04 BOO150245 Lot 5
 Ex well > 30' from
 proposed GARAGE. No
 Septic issues.
 OK

KN



J.S.T. Engineering Co., Inc.
 6912 North River Drive
 Baltimore, MD. 21220
 410-335-9142 Fax 410-335-9144

Scale: 1" = 60' Date: 5-24-04