

# APPLICATION

SEWAGE DISPOSAL TESTING

STATE OF MARYLAND - DEPARTMENT OF HEALTH AND MENTAL HYGIENE

HOWARD COUNTY HEALTH DEPARTMENT  
ENVIRONMENTAL HEALTH SERVICES

P. O. BOX 476 ELLICOTT CITY, MARYLAND 21043  
TELEPHONE: 992-2330

DISTRICT

DATE

A 33798

P \_\_\_\_\_

3rd

4/18/84

VOID  
RECONFIGURED  
AS PART OF  
ROBIN'S PROPERTY LOT  
F 91-162

WELL LOCATION CONFLICTS  
WITH USE OF THIS AREA.  
REFER TO A 45836  
FOR CURRENT  
PERCOLATION DETAIL.  
7/19/91 -  
CWH

TO: THE COUNTY HEALTH OFFICER  
ELLICOTT CITY, MARYLAND

I, HEREBY, APPLY FOR THE NECESSARY TEST IN ORDER TO CONSTRUCT (OR RECONSTRUCT) A SEWAGE DISPOSAL SYSTEM.

PROPERTY OWNER

WILLIAM E. STREAKER

ADDRESS

13300 FREDERICK Rd  
WEST FRIENDSHIP, Md 21794

PHONE

489-4435

PROPERTY LOCATION:

SUBDIVISION

STREAKER Property

LOT NO.

LOT 2  
PARCEL 1

ROAD AND DESCRIPTION

Underwood Rd

SIZE OF LOT

LOT 2  
5.44 AC + ~~5.07 AC~~

TYPE BLDG.

(NUMBER OF BEDROOMS)

THE SYSTEM INSTALLED UNDER THIS APPLICATION IS ACCEPTABLE ONLY UNTIL PUBLIC FACILITIES BECOME AVAILABLE. I FULLY UNDERSTAND THE

FEE CONNECTED WITH THE FILING OF THIS PERC TEST APPLICATION IS NON-REFUNDABLE UNDER ANY CIRCUMSTANCES. I ALSO AGREE TO COMPLY

WITH ALL M.O.S.H.A. REQUIREMENTS IN TESTING THIS LOT.

Mrs William E. Streaker

(SIGNATURE OF APPLICANT)

APPROVED BY

FOR

DATE

REJECTED BY

FOR

DATE

HOLD PENDING FURTHER TESTS

DATE

REASONS FOR REJECTION OR HOLDING

5/24/84 - DIG MORE (ROCK, WATER,

SLOW PERCS)

# THIS IS NOT A PERMIT

SOIL PROFILE

0'


INDICATE NORTH - NAME ADJOINING ROADWAY AS BASE LINE.

DATE	TEST NO.	DEPTH	PRE-WET		TEST - 1" DROP		TIME
			START	STOP	START	STOP	
5/24/04	70	5 1/2	ROCK				
I	80	4	ROCK				

REMARKS \_\_\_\_\_

TYPE OF SOIL \_\_\_\_\_

TESTED BY \_\_\_\_\_ ALSO PRESENT \_\_\_\_\_

# APPLICATION

SEWAGE DISPOSAL TESTING

STATE OF MARYLAND - DEPARTMENT OF HEALTH AND MENTAL HYGIENE

A 33798

P \_\_\_\_\_

HOWARD COUNTY HEALTH DEPARTMENT  
ENVIRONMENTAL HEALTH SERVICES

P. O. BOX 476 ELLICOTT CITY, MARYLAND 21043  
TELEPHONE: 992-2330

DISTRICT 3rd

DATE 4/18/84

TO: THE COUNTY HEALTH OFFICER  
ELLICOTT CITY, MARYLAND

I, HEREBY, APPLY FOR THE NECESSARY TEST IN ORDER TO CONSTRUCT (OR RECONSTRUCT) A SEWAGE DISPOSAL SYSTEM.

PROPERTY OWNER William E. STREATER

ADDRESS 13300 FRIEDLANDER RD PHONE 489-NH35  
WHLST FRIEDLANDER MD 21794

PROPERTY LOCATION:

SUBDIVISION STREATER PROPERTY LOT NO. 1

ROAD AND DESCRIPTION Underwood Rd

SIZE OF LOT LOT 2  
5.44 AC + 5.07 AC TYPE BLDG. \_\_\_\_\_

(NUMBER OF BEDROOMS)

THE SYSTEM INSTALLED UNDER THIS APPLICATION IS ACCEPTABLE ONLY UNTIL PUBLIC FACILITIES BECOME AVAILABLE. I FULLY UNDERSTAND THE  
FEE CONNECTED WITH THE FILING OF THIS PERC TEST APPLICATION IS NON-REFUNDABLE UNDER ANY CIRCUMSTANCES. I ALSO AGREE TO COMPLY  
WITH ALL M.O.S.H.A. REQUIREMENTS IN TESTING THIS LOT. Mrs William E. Streater  
(SIGNATURE OF APPLICANT)

APPROVED BY \_\_\_\_\_ FOR \_\_\_\_\_ DATE \_\_\_\_\_

REJECTED BY \_\_\_\_\_ FOR \_\_\_\_\_ DATE \_\_\_\_\_

HOLD PENDING FURTHER TESTS \_\_\_\_\_ DATE \_\_\_\_\_

REASONS FOR REJECTION OR HOLDING \_\_\_\_\_


## THIS IS NOT A PERMIT

BACK OF ENTIRE PARCEL

A 33798

HOLE ELEVATION

- ① ② 21+16 HBS
- ④ LOWEST
- ③ MEDIUM
- ⑤ MEDIUM
- Holes ① ⑤ much higher than hole ③ ④ ⑤
- Holes ③ ④ ⑤ about same elevation

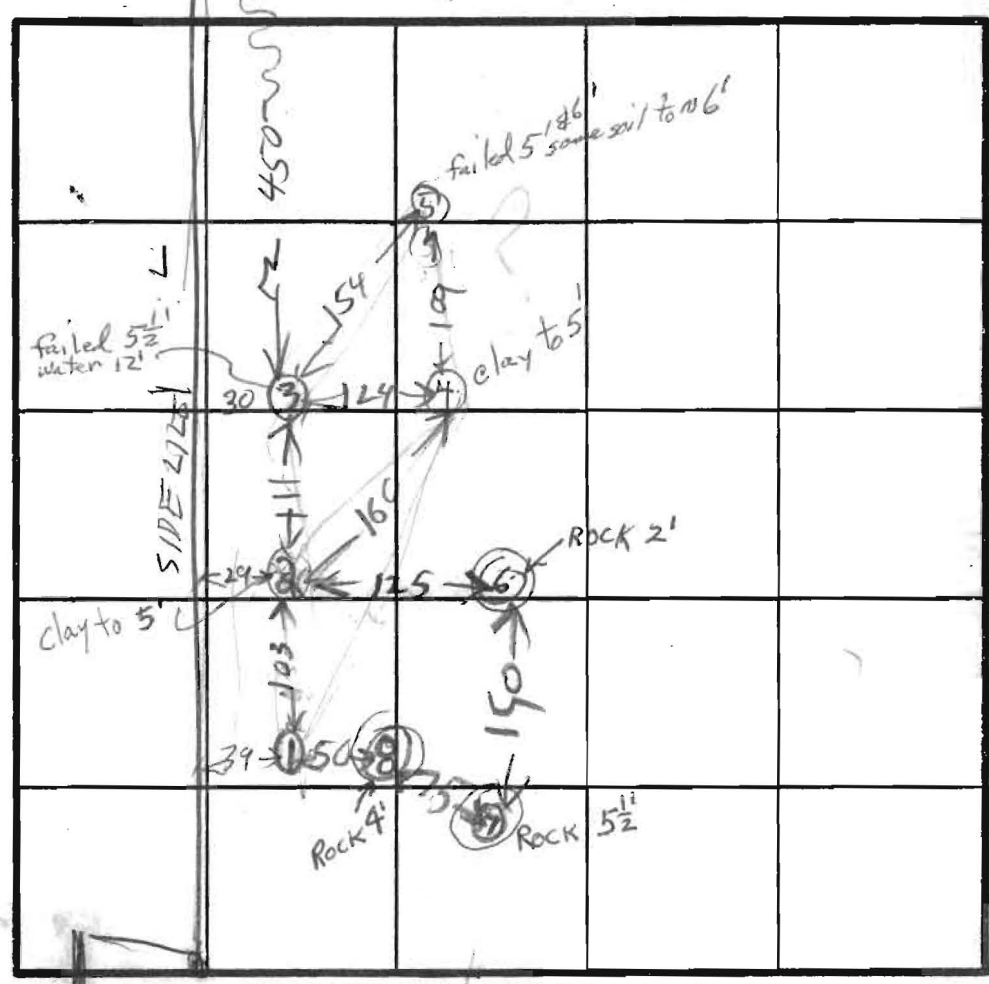

INDICATE NORTH - NAME ADJOINING ROADWAY AS BASE LINE.

DATE	TEST NO.	DEPTH	PRE-WET		TEST - 1" DROP		TIME
			START	STOP	START	STOP	
5/14/84	1S	5	1028	1032	1032	1042	10
	1V	12	LOOKS	OK			
	2S	4 1/2	1034	11 10	little pen slow		
	2V	11 1/2	LOOKS	OK			
	3S	3 1/2	1050	11 25	little pen		
	3V	12	water				
	4S	4 1/2	11 13	11 49	little pen		
	4V	11 1/2	LOOKS	OK			
	5S	5	11 17	11 49	little pen		
	5V	12	LOOKS	OK			
	2M	6	1129	1134	1134	1143	9
	3M	6	1138	1147	1147	1209	22
	3ED	13	WATER		12 1/2	13	
	4M	5 1/2	1205	1207	1207	1216	3
	4EN	12	LOOKS OK				
	5M	6	1228	1254	1254	1231	little pen
	6V	2	ROCK 2 FT				

REMARKS

TYPE OF SOIL

TESTED BY

water came in hole ③ after perc

R HODGES

BACKHOLE BRUCE MENZ  
SON OF OWN FR WILLIAM STRECKER  
ALSO PRESENT

①  
BROWN CLAY  
BROWN SAND LOAM

SOIL PROFILE

②  
BROWN CLAY SAND  
GRAY SAND  
HARD

③  
BROWN CLAY  
BROWN SAND  
WATER

④  
CLAY  
TAN SAND

⑤  
CLAY SAND  
AND Y  
EH 12-1079