

PERMIT

SEWAGE DISPOSAL SYSTEM

MARYLAND STATE DEPARTMENT OF HEALTH

HOWARD COUNTY

ELLICOTT CITY

DISTRICT 3rd

DATE 11/10/76

INDEXED

Bolinger Brothers

IS PERMITTED TO INSTALL X ALTER

ADDRESS 1345 Bolinger Road, Westminster, Md. 21157 PHONE 848-6527

A SEWAGE DISPOSAL SYSTEM LOCATED AT

(Lilyann Lane & Lilyann Circle) off River Rd
SUBDIVISION (Berndell Estates) ROAD River Road & Route 32 LOT 23

PROPERTY OWNER Mr. Woodrow Hay

803 Windsor Drive

ADDRESS

SPECIFICATIONS 3 bedrooms

DRAIN FIELD _____ DEPTH _____ FEET. BOTTOM AREA _____ SQ. FT.

SEEPAGE PITS _____ ABSORBENT SIDE-WALL AREA _____ SQ. FT.

SEPTIC TANK CAPACITY 1000 GALLONS

FOR GARBAGE GRINDER, INCREASE DISPOSAL AREA 22% & TANK CAPACITY 50%.

OTHER DRY WELL(S) - To have 132 sq. ft. effective absorbent sidewall area per bedroom below inlet. Inlet to be 4 ft. below original grade and maximum depth of dry well to be 11 ft. Locate dry well(s) 246 ft. from the 350.30 ft. property line and 150 ft. from the 618.14 ft. property line. *If trench is to be used, call this office for permission and recommendation.

NOTE: ALL PIPE FROM HOUSE TO DISPOSAL AREA MUST BE CAST IRON.
PERMIT VOID AFTER THREE YEARS.

NOTE: INSTALL STAND PIPE ON SEPTIC TANK AND DRY WELL. STAND PIPES MUST BE 6 INCHES IN DIAMETER. CAST IRON, CONCRETE OR TERRA COTTA ACCEPTED.

PLANS APPROVED BY William W. Zepp DATE 10/28/74

FILL SEPTIC TANK AND DISTRIBUTION BOX WITH WATER BEFORE CALLING FOR AN INSPECTION. COVER NO WORK UNTIL INSPECTED AND APPROVED.

NEITHER THE HOWARD COUNTY COMMISSIONERS NOR THE HEALTH DEPARTMENT IS RESPONSIBLE FOR THE SUCCESSFUL OPERATION OF ANY SYSTEM.

BDDG. PERMIT SIGNED
AND RETURNED 4/12/76

Serial # 37386 - Shag


BDDG. PERMIT SIGNED
AND RETURNED 6/25/76

Serial # 40492
Admission

781278

20480

32
13
20
21
17
12
102
101
system located correctly

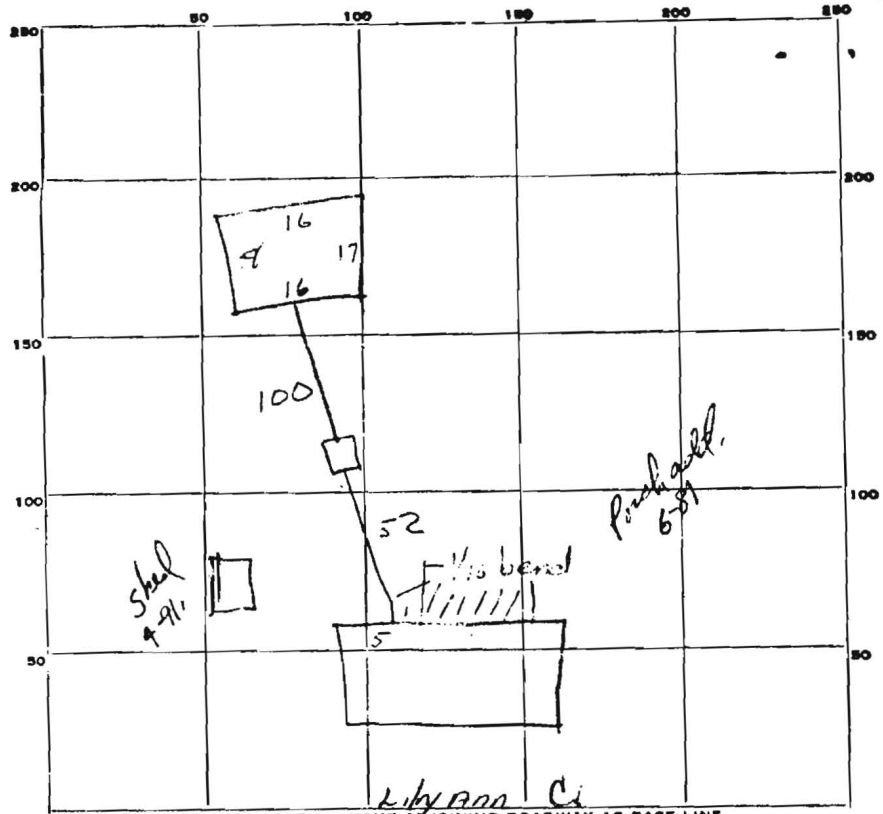

Location O.K.

5' 11 1/2'

PERMIT CARD yes
 SEPTIC TANK, LEVEL 1000 gal - yes CLEANOUTS 57 DW yes / not cemented
 DISTRIBUTION BOX, LEVEL _____
 TILE FIELD, DEPTH _____ FT. TRENCH WIDTH _____ FT.
 GRAVEL DEPTH _____ IN. TOTAL LENGTH _____ FT.
 NUMBER OF TRENCHES _____ TOTAL BOTTOM AREA _____
 SEEPAGE PITS, INSIDE DIAMETER 67 FT. DEPTH BELOW INLET 6 1/2 FT.
 ABSORBENT AREA 402 SQ. FT.

REMARKS 11-16-76 - DW al- installed up side down & not cemented - not finished H13
11-17-76 - system has not been corrected
11/23/76 - dia out with tile properly

DATE SYSTEM APPROVED 11/23/76 INSPECTOR K P T - L.O.