

1 2 3 4 5 6
THIS NUMBER IS TO BE PUNCHED IN COLS. 3-6 ON ALL CARDS!
DATE RECEIVED (WRA USE ONLY)

3451

SEQUENCE NO. (WRA USE ONLY)

STATE OF MARYLAND
WATER RESOURCES ADMINISTRATION
TAWES STATE OFFICE BLDG., ANNAPOLIS, MD. 21401
WELL COMPLETION REPORT

THIS REPORT MUST BE SUBMITTED WITHIN 30 DAYS AFTER WELL COMPLETION
FILL IN THIS FORM COMPLETELY

COUNTY NUMBER 20480

DEPTH OF WELL

105

PERMIT NO. FROM "PERMIT TO DRILL WELL"

H0-73-1723

DRILLERS IDENTIFICATION NO.

OWNER

LAST NAME

FIRST NAME

STREET OR RD.

POST OFFICE

Lot 23
Beverly East

WELL DESCRIPTION

WELL LOG
STATE THE KIND OF FORMATIONS PENETRATED, THEIR COLOR, DEPTH, THICKNESS AND IF WATER BEARING

DESCRIPTION (USE ADDITIONAL SHEETS IF NECESSARY)

0 33
33 105

Shale
Grey granite

GROUTING RECORD

WELL HAS BEEN GROUTED (CIRCLE APPROPRIATE BOX) YES NO
TYPE OF GROUTING MATERIAL (CIRCLE APPROPRIATE BOX):
CEMENT BENTONITE CLAY
NO. OF BAGS 11 NO. OF POUNDS
GALLONS OF WATER 600
DEPTH OF GROUT SEAL (TO NEAREST FOOT):
FROM 48 FT. TO 58 FT.
CENTER OF FROM SURFACE

CASING RECORD

CASING TYPE (CIRCLE APPROPRIATE CODE BELOW):
STEEL CONCRETE
PLASTIC OTHER
MAIN CASING TYPE: 6C 61 63 64 66 7C
NOMINAL DIAMETER TOP MAIN CASING (NEAREST INCH)
TOTAL DEPTH OF MAIN CASING (NEAREST FOOT)

OTHER CASING

DIAMETER (INCH) DEPTH (FEET) FROM TO

SCREEN TYPE OF OPEN HOLE

SCREEN RECORD

(INSERT APPROPRIATE CODE BELOW):
STEEL BRASS OR BRONZE OPEN HOLE
PLASTIC OTHER

DEPTH (NEAREST WHOLE FOOT):
FROM TO
1 8 9 11 15 17 21
2 23 24 26 30 32 36
3 38 39 41 45 47 51
SLOTS SIZE 1. 2. 3.

DIAMETER OF SCREEN 56 INCHES FROM TO

GRAVEL PACK IF WELL DRILLED WAS A FLOWING WELL CIRCLE BOX 68

WRA USE ONLY NOT TO BE FILLED IN BY DRILLER:
TELESCOPE CASING LOG INDICATOR OTHER DATA AVAILABLE

PUMPING TEST


HOURS PUMPED (TO NEAREST HOUR) 2
PUMPING RATE (GALLONS PER MINUTE TO NEAREST GALLON) 10
METHOD USED TO MEASURE PUMPING RATE
WATER LEVEL (DISTANCE FROM LAND SURFACE):
BEFORE PUMPING 17 NEAREST FOOT
AFTER PUMPING 22 NEAREST FOOT
TYPE OF PUMP USED (CIRCLE APPROPRIATE BOX) (FOR PUMPING TEST):
A AIR 27 P PISTON 27 T TURBINE 27
C CENTRIFUGAL 27 R ROTARY 27 O OTHER (DESCRIBE BELOW) 27
J JET 27 S SUBMERISBLE 27

PUMP INSTALLED

TYPE OF PUMP (WRITE APPROPRIATE LETTER IN BOX - SEE ABOVE: A, C, J, P, R, S, T, O)
OR DRILLER WILL INSTALL PUMP (CIRCLE APPROPRIATE BOX) YES NO
CAPACITY:
GALLONS PER MINUTE (TO NEAREST GALLON) 31 35
PUMP HORSE POWER 37 41
PUMP COLUMN LENGTH (NEAREST FOOT) 43 47

CASING HEIGHT (CIRCLE APPROPRIATE BOX AND ENTER CASING HEIGHT):
+ ABOVE LAND SURFACE
- BELOW 49 50 51 (NEAREST FOOT)

LOCATION OF WELL ON LOT
SHOW PERMANENT STRUCTURE SUCH AS BUILDINGS, SEPTIC TANKS, AND/OR OTHER LAND MARKS AND INDICATE NOT LESS THAN TWO DISTANCE MEASUREMENTS TO WELL.

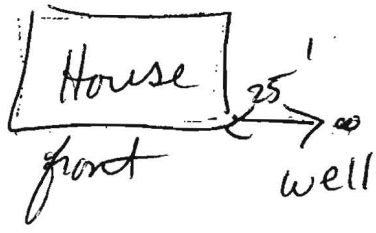

CIRCLE APPROPRIATE BOXES

- A WELL WAS ABANDONED AND SEALED WHEN THIS WELL WAS COMPLETED
- ELECTRIC LOG OBTAINED
- TEST WELL CONVERTED TO PRODUCTION WELL

I HEREBY CERTIFY THAT I HAVE COMPLIED WITH ALL CONDITIONS STATED ON THE ABOVE-CAPTIONED "PERMIT TO DRILL WELL", AND THAT INFORMATION CONTAINED IN THIS REPORT IS TRUE, ACCURATE, AND COMPLETE TO THE BEST OF MY KNOWLEDGE, INFORMATION AND BELIEF.

DRILLERS NAME
PLEASE PRINT
SIGNATURE