

LAYOUT _____ INSP 4 _____

INSP 2 _____ INSP 5 _____

INSP 3 _____ INSP 6 _____

ISSUE DATE: 3/12/76

P 22951

APPROVAL DATE: 3/19/76

A 520485

PERMIT

INDEXED

TAX ID # 04321588

ON-SITE SEWAGE DISPOSAL SYSTEM HOWARD COUNTY HEALTH DEPARTMENT BUREAU OF ENVIRONMENTAL HEALTH

_____ IS PERMITTED TO INSTALL ALTER

ADDRESS: _____ PHONE NUMBER: _____

SUBDIVISION: _____ LOT NUMBER: 12

ADDRESS: 772 West Watersville Road PROPERTY OWNER: James Lilley

SEPTIC TANK CAPACITY (GALLONS): _____ OUTLET BAFFLE FILTER REQUIRED

PUMP CHAMBER CAPACITY (GALLONS): _____ COMPARTMENTED TANK REQUIRED

NUMBER OF BEDROOMS: _____

SQUARE FEET PER BEDROOM: _____

LINEAR FEET OF TRENCH REQUIRED: _____

TRENCHES:	Trench to be _____ feet wide. Inlet _____ feet below original grade. Bottom maximum depth _____ feet below original grade. Effective area begins at _____ feet below original grade. _____ feet of stone below distribution pipe.
LOCATION:	_____
NOTES:	_____

PLANS APPROVED: _____ DATE: _____

- NOTE: PERMIT VOID AFTER 2 YEARS
- NOTE: CONTRACTOR RESPONSIBLE FOR SCHEDULING A PRE-CONSTRUCTION INSPECTION FOR ALL INSTALLATIONS
- NOTE: WATERTIGHT SEPTIC TANKS REQUIRED
- NOTE: ALL PARTS OF SEPTIC SYSTEM SHALL BE 100 FEET FROM ANY WATER WELL
- NOTE: MANHOLE RISERS REQUIRED ON ALL SEPTIC TANKS AND PUMP CHAMBERS UNLESS SPECIFICALLY AUTHORIZED

**NEITHER THE HOWARD COUNTY COUNCIL NOR THE HEALTH DEPARTMENT IS
RESPONSIBLE FOR THE SUCCESSFUL OPERATION OF ANY SYSTEM
PERMITTEE RESPONSIBLE FOR OBTAINING FINAL APPROVAL ON THIS PERMIT
CALL 410-313-2640 FOR INSPECTION OF SEPTIC SYSTEM**

A 520485

3/12/76
trench inspection
3/19/76
ready

PERMIT

A520485 P 22951
A 20485

SEWAGE DISPOSAL SYSTEM

MARYLAND STATE DEPARTMENT OF HEALTH

HOWARD COUNTY

04-321588

ELLICOTT CITY

DISTRICT 4th

INDEXED

DATE 3/12/76

Michael & Richard Larrick IS PERMITTED TO INSTALL ALTER

ADDRESS Black Ankle Road, Mt. Airy, Maryland PHONE 795-6554

A SEWAGE DISPOSAL SYSTEM LOCATED AT

SUBDIVISION ROAD 772 West Watersville Rd. LOT 12

PROPERTY OWNER James H. Lilley

ADDRESS 3355 N. St. John's Lane, Ellicott City, Md. 21043 Phone: 465-7724

SPECIFICATIONS 3 bedrooms

DRAIN FIELD DEPTH FEET, BOTTOM AREA SQ. FT.

SEEPAGE PITS ABSORBENT SIDE-WALL AREA SQ. FT.

SEPTIC TANK CAPACITY 1000 GALLONS

FOR GARBAGE GRINDER, INCREASE DISPOSAL AREA 22% & TANK CAPACITY 50%.

OTHER TRENCHES - Two trenches - each trench 50 ft. long - 2 feet wide - 7 feet deep - with 3 feet gravel under pipe - spaced 9 feet apart center to center. Place trenches in area between 185 ft. to 200 ft. from front lot line and between 50 ft. to 100 ft. from left side line as seen when facing from the front. Call for inspection of trenches before gravel is installed.

NOTE: ALL PIPE FROM HOUSE TO DISPOSAL AREA MUST BE CAST IRON.

PERMIT VOID AFTER THREE YEARS.

NOTE: INSTALL STAND PIPE ON SEPTIC TANK. STAND PIPES MUST BE 6 INCHES IN DIAMETER. CAST IRON, CONCRETE OR TERRA COTTA ACCEPTED.


PLANS APPROVED BY Donald W. Monaghan DATE 8/19/74

FILL SEPTIC TANK AND DISTRIBUTION BOX WITH WATER BEFORE CALLING FOR AN INSPECTION. COVER NO WORK UNTIL INSPECTED AND APPROVED.

NEITHER THE HOWARD COUNTY COMMISSIONERS NOR THE HEALTH DEPARTMENT IS RESPONSIBLE FOR THE SUCCESSFUL OPERATION OF ANY SYSTEM.

A 20485

20485

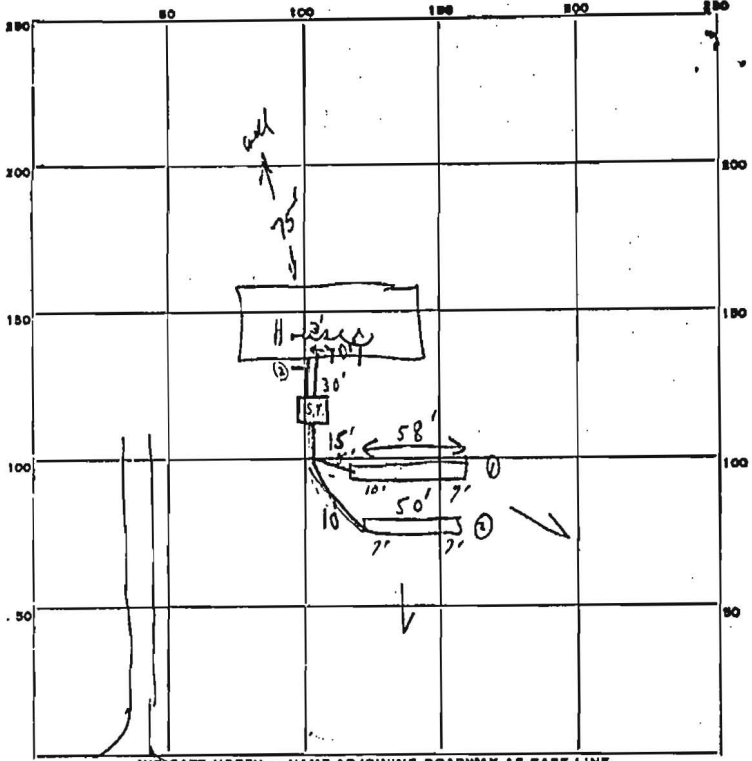

② Cleanout to surface 1' out from foundation

INDICATE NORTH. - NAME ADJOINING ROADWAY AS BASE LINE.

W. Waterville Road

PERMIT CARD ① N/A ② Yes + signed S.T. D.W.
 SEPTIC TANK, LEVEL ② No in!! ① No in/ N/A
 DISTRIBUTION BOX, LEVEL ① N/A ② Man hole to surface
 TILE FIELD, DEPTH 7'-11" FT. TRENCH WIDTH 2'± FT.
 GRAVEL DEPTH 5" IN? TOTAL LENGTH 108 FT. }
 NUMBER OF TRENCHES 2 @ 50' trench to 1' } 540
 SEEPAGE PITS, INSIDE DIAMETER outside perimeter FT. DEPTH BELOW INLET FT.
 ABSORBENT AREA 540 ± SQ. FT.

REMARKS 3/12/76 Partial order in place as of terms of inspection!
 3/19/76 joints of cast iron connected together; Note dry down
 to cast iron behind clean out to cover system
 Note heavy grass on trench!! (Cleanout has a basket in it)

DATE SYSTEM APPROVED as per spec 3/19/76 INSPECTOR C. B. [Signature]