

HOWARD COUNTY
PERMIT APPLICATION

PERMIT NUMBER

B 00156935

Building Address 772 WEST WATERSVILLE RD
MT AIRY MD. 21771

Property Owner's Name JAMES AND JODY LILLEY
Address 772 WEST WATERSVILLE RD

Suite/Apt. #: _____ SDP/WP/Petition #: _____

Census Tract 004001 Subdivision DICKETTS FARMS IN

City MT AIRY State MD Zip Code 21771

Section _____ Area _____ Lot 12

Home Phone _____ Work Phone _____

Tax Map 2 Parcel 151 Grid 13

Applicant's Name & Mailing Address, (if other than stated hereon): _____

Zoning R-100 Map Coordinates 236 Lot size 1.67 ACRES

Phone 410 795 1779 Fax _____

Existing Use SINGLE FARM

Contractor Company W.M. QUINN CORP INC

Proposed Use SINGLE

Contact Person WAYNE QUINN

Estimated Construction Cost \$ 100,000

Description of Work 1 STORY ADDITION WITH WALK
OUT BASEMENT, ALTERATION TO EXISTING
HOUSE, DECK AND WALKWAY

Address PO BOX 1400

City E.C. State MD Zip Code 21011

License No. 44019 Phone 410 461 7413 Fax 410 461 8732

Occupant or Tenant JAMES & JODY LILLEY

Engineer or Architect Company STUART MCCREY

Contact Name SAME

Contact Person TELO

Address SAME

Address 8329 MAIN ST

City _____ State _____ Zip Code _____

City E.C. State MD Zip Code 21013

Phone _____ Fax _____

Phone 410 465 8732 Fax _____

BUILDING DESCRIPTION - COMMERCIAL

BUILDING DESCRIPTION - RESIDENTIAL

Building Characteristics

Utilities

Height: _____

Water Supply:

No. of stories: _____

Public ☐

Private ☐

Gross area, sq. ft. per floor: _____

Sewage Disposal:

Public ☐

Private ☐

Use group: _____

Electric Yes ☐ No ☐

Gas Yes ☐ No ☐

Construction type:

Heating System:

Reinforced Concrete ☐

Electric ☐ Oil ☐

Structural Steel ☐

Natural Gas ☐

Masonry ☐

Propane Gas ☐

Wood Frame ☐

Sprinkler system: N/A ☐

State Certified Modular ☐

Full ☐

Partial ☐

Other Suppression ☐

of Heads _____

Building Characteristics

Utilities

SF Dwelling ☐ SF Townhouse ☐

Water Supply:

Depth _____ Width _____

Public ☐

1st floor: _____

Private ☒

2nd floor: _____

Sewage Disposal:

Basement: _____

Public ☐

Finished Basement ☐ Unfinished Basement ☐

Private ☒

Crawl space ☐ Slab on Grade ☐

Electric Yes ☒ No ☐

No. of Bedrooms 2 total

Gas Yes ☐ No ☒

Height: _____

Heating System:

Multi-family dwellings: _____

Electric ☐ Oil ☒

No. of efficiency units: _____

Natural Gas ☐

No. of 1 BR units: _____

Propane Gas ☐

No. of 2 BR units: _____

Sprinkler system: N/A ☒

No. of 3 BR units: _____

NFPA #13D ☐

Other Structure: _____

NFPA #13R ☐

Dimensions: _____

Other: _____

Footings: _____

Roof Height: _____

State Certified Modular ☐

Manufactured Home ☐

THE UNDERSIGNED HEREBY CERTIFIES AND AGREES AS FOLLOWS: (1) THAT HE/SHE IS AUTHORIZED TO MAKE THIS APPLICATION; (2) THAT THE INFORMATION IS CORRECT; (3) THAT HE/SHE WILL COMPLY WITH ALL REGULATIONS OF HOWARD COUNTY WHICH ARE APPLICABLE THERETO; (4) THAT HE/SHE WILL PERFORM NO WORK ON THE ABOVE REFERENCED PROPERTY NOT SPECIFICALLY DESCRIBED IN THIS APPLICATION; (5) THAT HE/SHE GRANTS COUNTY OFFICIALS THE RIGHT TO ENTER ONTO THIS PROPERTY FOR THE PURPOSE OF INSPECTING THE WORK PERMITTED AND POSTING NOTICES.

Wayne Quinn
Applicant's Signature
Pres W.M. Quinn
Title/Company

WAYNE QUINN
Print Name
11/7/02
Date

Checks payable to: DIRECTOR OF FINANCE OF HOWARD COUNTY
** PLEASE WRITE NEATLY AND LEGIBLY. **

- FOR OFFICE USE ONLY -

AGENCY DATE SIGNATURE APPROVAL
Land Development DPZ
State Highways
Building Official
Dev. Engineering DPZ
Health
Fire Protection
Is Sediment Control approval required prior to issuance?
YES ☐ NO ☐


DPZ SETBACK INFORMATION PROPERTY ID#
Front: _____ Filing fee \$ 25.00
Rear: _____ Permit fee \$ _____
Side: _____ Excise tax \$ _____
Side St: _____ Add'l per. fee \$ _____
All minimum setbacks met? TOTAL FEES \$ _____
YES ☐ NO ☐ Sub-total paid \$ _____
Is Entrance Permit required? Balance due \$ 6096
YES ☐ NO ☐ Check # 103040
Validation
Historic District? _____
YES ☐ NO ☐

CONTINGENCY CONSTRUCTION START: ☐
ONE STOP SHOP: ☐

Lot Coverage for New/Town Zone _____
SDP/Red-line approval date _____ Accepted by 3

Distribution of Copies: White: Building Official Green: LDD, DPZ Yellow: DED, DPZ Pink: Health Gold: SHA
T:\forms\PERMIT.FRM Rev. 11/4/04

Dec. 14 2005 07:41PM P2

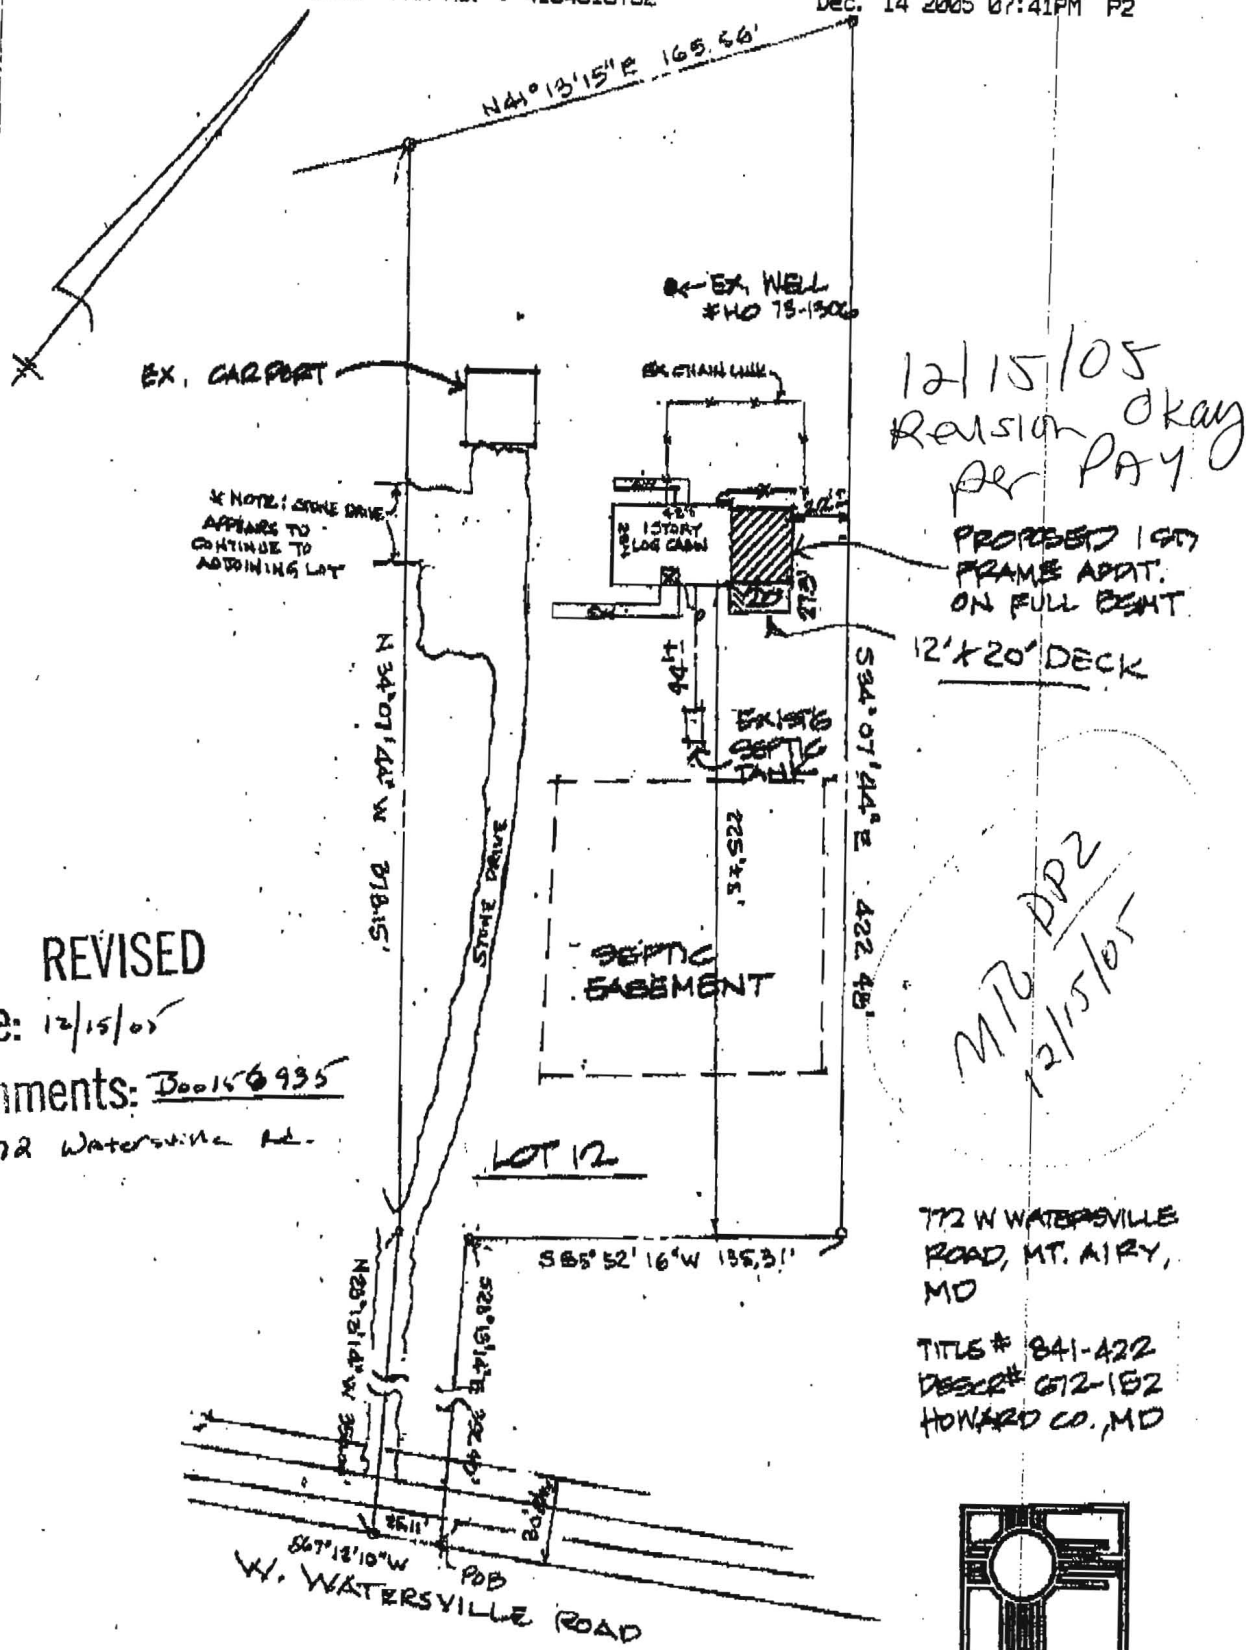

REVISED
Date: 12/15/05
Comments: Boo 156935
772 Watersville Rd.


MTB DP2
12/15/05

772 W WATERSVILLE
ROAD, MT. AIRY,
MD

TITLE # 841-422
DESCR# 612-1B2
HOWARD CO., MD

	SITE PLAN	1"=60'
	LILLEY RESIDENCE	10/28/05



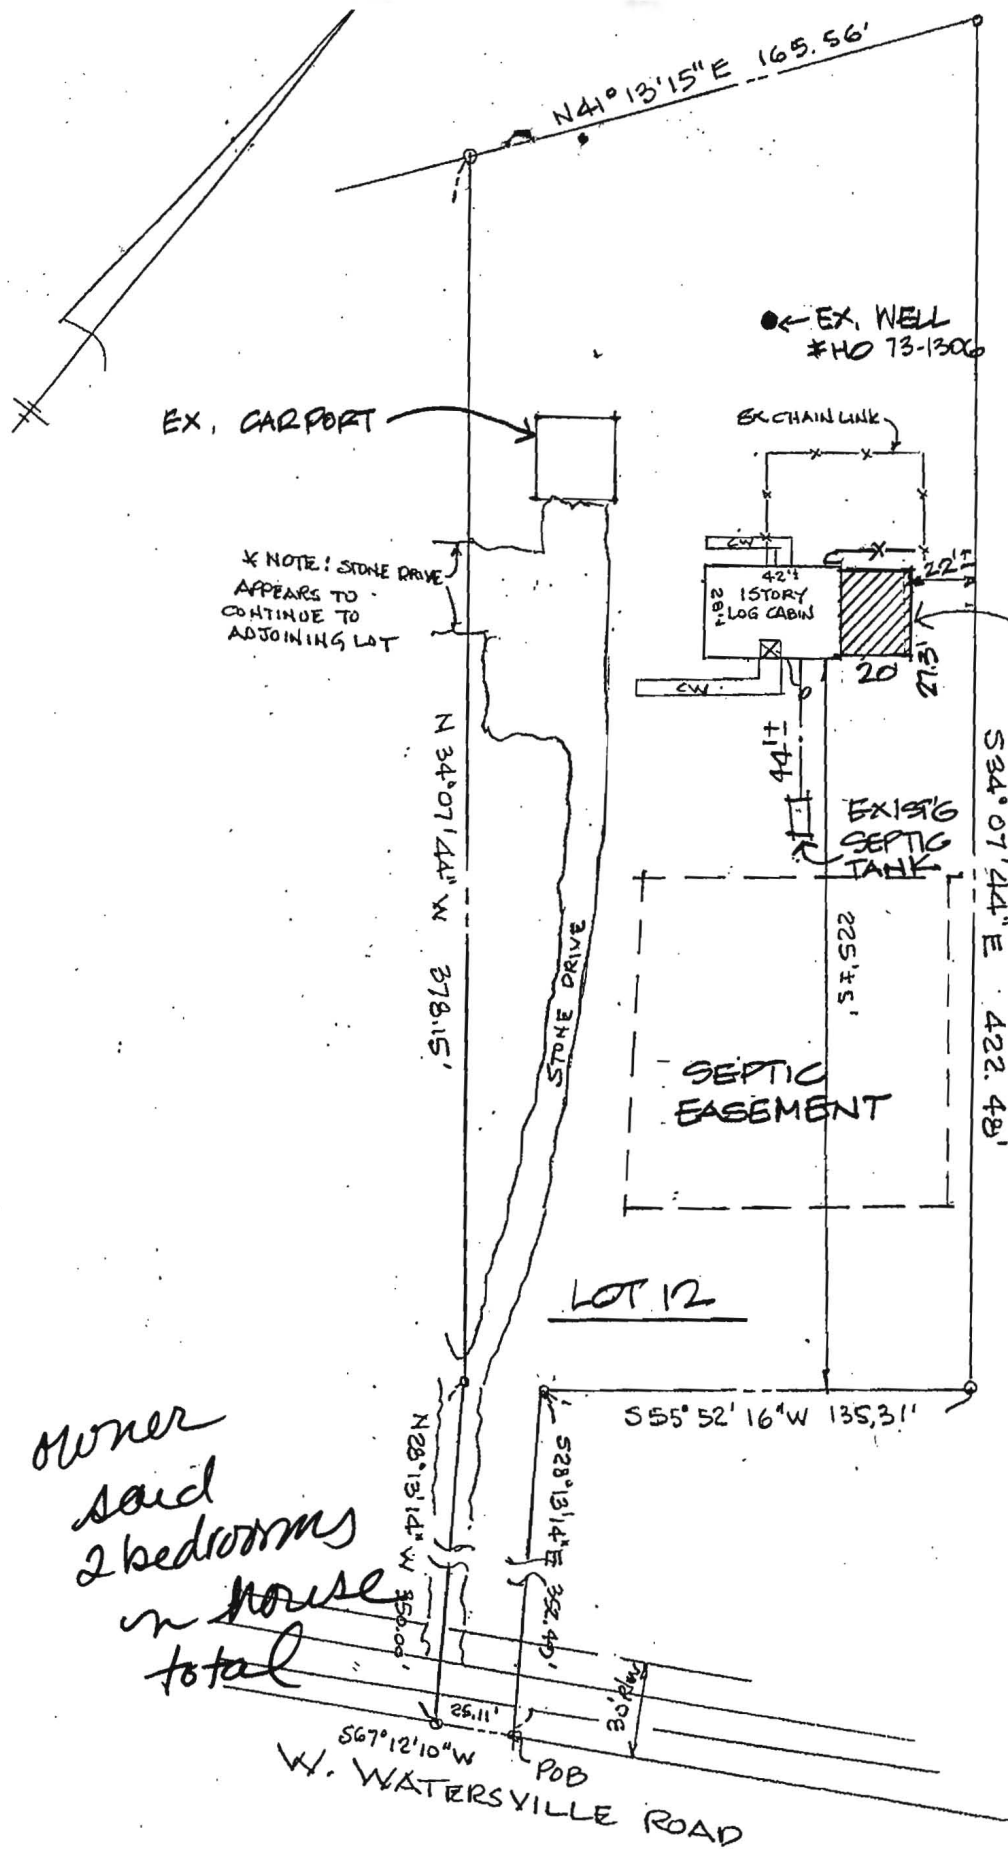

PROPOSED 1STY
FRAME ADDIT.
ON FULL BSMT
OK'd
ON
11-28-05
KN
BP00156935

owner
said
2 bedrooms
in house
total

772 W WATERSVILLE
ROAD, MT. AIRY,
MD

TITLE # 841-422
DESCR# 672-152
HOWARD CO., MD

S-1	SITE PLAN	1"=60'
	LILLEY RESIDENCE	10/28/05

