

Fill out & mail to:
Make \$30.00 check payable to:
Howard County Health Dept. - Sanitation

APPLICATION

Lilly
A-20485

6/30/74 *Recorded*
STATE OF MARYLAND - DEPARTMENT OF HEALTH AND MENTAL HYGIENE
HOWARD COUNTY HEALTH DEPARTMENT
ENVIRONMENTAL HEALTH SERVICES
P. O. BOX 476, ELLICOTT CITY, MARYLAND 21043
TELEPHONE: 485-5000, EXT. 356
DISTRICT *4th*
DATE *8-10-74*

8/16/74
9:30
Sewer Tank - 72" x 36" - 1000 gal.
Drain Trench - 2 Trenches - each trench 50' long - 8" wide
7' deep with 3' gravel under pipe - Spaced 9' apart center
to center.
Place Drain Trench in area between 185' - 200' from
front lot line and between 50' - 100' from left side line
as seen when facing from the front.

TO: THE COUNTY HEALTH OFFICER
ELLICOTT CITY, MARYLAND
I, HEREBY, APPLY FOR THE NECESSARY TEST IN ORDER TO CONSTRUCT (OR RECONSTRUCT) A SEWAGE
DISPOSAL SYSTEM.

PROPERTY OWNER *James Dickey - Dickey Farms, Inc.*
ADDRESS *Forsythe Rd.* PHONE *through Charles Wetland 465-8755*

PROPERTY LOCATION:
SUBDIVISION *none* LOT NO. *12*
ROAD AND DESCRIPTION *directions west on 144 to W. Watersville Rd - turn right
cross new bridge, follow road - property between A-frame + brick rancher on left*
SIZE OF LOT *1.677 acres* TYPE BLDG. *none*
IF NOT SINGLE RESIDENCE DESCRIBE *look for Mr. Lilly - 1972 bright blue fly* NUMBER OF BEDROOMS *illustrated*


THE SYSTEM INSTALLED UNDER THIS APPLICATION IS ACCEPTABLE ONLY UNTIL PUBLIC
FACILITIES BECOME AVAILABLE
SIGNATURE OF APPLICANT *James H. Lilly* 3255 N. St. Johns Lane
- Ellicott City, Md 21043

APPROVED BY *Mr. Moring* FOR *Frank Schaller* DATE *8/19/74*
(KIND OF SYSTEM) (KIND OF SYSTEM)
REJECTED BY _____ FOR _____ DATE _____
(KIND OF SYSTEM) (KIND OF SYSTEM)
HOLD PENDING FURTHER TESTS _____ DATE _____
REASONS FOR REJECTION OR HOLDING _____

BLDG. PERMIT SIGNED
AND RETURNED *11/28/74*

*5/9/74 - Certified Labeled - R.W.M. (Don't leave this application
anywhere.)*

THIS IS NOT A PERMIT

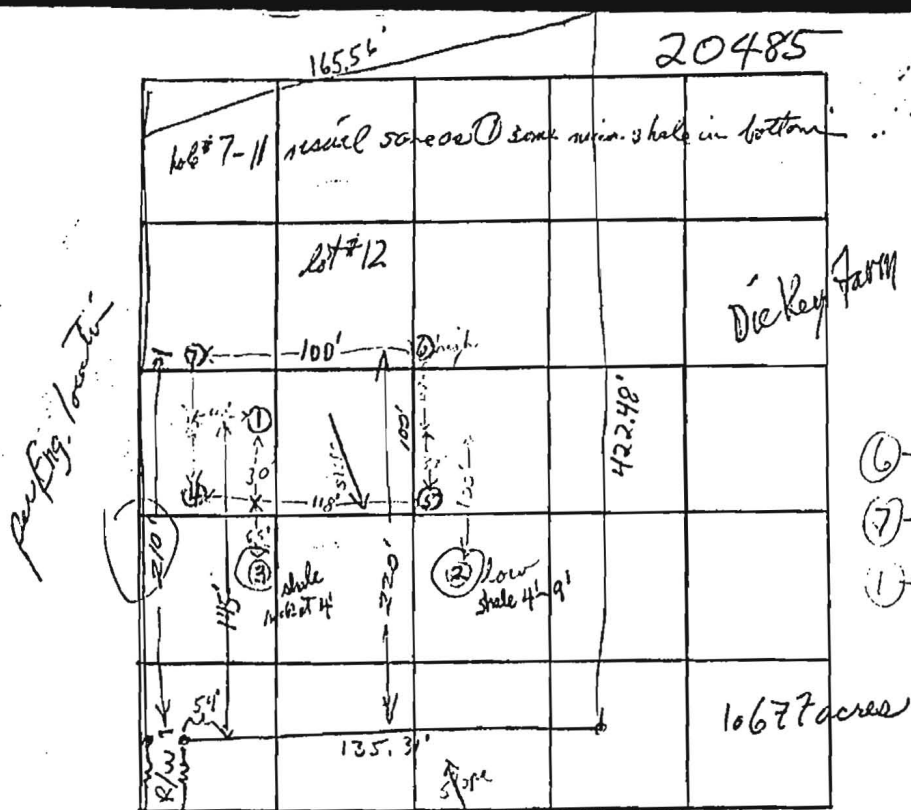

①→② ~ 13' drop
 ⑦→④ ~ 7' drop
 ①→④ ~ 4' drop

INDICATE NORTH - NAME ADJOINING ROADWAY AS BASE LINE.
 West Waterville Rd.

DATE	TEST NO.	DEPTH	PRE-WET START	PRE-WET STOP	TEST - 1" DROP START	TEST - 1" DROP STOP	TIME
9/16/74	1	4'	10:09	10:15	10:15	10:21	6 min
	1A	11 1/2'	10:07	10:24	10:18	10:28	14 min
	②	9'	shale	4'→9'			
	③	4'	shale rich in 4'				
	4	12'	11:50	11:57	11:57	12:02	11 min
	5 hor	4 1/2'	11:37	11:49	11:03	11:14	5 min
	5A	12'	11:04	11:07	11:07	11:17	10 min
	6 hunk	3 1/2'	11:27	11:32	11:32	11:46	14 min
	6 A	11'	11:22	11:23	11:23	11:24	1 min
	2w 6 A	11'	11:24	11:25	11:25	11:25	...

4 gal.
 total

6
 14
 11
 5
 10
 14
 1
 716
 9 min

same soil as ①

11:30 dry hole

REMARKS Mr. W. W. W. recommends shallow test.

TYPE OF SOIL ① silty, weathered brown shale to 1' ② low weathered shale (shale) harder shale from 9 to 11 ft.

TESTED BY K. S. ALSO PRESENT: H. S. Kirk, N. S. Kirk