

preliminary

APPLICATION

A 11928


SEWAGE DISPOSAL TESTING

P _____

MARYLAND STATE DEPARTMENT OF HEALTH

HOWARD COUNTY <u>3 BEDROOMS</u>	<u>4 BEDROOMS</u>	ELLICOTT CITY
<u>750 Gal Tank</u>	<u>1000 Gal Tank</u>	DISTRICT <u>Third</u>
<u>Dry Well - 300 sq ft below sidewalk area with a maximum depth of 13 ft</u>	<u>Dry Well 400 sq ft below sidewalk area with a maximum depth of 13 ft</u>	DATE <u>June 20, 1966</u>
<u>Place the dry well 47 ft to 67 ft from the front lot line and 15 ft to 35 ft from the right side of the lot as seen when facing the lot</u>		
TO: THE COUNTY HEALTH OFFICER ELLICOTT CITY, MARYLAND		
I, HEREBY, APPLY FOR THE NECESSARY TESTS IN ORDER TO CONSTRUCT (OR RECONSTRUCT) A SEWAGE DISPOSAL SYSTEM.		
PROPERTY OWNER <u>Ben Catchings & Loris S. Catchings, his wife</u>		
ADDRESS <u>1411 Winston Ave., Baltimore, Md. 21215</u> PHONE <u>IND 5-8417</u>		
PROPERTY LOCATION: <u>Park Road</u>		
SUBDIVISION <u>River Park Estates</u> LOT NO. <u>43</u>		
ROAD AND DESCRIPTION <u>West side of Taylor Park Road, 1st plat</u>		
OCCUPANT _____ PHONE _____		
PERSON TO CONSTRUCT SYSTEM _____		
ADDRESS _____ PHONE _____		
SIZE OF LOT <u>140' front by 327' deep</u> TYPE BLDG. <u>3 or 4</u> NUMBER OF BEDROOMS _____		
IF NOT SINGLE RESIDENCE DESCRIBE _____		
SIGNATURE OF APPLICANT <u>Ben Catchings & Loris S. Catchings</u>		
APPROVED BY <u>Raymond Hodges</u> FOR <u>Dry Well</u> DATE <u>10 April 67</u>		
REJECTED BY _____ FOR _____ DATE _____		
HOLD PENDING FURTHER TESTS <u>Bill</u> DATE <u>6/16/66</u>		
REASONS FOR REJECTION OR HOLDING <u>11 April 67 Final Plat is OK.</u>		

THIS IS NOT A PERMIT

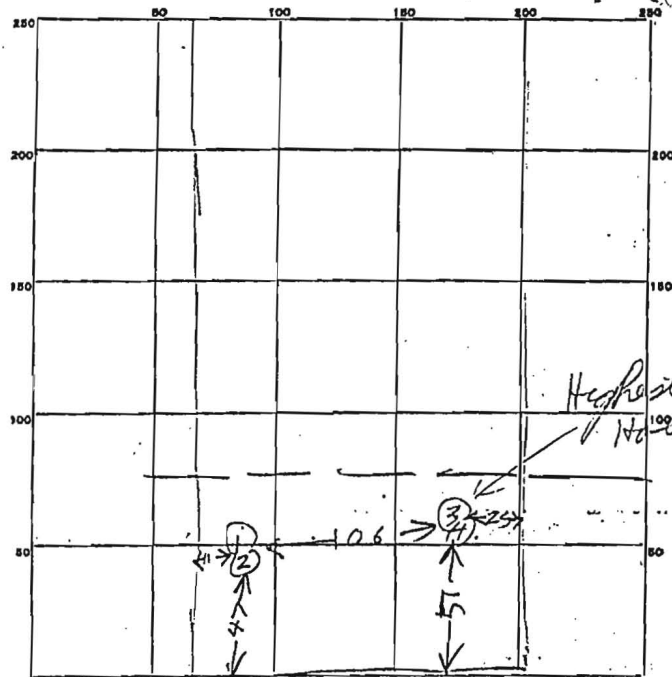

INDICATE NORTH - NAME ADJOINING ROADWAY AS BASE LINE.

TAYLOR PARK RD

DATE	TEST NO.	DEPTH	PRE-WET		TEST - 1" DROP		TIME
			START	STOP	START	STOP	
6/22/66	1	5 1/2	228	231	231	235	4
6/22/66	2	9 1/2	236	238	238	241	3
6/22/66	3	5 1/2	246	247	247	249	2
6/22/66	4	9 1/2	249	250	250	255	5

4 MIN.
LOT SIZE

4 MIN
PW SIZE

SOIL AUGER FINDING

TESTED BY

R. Hodges

REMARKS

43

