

PUB. SEWER STATUS VERIFIED BY \_\_\_\_\_

ISSUE DATE: 2/7/06

APPROVAL DATE: 5/9/06

**PERMIT**

**INDEXED**

TAX ID # 03-302261

**ON-SITE SEWAGE DISPOSAL SYSTEM  
HOWARD COUNTY HEALTH DEPARTMENT  
BUREAU OF ENVIRONMENTAL HEALTH**

P 524049

A REPAIR 522007-A

FYOCK SEPTIC SERVICE

IS PERMITTED TO INSTALL ☐ ALTER ☒

ADDRESS: \_\_\_\_\_ PHONE NUMBER: 410-988-9270

SUBDIVISION: Triadelphia Farm II LOT NUMBER: 12-A

ADDRESS: 13364 Triadelphia Road PROPERTY OWNER: David Stratmann

SEPTIC TANK CAPACITY (GALLONS): 1500 2-Comp. Trenches 3' Wide

PUMP CHAMBER CAPACITY (GALLONS): N/A

NUMBER OF BEDROOMS: 4

SQUARE FEET PER BEDROOM: 210

LINEAR FEET OF TRENCH REQUIRED: 200

Inlet 4'  
Bottom 5'  
1' Stone Below Pipe  
3- (60'-75' Trenches)

TRENCHES:	Trench to be _____ feet wide. Inlet _____ feet below original grade. Bottom maximum depth _____ feet below original grade. Effective area begins at _____ feet below original grade. _____ feet of stone below distribution pipe.
LOCATION:	
PURPOSE:	Existing septic system has failed. Call for inspection when ground is opened so sanitarian can recommend repair.

PLANS APPROVED: \_\_\_\_\_ DATE: \_\_\_\_\_

NOTE: PERMIT VOID AFTER 2 YEARS

NOTE: CONTRACTOR RESPONSIBLE FOR SCHEDULING A PRE-CONSTRUCTION INSPECTION FOR ALL INSTALLATIONS

NOTE: WATERTIGHT SEPTIC TANKS REQUIRED


NOTE: ALL PARTS OF SEPTIC SYSTEM SHALL BE 100 FEET FROM ANY WATER WELL

NOTE: MANHOLE RISERS REQUIRED ON ALL SEPTIC TANKS AND PUMP CHAMBERS

**NEITHER THE HOWARD COUNTY COUNCIL OR THE HEALTH DEPARTMENT IS  
RESPONSIBLE FOR THE SUCCESSFUL OPERATION OF ANY SYSTEM  
PERMITTEE RESPONSIBLE FOR OBTAINING FINAL APPROVAL ON THIS PERMIT  
CALL 410-313-2640 FOR INSPECTION OF SEPTIC SYSTEM**

522007-A

NOT TO SCALE

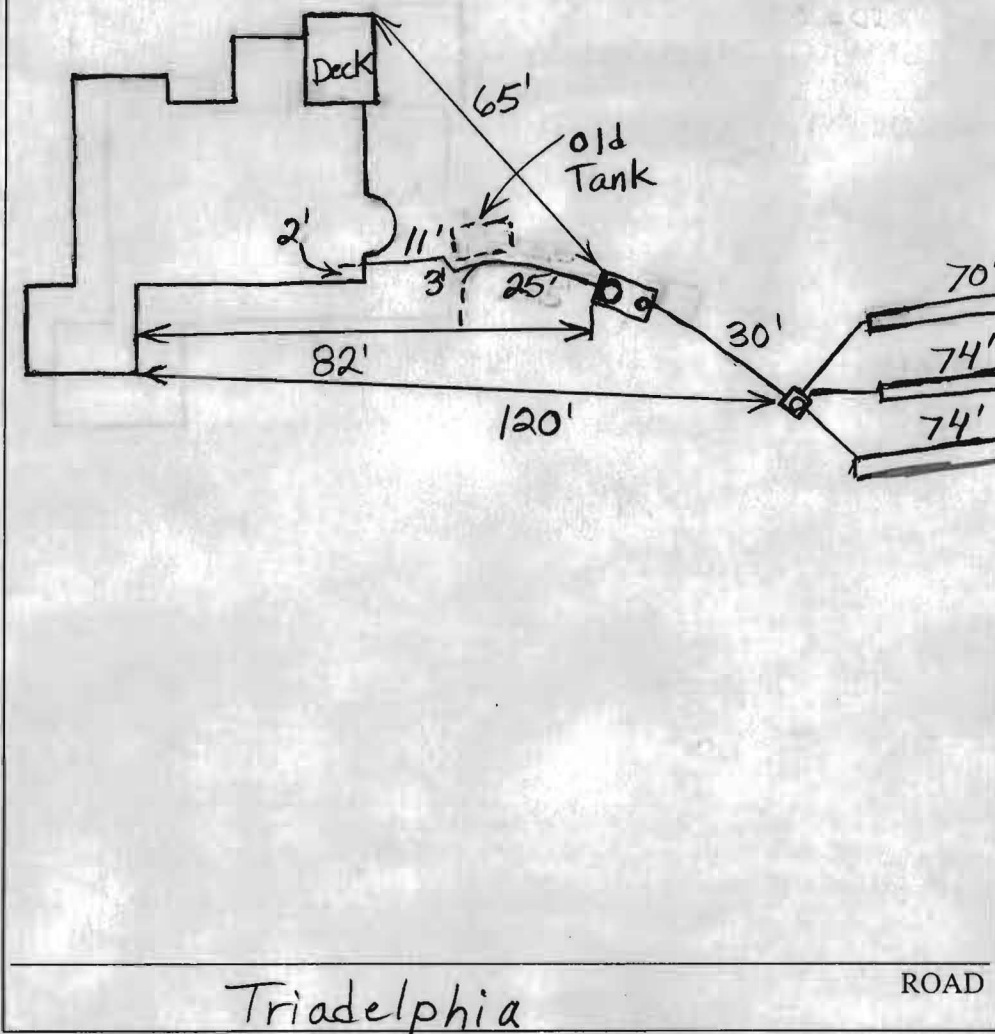

TRENCH/DRAINFIELD DATA		
WIDTH	INLET	BOTTOM
3'	4'	5'
NUMBER OF TRENCHES		3
TOTAL LENGTH		218'
ABSORPTION AREA		654
DISTRIBUTION BOX LEVEL		Levelers
DISTRIBUTION BOX BAFFLE		Yes
DISTRIBUTION BOX PORT		Yes

SEPTIC TANK DATA	
SEPTIC TANK 1 LEVEL	Yes
CAPACITY	1500 GAL
SEAM LOC	Top
TANK LID DEPTH	1'
BAFFLES	Yes
BAFFLE FILTER	No
MANHOLE LOC	Front
6" PORT LOC	Rear
WATERTIGHT TEST	No
SEPTIC TANK 2 LEVEL	N/A
CAPACITY	GAL
SEAM LOC	
TANK LID DEPTH	
BAFFLES	
BAFFLE FILTER	
MANHOLE LOC	
6" PORT LOC	
WATERTIGHT TEST	

PRE-CONSTRUCTION 5/2/06 Met with contractor. To install 3 - 67' trenches with the top trench being where the perc test holes are.

INSTALLATION Keep the septic tank 100' from the homeowner's well (BB)

5/9/06 Installer put in septic tank < 100' from homeowner's well but farther away than old metal tank. Old metal tank pumped out and filled in. Disconnected old trench system that was in proximity of new tank. (BB)

FINAL INSPECTOR B. Baker

DATE OF APPROVAL 5/9/06