


DEPARTMENT OF INSPECTIONS, LICENSES AND PERMITS 3400 COUNTY HOUSE DRIVE ELLCOTT CITY, MD 21043 PERMITS (410) 313-2455 INSPECTIONS (410) 313-1610 AUTOMATED INFORMATION (410) 313-3600		HOWARD COUNTY PERMIT APPLICATION		PERMIT NUMBER B-00150426XN	
Building Address <u>13004 Twelve Hills Rd</u> <u>CLARKSVILLE, MD 21029</u>			Property Owner's Name <u>PATAPSCO HOMES INC</u>		
Suite/Apt. #: _____ SDP/WP/Petition #: _____			Address <u>13898 FORSYTHE RD</u>		
Census Tract <u>005101</u> Subdivision <u>Twelve Hills</u>			City <u>Sykesville</u> State <u>MD</u> Zip Code <u>21784</u>		
Section <u>2</u> Area _____ Lot <u>24</u>			Home Phone <u>410 442 2101</u> Work Phone _____		
Tax Map <u>28</u> Parcel <u>381</u> Grid <u>16</u>			Applicant's Name & Mailing Address, (if other than stated hereon): _____		
Zoning <u>RRD</u> Map Coordinates <u>14A3</u> Lot size <u>3.157 ac</u>			Phone <u>410-442-2421</u> Fax _____		
Existing Use <u>Lot</u>			Contractor Company <u>PATAPSCO HOMES, INC</u>		
Proposed Use <u>Residential</u>			Contact Person <u>DANIEL RICKER</u>		
Estimated Construction Cost \$ <u>100,000</u>			Address <u>13898 FORSYTHE RD</u>		
Description of Work <u>Construct a large family</u> <u>room addition on existing house</u>			City <u>Sykesville</u> State <u>MD</u> Zip Code <u>21784</u>		
Occupant or Tenant _____			License No. <u>1213</u>		
Contact Name _____			Phone <u>410-442-2421</u> Fax <u>410-489-0319</u>		
Address _____			Engineer or Architect Company <u>DRS LLC</u>		
City _____ State _____ Zip Code _____			Contact Person <u>Dan</u>		
Phone _____ Fax _____			Address <u>13898 Rd</u>		
			City <u>Sykesville</u> State <u>MD</u> Zip Code <u>21784</u>		
			Phone <u>410 848 9000</u> Fax _____		
BUILDING DESCRIPTION - <u>COMMERCIAL</u>			BUILDING DESCRIPTION - <u>RESIDENTIAL</u>		
Building Characteristics		Utilities	Building Characteristics		Utilities
Height: _____		Water Supply: _____ Public _____ Private _____	SF Dwelling ☒ SF Townhouse ☐		Water Supply: _____ Public _____ Private ☒
No. of stories: _____		Sewage Disposal: _____ Public _____ Private _____	1st floor: _____ 2nd floor: _____ Basement: _____		Sewage Disposal: _____ Public _____ Private ☒
Gross area, sq. ft. per floor: _____		Electric Yes ☐ No ☐ Gas Yes ☐ No ☐	Finished Basement ☐ Unfinished Basement ☒ Crawl space ☐ Slab on Grade ☐ No. of Bedrooms <u>4</u>		Electric Yes ☒ No ☐ Gas Yes ☐ No ☐
Use group: _____		Heating System: _____ Electric ☐ Oil ☐ Natural Gas ☐ Propane Gas ☐	Multi-family dwellings: No. of efficiency units: _____ No. of 1 BR units: _____ No. of 2 BR units: _____ No. of 3 BR units: _____		Heating System: _____ Electric ☐ Oil ☐ Natural Gas ☐ Propane Gas ☒
Construction type: _____ Reinforced Concrete _____ Structural Steel _____ Masonry _____ Wood Frame _____		Sprinkler system: N/A ☐ Full _____ Partial _____ Other Suppression _____ # of Heads _____	Other Structure: _____ Dimensions: _____ Footings: _____ Roof: _____		Sprinkler system: N/A ☐ NFPA #13D _____ NFPA #13R _____ Other: _____
State Certified Modular _____			State Certified Modular _____ Manufactured Home _____		

THE UNDERSIGNED HEREBY CERTIFIES AND AGREES AS FOLLOWS: (1) THAT HE/SHE IS AUTHORIZED TO MAKE THIS APPLICATION, (2) THAT THE INFORMATION IS CORRECT, (3) THAT HE/SHE WILL COMPLY WITH ALL REGULATIONS OF HOWARD COUNTY WHICH ARE APPLICABLE THEREIN, (4) THAT HE/SHE WILL PERFORM NO WORK ON THE ABOVE REFERENCED PROPERTY NOT SPECIFICALLY DESCRIBED IN THIS APPLICATION, (5) THAT HE/SHE GRANTS COUNTY OFFICIALS THE RIGHT TO ENTER ONTO THE PROPERTY FOR THE PURPOSE OF INSPECTING THE WORK PERMITTED AND POSTING NOTICES.


<u>Daniel Ricker</u> Applicant's Signature	<u>Daniel Ricker</u> Print Name
<u>13898 Forsythe Rd</u> Title/Company	<u>1/16/04</u> Date

Checks payable to: **DIRECTOR OF FINANCE OF HOWARD COUNTY**
** PLEASE WRITE NEATLY AND LEGIBLY. **
FOR OFFICE USE ONLY

AGENCY	DATE	SIGNATURE APPROVAL	DPZ SETBACK INFORMATION	PROPERTY ID#
Land Development, DPZ			Front: _____	<u>63470</u>
State Highway			Rear: _____	Filing fee: \$ <u>100</u>
Building Official			Side: _____	Permit fee: \$ _____
Dev. Engineering, DPZ			Side Set: _____	Excise tax: \$ _____
Health	<u>1/16/04</u>	<u>Kacie Noman</u>	All minimum setbacks met? YES ☐ NO ☐	Add'l per. fee: \$ _____
Fire Protection			Is Entrance Permit required? YES ☐ NO ☐	TOTAL FEES: \$ _____
Is Sediment Control approval required prior to issuance?			Historic District? YES ☐ NO ☐	Sub-total paid: \$ _____
YES ☒ NO ☐			Lot Coverage for New Town Zone: _____	Balance due: \$ _____
CONTINGENCY CONSTRUCTION START: ☐			SDP/Red line approval date: _____	Check: <u>15137</u>
ONE STOP SHOP: ☐				Validation: <u>76351</u>
				Accepted by: <u>DR</u>

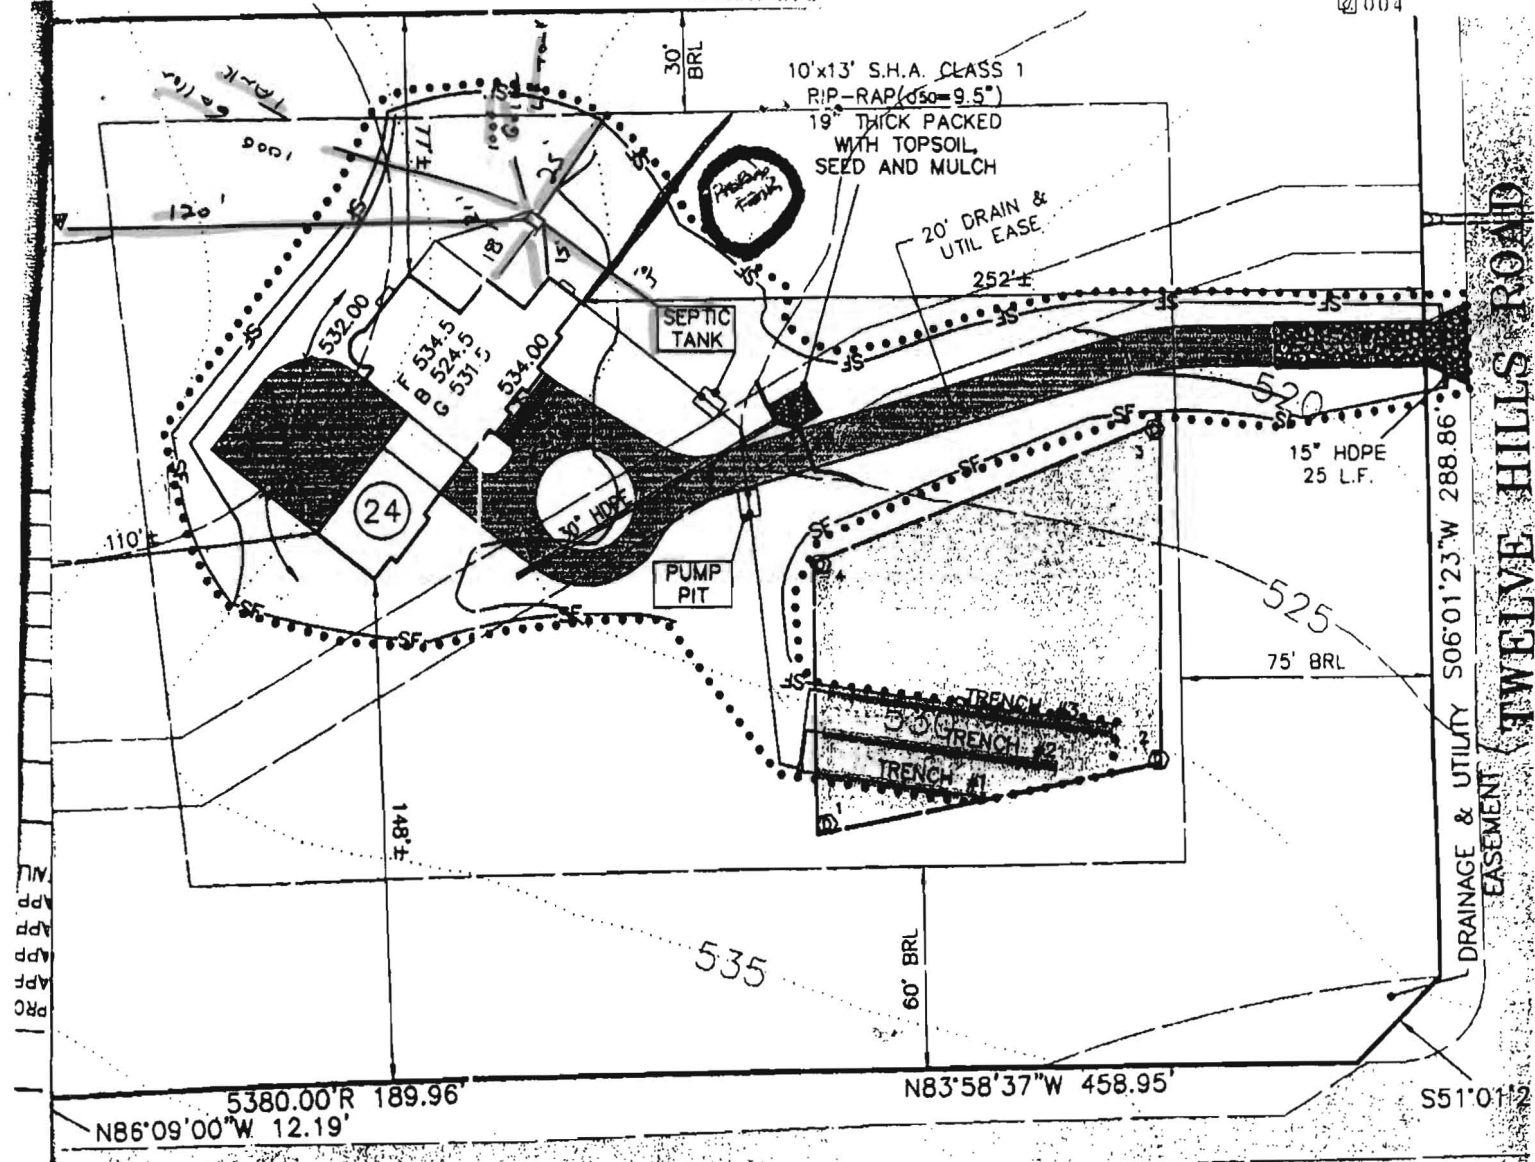

LINDEN CHURCH ROAD

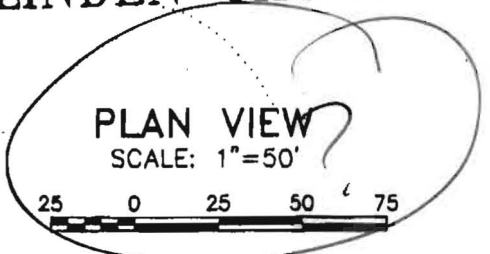

8/9/05 800/55259
LP acc obviously
OK B155254 OK
(KN)

DEVELOPER'S CERTIFICATION

/we certify that all development and construction will be done according to this plan and that any responsible personnel involved in the construction project will have a certificate of attendance at a Department of the Environment approved training program for the control of sediment and erosion before beginning the project. also authorize periodic on-site inspection by the Howard Soil Conservation District.

Signature of Developer

Date

ENGINEER'S CERTIFICATE

"I hereby certify that this plan for erosion and sediment represents a practical and workable plan based on my pers knowledge of the site conditions and that it was prepared i accordance with the requirements of the Howard Soil Conse District."

Drum R. Long
ENGINEER

2005-017
Date