

APPLICATION

PERCOLATION TESTING

A A 38587

HOWARD COUNTY HEALTH DEPARTMENT
BUREAU OF ENVIRONMENTAL HEALTH
P.O. BOX 476 ELLICOTT CITY MARYLAND 21043
TELEPHONE 461-9933

P _____

DISTRICT 5

DATE 12/17/86

TO: THE COUNTY HEALTH OFFICER
ELLICOTT CITY, MARYLAND

I, HEREBY, APPLY FOR THE NECESSARY TEST IN ORDER TO CONSTRUCT (OR RECONSTRUCT) A SEWAGE DISPOSAL SYSTEM

PROPERTY OWNER Altogether Limited Partnership

ADDRESS 10176 Baltimore National Pike Suite 212 PHONE 465-5855

PROSPECTIVE BUYER _____

ADDRESS _____ PHONE _____

PROPERTY LOCATION:

SUBDIVISION Altogether LOT NO. 32

ROAD AND DESCRIPTION Linden Church Rd + Rt 32

TAX MAP 28 PARCEL # 66

SIZE OF LOT 3 acres TYPE BLDG SFD
(SINGLE FAMILY DWELLING OR COMMERCIAL)

THE SYSTEM INSTALLED UNDER THIS APPLICATION IS ACCEPTABLE ONLY UNTIL PUBLIC FACILITIES BECOME AVAILABLE. I FULLY UNDERSTAND THE

FEE CONNECTED WITH THE FILING OF THIS PERC TEST APPLICATION IS NON-REFUNDABLE UNDER ANY CIRCUMSTANCES. I ALSO AGREE TO COMPLY

WITH ALL M.O.S.H.A. REQUIREMENTS IN TESTING THIS LOT

Mark A. Reil
(SIGNATURE OF APPLICANT)

APPROVED BY Raymond Hodge FOR Trenches Shallow DATE 1/27/88

REJECTED BY _____ FOR _____ DATE _____

HOLD PENDING FURTHER TESTS _____ DATE _____

REASONS FOR REJECTION OR HOLDING 1/29/87. Wet Season or Change Area R/H

2-4-87 Shallow Syst. only hold for PLAT. S&B

THIS IS NOT A PERMIT


LT 32

SOIL PROFILE

0
3
13
BROWN CLAY
PINKISH BROWN SAND LOAM

3
BROWN Y CHA
DARK BROWN SAND LOAM

12 1/2
WATER
CLAY
DARK BROWN SAND LOAM
13 1/2
WATER

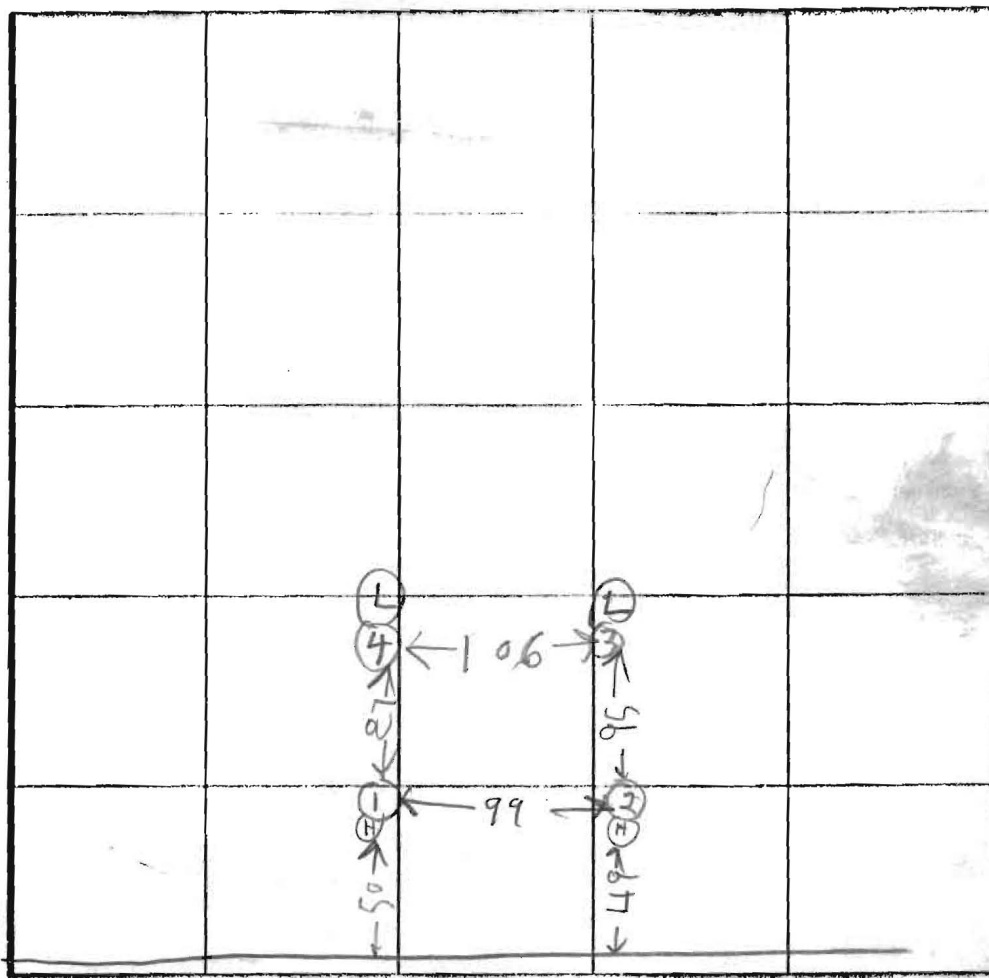

21 = HIGH
34 = LOW

X Perc 4min
180 #/BC
INLET 4
BOTTOM 5.5

INDICATE NORTH - NAME ADJOINING ROADWAY AS BASE LINE

DATE	TEST NO	DEPTH	PRE NET		TEST - 1" DROP		TIME
			START	STOP	START	STOP	
1/29/87	15	5.5	109	110	110	114	4
1/29/87	16	9	110	111	111	113	2
1/29/87	17	13	OK				
1/29/87	25	6	116	118	118	122	4
1/29/87	26	13	OK				
1/29/87	35	4	123	127	127	134	4
1/29/87	36	12 1/2	WATER	12 FT			
1/29/87	45	5.5	132	134	134	137	3
1/29/87	4	14.5	WATER	13 FT			

around
3min
max
depth
3 FT

REMARKS snow Holes dug different from Sketch Plan of Dec 87

TYPE OF SOIL

TESTED BY

R HODGES

ALSO PRESENT

OKETTE PM

DRS & ASSOCIATES
LAND DESIGN CONSULTANTS



(7)

TWELVE HILLS ROAD

LEGEND

- ⊙ CLEANOUT
- ⊠ WATER VALVE
- ⊠ PH. BOX
- ⊠ ELEC. BOX
- ⊠ CATV
- PROP. COR. NOT SET
- PROP. COR. SET/FOUND

(23)

S83°58'37"E 458.95'

30' BRL

76'±

(24)

3.187Ac.

**TWELVE HILLS
SECTION TWO
LOTS 7 - 24**

HO-94-0394

60' BRL

130'±

SEE HOUSE DETAIL SH2
FF 536.49

148'±

20' DRAIN. & UTIL. EASE.

5380.00'R 189.96'

22' PAV

S83°58'37"E 198.43'

60' BRL

DRAIN. & UTIL. EASE.

75' BRL

S06°01'23"W 288.86'

15" HDPE

232'±

16

011

S51°31'23"W
335.36'

LINDEN CHURCH ROAD

N86°00'00"

100 YEAR FLOOD PLAIN TABULATION

LOT NO.	AREA
LOT 8	0.001 AC.
LOT 9	0.383 AC.
LOT 10	0.073 AC.
LOT 12	0.073 AC.
LOT 13	0.119 AC.
LOT 14	0.537 AC.
TOTAL	1.186 AC.

AREA TABULATION FOR ALL SHEETS

TOTAL NUMBER OF BUILDABLE LOTS TO BE RECORDED	18
TOTAL AREA OF BUILDABLE LOTS	57.252 AC.±
TOTAL AREA OF ROAD DEDICATION TO BE RECORDED	0.507 AC.±
TOTAL AREA OF ROAD R/W TO BE RECORDED	2.724 AC.±
TOTAL AREA OF 100 YEAR FLOODPLAIN	1.186 AC.±
TOTAL AREA OF SUBDIVISION TO BE RECORDED	60.483 AC.±

AREA TABULATION - SHEET 1 OF 2

TOTAL NUMBER OF LOTS TO BE RECORDED	7
TOTAL AREA OF LOTS	21.356 AC.±
TOTAL AREA OF ROADWAY TO BE RECORDED	1.166 AC.±
TOTAL AREA OF ROADWAY DEDICATION	0.507 AC.±
TOTAL AREA OF 100 YEAR FLOODPLAIN	0.384 AC.±
TOTAL AREA TO BE RECORDED	23.029 AC.±

APPROVED: FOR PRIVATE WATER AND PRIVATE SEWERAGE
SYSTEMS, HOWARD COUNTY HEALTH
DEPARTMENT.

Jorge M. Boyles 11-25-87
HOWARD COUNTY HEALTH OFFICER DATE


APPROVED: HOWARD COUNTY OFFICE OF PLANNING AND
ZONING

Chapman 12.10.87
DIRECTOR DATE

APPROVED: FOR STORM DRAINAGE SYSTEMS, AND PUBLIC
ROADS.
HOWARD COUNTY DEPARTMENT OF PUBLIC
WORKS.

James M. ... 11/1/87
DATE

PROPERTY OF
HUGH B. MILLER
& ELEANOR
JANE MILL
565/540

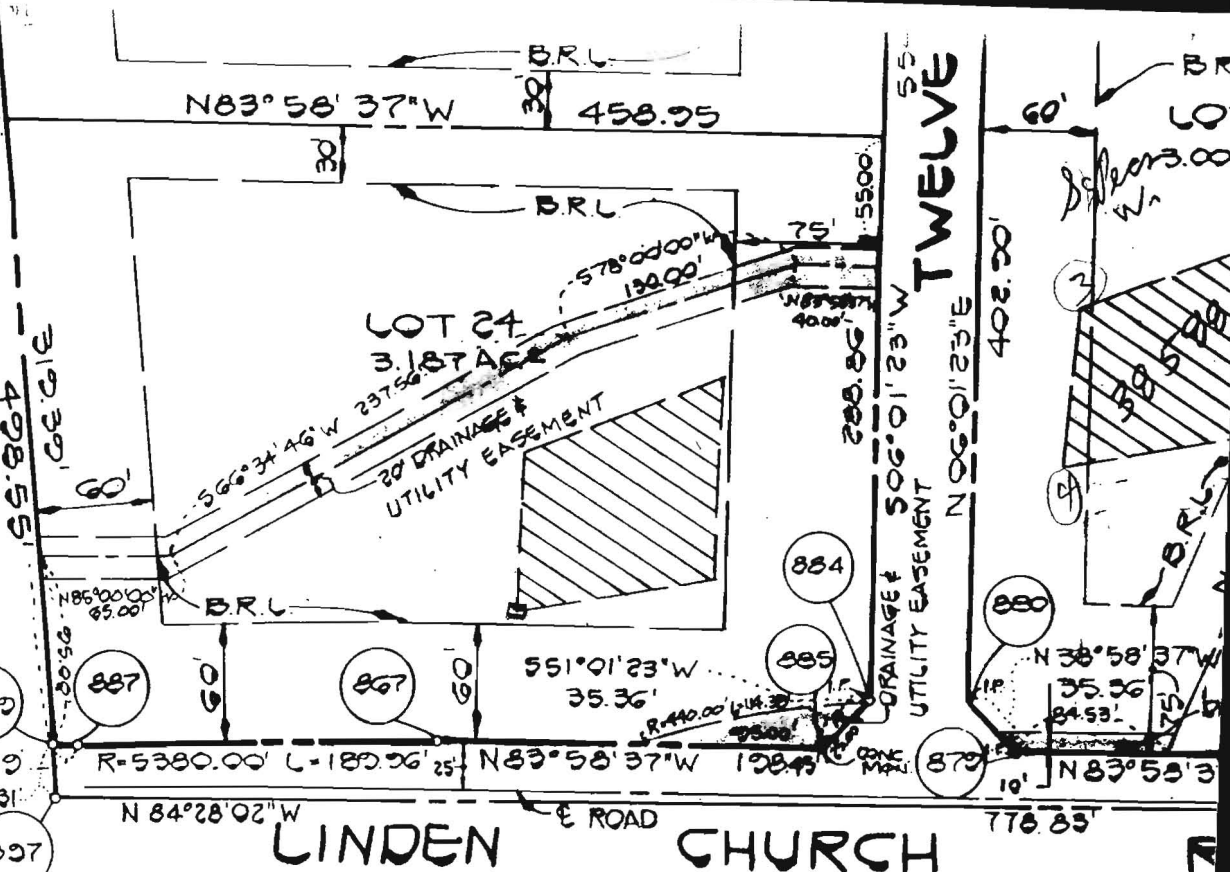

LAND DEDICATED
COUNTY FOR THE
A PUBLIC ROAD.

OWNER'S CERTIFICATE:

WE, ALTOGETHER LIMITED PARTNERSHIP, A MARYLAND LIMITED PARTNER
OWNER OF THE PROPERTY SHOWN AND DESCRIBED HEREON, HEREBY ADOPT
OF SUBDIVISION, AND IN CONSIDERATION OF THE APPROVAL OF THE FINAL
THE OFFICE OF PLANNING AND ZONING, ESTABLISH THE MINIMUM
RESTRICTION LINES AND GRANT UNTO HOWARD COUNTY, MARYLAND, ITS S
AND ASSIGNS, (1) THE RIGHT TO LAY, CONSTRUCT AND MAINTAIN SEWE
DRAINS, WATER PIPES AND OTHER MUNICIPAL UTILITIES AND SERVICE
UNDER ALL ROAD OR STREET RIGHTS-OF-WAY AND THE SPECIFIC EASEM
SHOWN HEREON, (2) THE RIGHT TO REQUIRE DEDICATION FOR PUBLIC USE
OF THE STREETS AND/OR ROADS AND FLOODPLAINS AND OPEN SPA
APPLICABLE AND FOR GOOD AND OTHER VALUABLE CONSIDERATION, HER
THE RIGHT AND OPTION TO HOWARD COUNTY TO ACQUIRE THE FEE SIMPLE
THE BEDS OF THE STREETS AND/OR ROADS AND FLOODPLAINS, STORM
FACILITIES AND OPEN SPACE WHERE APPLICABLE; (3) THE RIGHT T
DEDICATION OF WATERWAYS AND DRAINAGE EASEMENTS FOR THE SPECIFI
OF THEIR CONSTRUCTION, REPAIR AND MAINTENANCE; AND (4) THAT NO
OR SIMILAR STRUCTURE OF ANY KIND SHALL BE ERCTED ON OR OVER
EASEMENTS AND RIGHTS-OF-WAY. WITNESS OUR HANDS THIS 14 DAY OF
1987.

Jack H. Pechter
JACK H. PECHTER-GENERAL PARTNER

Beverly J. ...
WITNESS

Copy of
Signed
Final
F88-05