

12/23/76
Around 10:30 A.M.

PERMIT

SEWAGE DISPOSAL SYSTEM

MARYLAND STATE DEPARTMENT OF HEALTH

HOWARD COUNTY

ELLICOTT CITY

DISTRICT 3rd

DATE 10/1/76

Approved
HB
12-23-76
INDEXED

Roland Barth

IS PERMITTED TO INSTALL ☒ ALTER

ADDRESS Clarksville Pike, Ellicott City, Md. 21043 PHONE 730-8495

A SEWAGE DISPOSAL SYSTEM LOCATED AT

SUBDIVISION Eagles Loft ROAD Williamfield Drive LOT 24

PROPERTY OWNER New Homes, Inc. Wayne Newsome (516-9217)

ADDRESS 6655 H Dobbin Road, Columbia, Maryland 21044

SPECIFICATIONS 3 bedrooms

DRAIN FIELD DEPTH FEET, BOTTOM AREA SQ. FT.

SEEPAGE PITS ABSORBENT SIDE-WALL AREA SQ. FT.

SEPTIC TANK CAPACITY 1000 GALLONS

FOR GARBAGE GRINDER, INCREASE DISPOSAL AREA 22% & TANK CAPACITY 50%.

OTHER DRY WELL AND TRENCH - Dry well to have 250 sq. ft. effective sidewall area. Inlet at 4 ft. and maximum depth 10 1/2 ft. Locate dry well 100 ft. from left lot line and 75 ft. from edge of Williamfield, as seen when facing lot from Williamfield Drive. Trench to be 20 ft. long, inlet at 4 ft., maximum depth 10 1/2 ft. for a sidewall area of 130 sq. ft. Run trench off right side of dry well, toward center of front lot line, as seen when facing lot from Williamfield Drive. Keep trench on level contour. CALL FOR INSPECTION OF TRENCH BEFORE PLACING STONE IN TRENCH.

NOTE: ALL PIPE FROM HOUSE TO DISPOSAL AREA MUST BE CAST IRON. PERMIT VOID AFTER THREE YEARS. NOTE: INSTALL STAND PIPE ON SEPTIC TANK AND DRY WELL. STAND PIPES MUST BE 6 INCHES IN DIAMETER. CAST IRON, CONCRETE OR TERRA COTTA ACCEPTED.

PLANS APPROVED BY William W. Zepp & D. W. Monaghan DATE 2/18/76 & 9/15/76

FILL SEPTIC TANK AND DISTRIBUTION BOX WITH WATER BEFORE CALLING FOR AN INSPECTION. COVER NO WORK UNTIL INSPECTED AND APPROVED.

NEITHER THE HOWARD COUNTY COMMISSIONERS NOR THE HEALTH DEPARTMENT IS RESPONSIBLE FOR THE SUCCESSFUL OPERATION OF ANY SYSTEM.

BLDG. PERMIT SIGNED AND RETURNED 12/1/76

BLDG. PERMIT SIGNED AND RETURNED 5/13/81


Serial # 57083 -

Serial # 46343

Barry - No Comments

DATE SYSTEM APPROVED 12/1/76

18313

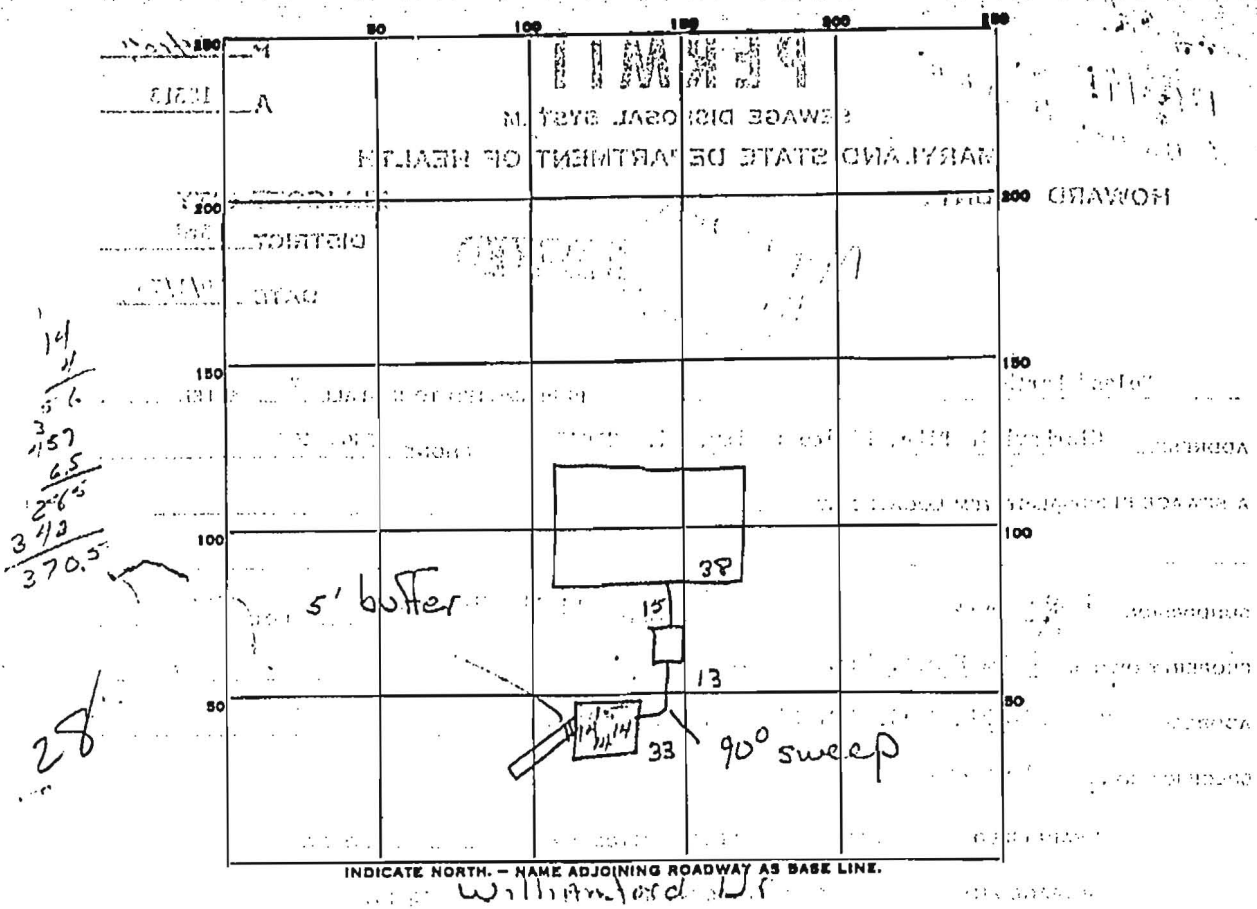

PERMIT CARD _____

SEPTIC TANK, LEVEL _____ CLEANOUTS _____

DISTRIBUTION BOX, LEVEL _____

TILE FIELD, DEPTH 10 1/2 FT. TRENCH WIDTH 2 FT.

GRAVEL DEPTH 6 IN. TOTAL LENGTH 20 FT.

NUMBER OF TRENCHES 1 TOTAL BOTTOM AREA 120 one side

SEEPAGE PITS, INSIDE DIAMETER Perimeter 57 FT. DEPTH BELOW INLET 6 1/2 FT. OW-370.5

TOTAL ABSORBENT AREA 490 SQ. FT.

REMARKS Location OK

DATE SYSTEM APPROVED 12-27-76 INSPECTOR hal kenschen