

11/28/88 PM

File 04-329104

# PERMIT

SEWAGE DISPOSAL SYSTEM

MARYLAND STATE DEPARTMENT OF HEALTH DISTRICT

HOWARD COUNTY  
BUREAU OF ENVIRONMENTAL HEALTH  
461-9933

P 4/3/14

A REPAIR

DATE 11/28/88

DATE SYSTEM APPROVED 11/28/88

INSPECTOR C.K.S.

INDEXED

Herman Sirk

IS PERMITTED TO INSTALL ALTER X

ADDRESS 2555 Jennings Chapel Road, Woodbine, Maryland 21797 PHONE 489-4724

SUBDIVISION ROAD 14040 Triadelphia Rd LOT

PROPERTY OWNER McCracken

ADDRESS

IF GARBAGE GRINDER IS USED INCREASE SEPTIC TANK CAPACITY BY 50% AND ABSORPTION AREA BY 22%.

GARBAGE GRINDER? YES NO

SEPTIC TANK CAPACITY GALLONS NUMBER OF BEDROOMS

REPAIR - CALL FOR INSPECTION WHEN GROUND IS OPENED UP SO SANITARIAN CAN RECOMMEND REPAIR.

11/28 See trench repair on back.  
C.K.S.

PLANS APPROVED BY C. Williams DATE 11/28/88

COVER NO WORK UNTIL INSPECTED AND APPROVED

NEITHER THE HOWARD COUNTY COUNCIL NOR THE HEALTH DEPARTMENT IS RESPONSIBLE FOR THE SUCCESSFUL OPERATION OF ANY SYSTEM

NOTE: CLEANOUT REQUIRED EVERY 70 FEET OF SEWER LINE AND/OR AT 90° SWEEPS IN LINES FROM HOUSE TO DRAIN FIELDS

NOTE: ALL PARTS OF SEPTIC SYSTEMS (I.E., TANK, DISTRIBUTION BOX, TRENCHES) TO BE 100 FEET FROM WELL (UNLESS OTHERWISE SPECIFICALLY AUTHORIZED)

NOTE: IF DEEP TRENCH(ES) ARE USED CALL FOR INSPECTION BEFORE AND AFTER PLACING GRAVEL IN TRENCH(ES)

NOTE: NO DRY WELL SHALL EXCEED 15 FOOT IN DIAMETER NO ABSORPTION TRENCH TO EXCEED 100 FEET IN LENGTH

NOTE: ALL PIPE FROM HOUSE TO SEPTIC TANK MUST BE CAST IRON OR SCHEDULE 40 PVC OR ABS


PERMIT VOID AFTER TWO YEARS

NOTE: INSTALL STAND PIPE ON SEPTIC TANK AND DRY WELL STAND PIPES MUST BE 6 INCHES IN DIAMETER CAST IRON, CONCRETE OR TERRA COTTA OR PVC OR ABS ACCEPTED. IF TOP OF SEPTIC TANK IS DEEPER THAN 3 FEET, MANHOLE TO GRADE REQUIRED

NOTE: DISTRIBUTION BOXES MUST HAVE BAFFLES

\*INSTALLER IS RESPONSIBLE FOR OBTAINING FINAL APPROVAL ON THIS PERMIT

\*CALL 461-9933 FOR INSPECTION OF SEPTIC SYSTEMS.

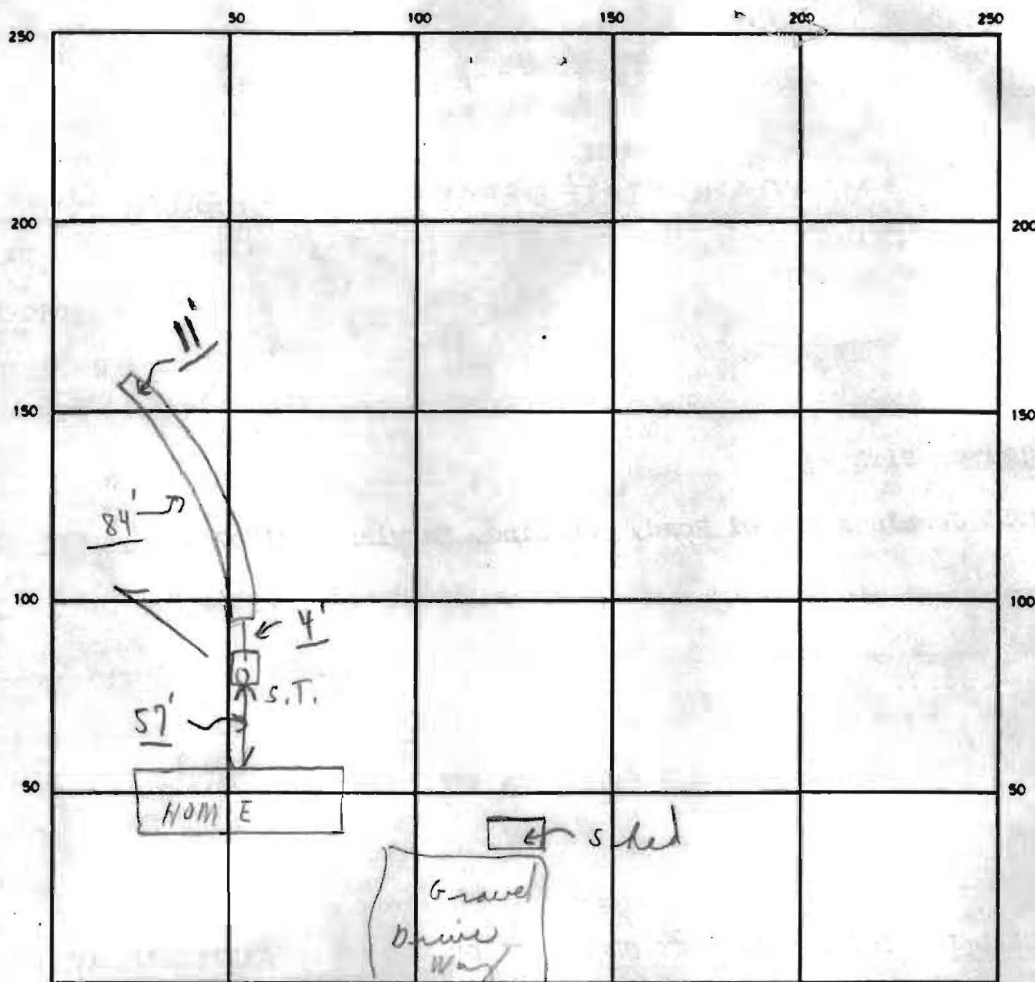

INDICATE NORTH - NAME ADJOINING ROADWAY AS BASE LINE  
 Triadelphia Road Glennely

SEPTIC TANK. LEVEL N/A CLEANOUTS S.T. ↓ to be capped

DISTRIBUTION BOX. LEVEL N/A

DRAIN FIELD/TILE FIELD. DEPTH 11 FT. TRENCH WIDTH 2 FT. INLET DEPTH 3 1/2 FT.

EFFECTIVE GRAVEL DEPTH 7 1/2 FT. TOTAL LENGTH 84 FT.


NUMBER OF TRENCHES 1 ONE SIDEWALL/BOTTOM-AREA 630 SQ. FT.

DRYWELL INSIDE DIAMETER        FT. EFFECTIVE DEPTH BELOW INLET        FT.

ABSORBENT AREA 630 SQ. FT.

REMARKS 11/28/88 Repair at rear of home C.B.A. Trench  
almost complete. Sanitarian spoke to contractor Mr.  
Uick - ok to complete rest of trench. File.  
C.B.A.

DATE SYSTEM APPROVED 11/28/88 INSPECTOR Charles Bryan Steaker

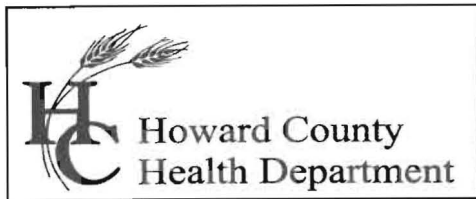

Bureau of Environmental Health  
7178 Columbia Gateway Drive, Columbia, MD 21046  
(410) 313-2640 Fax (410) 313-2648  
TDD (410) 313-2323 Toll Free 1-866-313-6300  
website: [www.hchealth.org](http://www.hchealth.org)


---

Peter L. Beilenson, M.D., M.P.H., Health Officer

April 16, 2007

**MEMORANDUM**

TO: Mike Johnson  
Associated Excavators Contractors  
16657 Frederick Road  
Mt. Airy, Maryland 21771  
Faxed to 410-442-0100

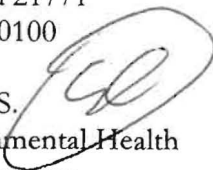FROM: Stuart F. Oster, R.S.   
Bureau of Environmental Health  
Well and Septic Program


RE: 14040 Triadelphia Road  
1.628 Ac. - Glenelg  
Map 21, Grid 18, Parcel 50  
(Demolition of Existing House – Replacement house finished)

This is to advise that the Howard County Health Department recommends issuance of the demolition permit for the existing house (to be razed) at the above referenced property.

The existing well (HO-92-0120) was reused and a new septic system was established and installed. If any other wells or septic systems are found during site work, please notify this office immediately.

C: Gary McCracken, 14040 Triadelphia Rd, Glenelg, MD. 21737  
Suzanne Davis, Williamsburg Group, Faxed to 410-997-4358  
File



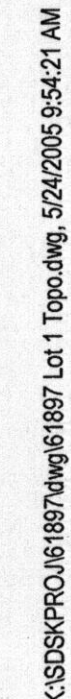

**TOPO WORKSHEET**  
**GARY G. MCCracken**  
 Tax Map: 21    Grid: 18    Parcel: 50  
 Fourth Election District  
 Howard County, Maryland

0'      30'      60'      120'

Scale: 1" = 30'

Date: September 18, 2004  
 Sheet 1 Of 1