


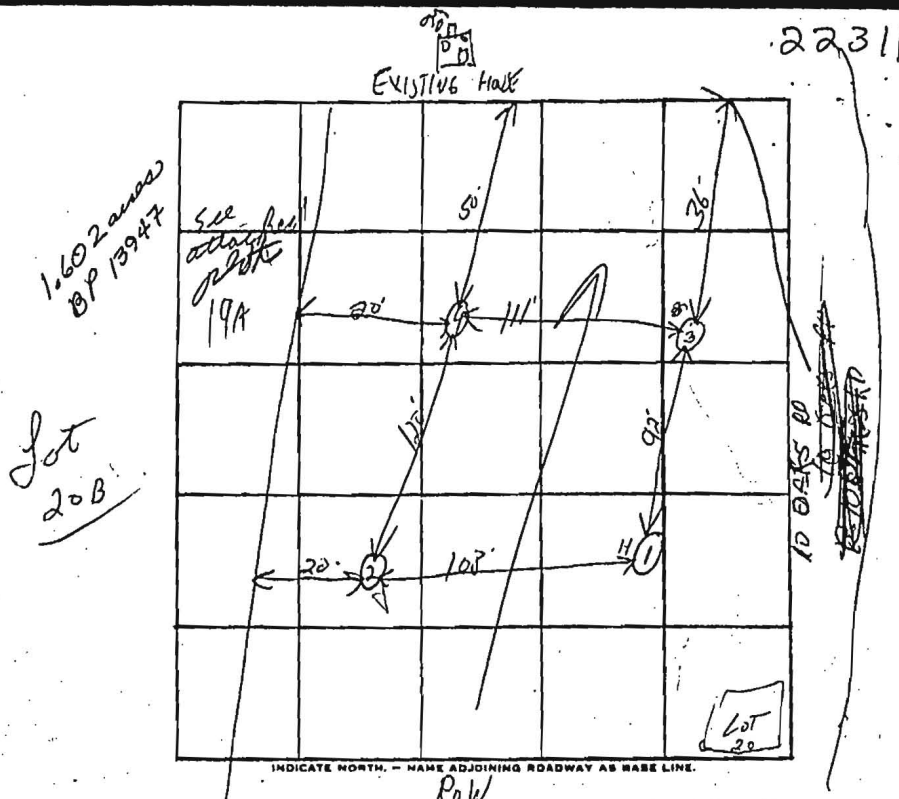

DATE	TEST NO.	DEPTH	PRE-WET		TEST - 1" DROP		TIME
			START	STOP	START	STOP	
11-5-75	1s	4'	1220	1223	1123	1135	12
↑	10	12'	1220	1223	1223	1135	12
	2	11'	1130	600	500	500	3'
	3s	5'	1225	1231	1231	1237	6
	3n	11 1/2'	1225	1238	1228	1238	10
	4s	5'	1240	1242	1242	1245	3
	4n	12'	1240	1244	1244	1249	5
↓							

REMARKS

TYPE OF SOIL

TESTED BY

LH - R-H

ALSO PRESENT

FB - A

SITE INSPECTION SHEET

OWNER: _____ PHONE #: _____

ADDRESS: 5296 ten oaks CONTRACTOR: _____


WELL TAG #: _____

SUBDIVISION: _____ LOT: _____ COUNTY #: _____

PROPOSAL: _____

LOCATION DIAGRAM

ten oaks rd

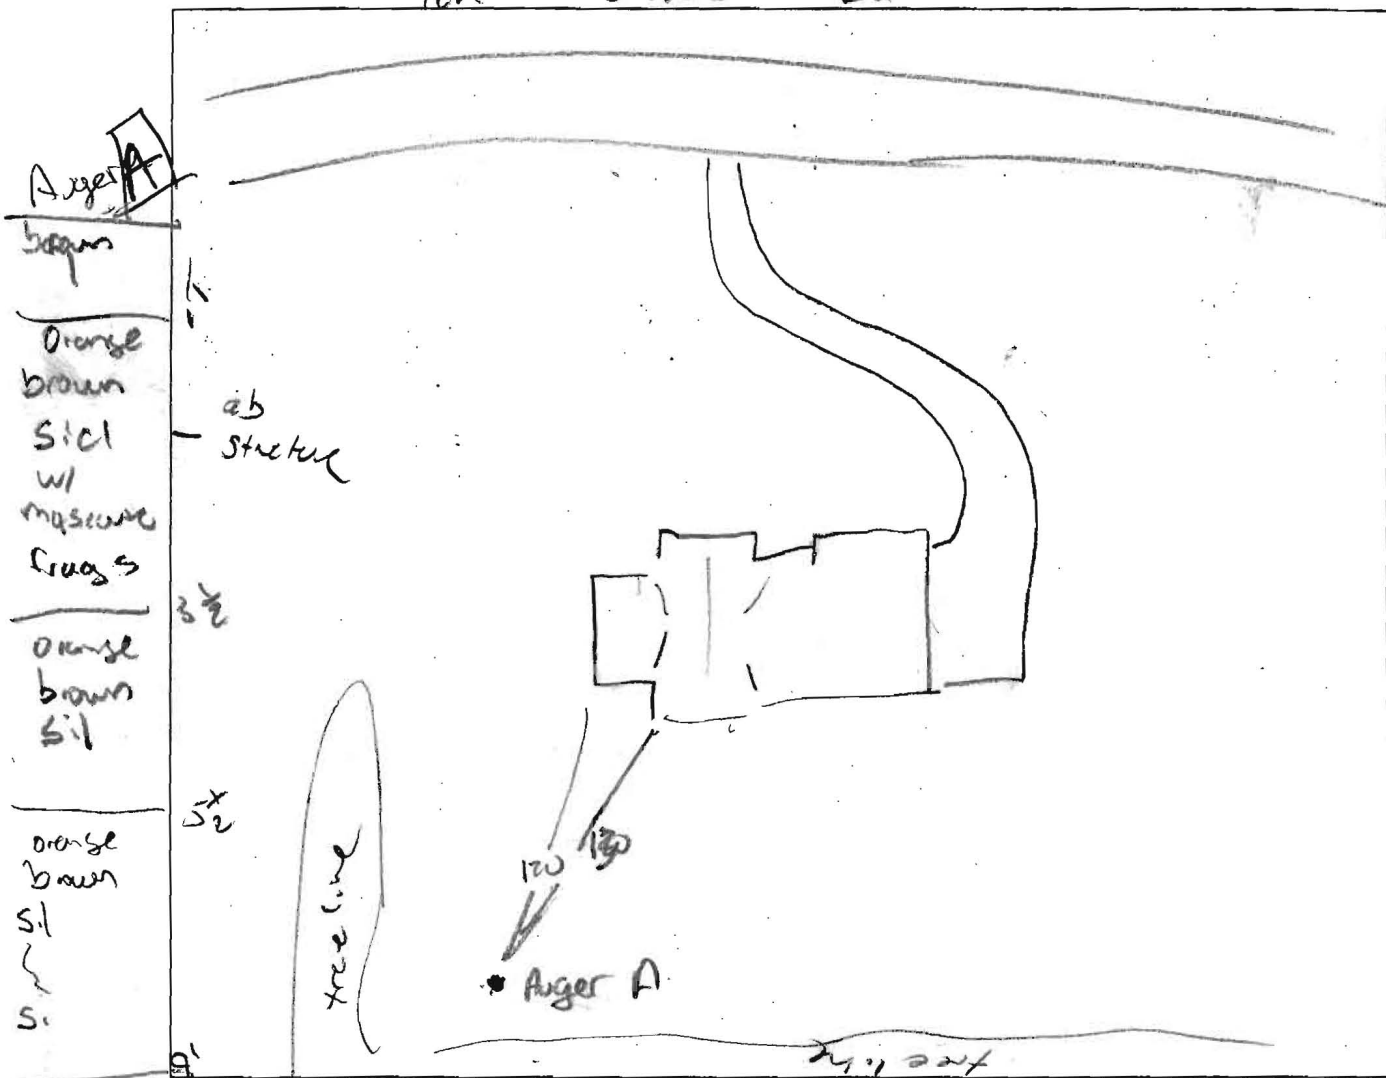

COMMENTS: _____

DATE: 5/2/05 INSPECTOR: RAY