

DEPARTMENT OF INSPECTIONS, LICENSES AND PERMITS 3430 COURT HOUSE DRIVE ELLCOTT CITY, MD 21043 PERMITS (410) 313-2455 INSPECTIONS (410) 313-1810 AUTOMATED INFORMATION (410) 313-3800	HOWARD COUNTY PERMIT APPLICATION	PERMIT NUMBER B005221
--	-------------------------------------	--------------------------

Filing Address <u>3909 WALT ANN DR.</u> <u>ELLCOTT CITY, MD 21043</u>	Property Owner's Name <u>RONALD BROWN</u> Address <u>3909 WALT ANN DR.</u> City <u>ELLCOTT CITY</u> State <u>MD</u> Zip Code <u>21043</u>
Suite/Apt. #: <u>TABED03-283070</u> Census Tract <u>60840.01</u> Subdivision _____ Section _____ Area _____ Lot _____ Tax Map <u>7</u> Parcel <u>22</u> Grid <u>15</u> Zoning _____ Map Coordinates <u>9K10</u> Lot size _____	Home Phone _____ Work Phone _____ Applicant's Name & Mailing Address (if other than stated hereon): <u>LONGWOOD CONSTRUCTION</u> <u>12311 JESSE SMITH RD.</u> <u>MT. AIRY, MD 21771</u> Phone <u>301 748 5269</u> Fax <u>301 865 6222</u>
Existing Use <u>SFD</u> <u>1 STORY</u> Proposed Use <u>SFD</u> Estimated Construction Cost \$ <u>35,000</u> Description of Work <u>20X18 ADDITION - 1 STORY</u> <u>SLAB ON GRADE SUN ROOM</u>	Contractor Company <u>LONGWOOD CONSTRUCTION</u> Contact Person <u>STEVE MURRAY</u> Address <u>12311 JESSE SMITH RD.</u> City <u>MT. AIRY</u> State <u>MD</u> Zip Code <u>21771</u> License No. <u>41141</u> Phone <u>301 748 5269</u> Fax <u>301 865 6222</u>
Occupant or Tenant <u>PROPERTY OWNER</u> Contact Name _____ Address _____ City _____ State _____ Zip Code _____ Phone _____ Fax _____	Engineer or Architect Company _____ Contact Person _____ Address _____ City _____ State _____ Zip Code _____ Phone _____ Fax _____

BUILDING DESCRIPTION - COMMERCIAL		BUILDING DESCRIPTION - RESIDENTIAL	
Building Characteristics Height: _____ No. of stories: _____ Gross area, sq. ft. per floor: _____ Use group: _____ Construction type: <input type="checkbox"/> Reinforced Concrete <input type="checkbox"/> Structural Steel <input type="checkbox"/> Masonry <input type="checkbox"/> Wood Frame <input type="checkbox"/> State Certified Modular	Utilities Water Supply: <input type="checkbox"/> Public <input type="checkbox"/> Private Sewage Disposal: <input type="checkbox"/> Public <input type="checkbox"/> Private Electric Yes <input type="checkbox"/> No <input type="checkbox"/> Gas Yes <input type="checkbox"/> No <input type="checkbox"/> Heating System: Electric <input type="checkbox"/> Oil <input type="checkbox"/> Natural Gas <input type="checkbox"/> Propane Gas <input type="checkbox"/> Sprinkler system: N/A <input type="checkbox"/> <input type="checkbox"/> Full <input type="checkbox"/> Partial <input type="checkbox"/> Other Suppression # of Heads _____	Building Characteristics SF Dwelling <input checked="" type="checkbox"/> SF Townhouse <input type="checkbox"/> 1st floor: <u>30'</u> <u>61'</u> 2nd floor: <u>30'</u> <u>61'</u> Basement: <u>30'</u> Finished Basement <input type="checkbox"/> Unfinished Basement <input checked="" type="checkbox"/> Crawl space <input type="checkbox"/> Slab on Grade <input type="checkbox"/> No. of Bedrooms <u>3</u> Multi-family dwellings: No. of efficiency units: _____ No. of 1 BR units: _____ No. of 2 BR units: _____ No. of 3 BR units: _____ Other Structure: _____ Dimensions: _____ Footings: _____ Roof: _____ <input type="checkbox"/> State Certified Modular <input type="checkbox"/> Manufactured Home	Utilities Water Supply: <input type="checkbox"/> Public <input checked="" type="checkbox"/> Private Sewage Disposal: <input type="checkbox"/> Public <input checked="" type="checkbox"/> Private Electric Yes <input checked="" type="checkbox"/> No <input type="checkbox"/> Gas Yes <input type="checkbox"/> No <input checked="" type="checkbox"/> Heating System: Electric <input type="checkbox"/> Oil <input checked="" type="checkbox"/> Natural Gas <input type="checkbox"/> Propane Gas <input type="checkbox"/> Sprinkler system: N/A <input checked="" type="checkbox"/> <input type="checkbox"/> NFPA #13D <input type="checkbox"/> NFPA #13R <input type="checkbox"/> Other: _____

THE UNDERSIGNED HEREBY CERTIFIES AND AGREES AS FOLLOWS: (1) THAT HE/SHE IS AUTHORIZED TO MAKE THIS APPLICATION; (2) THAT THE INFORMATION IS CORRECT; (3) THAT HE/SHE WILL COMPLY WITH ALL REGULATIONS OF HOWARD COUNTY WHICH ARE APPLICABLE THEREON; (4) THAT HE/SHE WILL PERFORM NO WORK ON THE ABOVE REFERENCED PROPERTY NOT SPECIFICALLY DESCRIBED IN THIS APPLICATION; (5) THAT HE/SHE GRANTS COUNTY OFFICIALS THE RIGHT TO ENTER ONTO THIS PROPERTY FOR THE PURPOSE OF INSPECTING THE WORK PERMITTED AND POSTING NOTICES.

Applicant's Signature <u>Steve Murray</u>	Print Name <u>STEVE MURRAY</u> <u>2/18/05</u> <u>2/18/05</u>
---	---

Title/Company _____	Date _____
Checks payable to: DIRECTOR OF FINANCE OF HOWARD COUNTY ** PLEASE WRITE NEATLY AND LEGIBLY ** - FOR OFFICE USE ONLY -	

AGENCY	DATE	SIGNATURE APPROVAL	DPZ SETBACK INFORMATION	PROPERTY ID#
Land Development DPZ			Front _____	64728
State Highways			Rear _____	Filing fee \$ <u>25</u>
Building Official			Side _____	Permit fee \$ _____
Dev Engineering DPZ			Side St. _____	Excise tax \$ _____
Health <u>6/10/05</u> <u>SL</u>			All minimum setbacks met? YES <input type="checkbox"/> NO <input type="checkbox"/>	Add'l per. fee \$ _____
Fire Protection			Is Entrance Permit required? YES <input type="checkbox"/> NO <input type="checkbox"/>	TOTAL FEES \$ _____
Is Sediment Control approval retained prior to issuance? YES <input type="checkbox"/> NO <input type="checkbox"/>			Historic District? YES <input type="checkbox"/> NO <input type="checkbox"/>	Sub-total paid \$ _____
CONTINGENCY CONSTRUCTION START <input type="checkbox"/>			Lot Coverage for New Town Zone _____	Balance due \$ <u>4709</u>
ONE STOP SHOP <input type="checkbox"/>			SDP/Red-line approval date _____	Check # <u>8230</u>
				Validation # _____
				Accepted by <u>De</u>

berm

Walt Ann Drive

berm

50' A/W 24' 5' mac.

N 48° 11' E 130.00'


112.13' to the P.C. on
the south side of
Sky Way at Lot 6

3/22/05

Proposed add ~~add~~
to close to well.

Khell
must maintain 30' from well

43577 +/- SQ. FT.

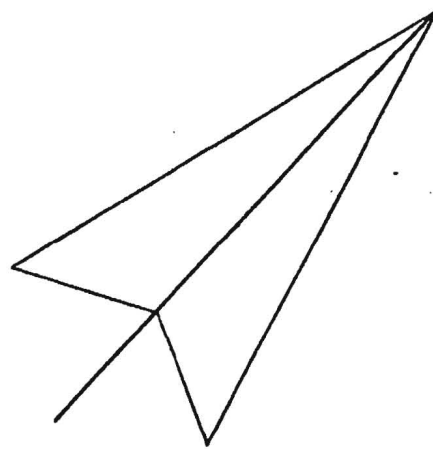

This is to certify that I have
located the improvements on the lot
shown hereon, and that said improve-
ments exist, and that said improve-
ments lie entirely within the bound-
aries.

OF MARY

5' utility easement

S 48° 11' W 130.00'

S 41° 49' E 335.21'

S 41° 49' E 335.21'

LOT 7

PROPOSED
SUN ROOM

WELL

75' bldg. setback line



driveway

98'±

macadam

12' C.W.

One-story Brick

47'

enclo

port

180'

66'

23'

26'

26'


26'

SITE INSPECTION SHEET

OWNER: Ronald Brown PHONE #: _____
ADDRESS: 3905 Walt Ann Dr CONTRACTOR: _____
SUBDIVISION: _____ LOT: _____ WELL TAG #: _____
PROPOSAL: _____

LOCATION DIAGRAM

Walt Ann Drive

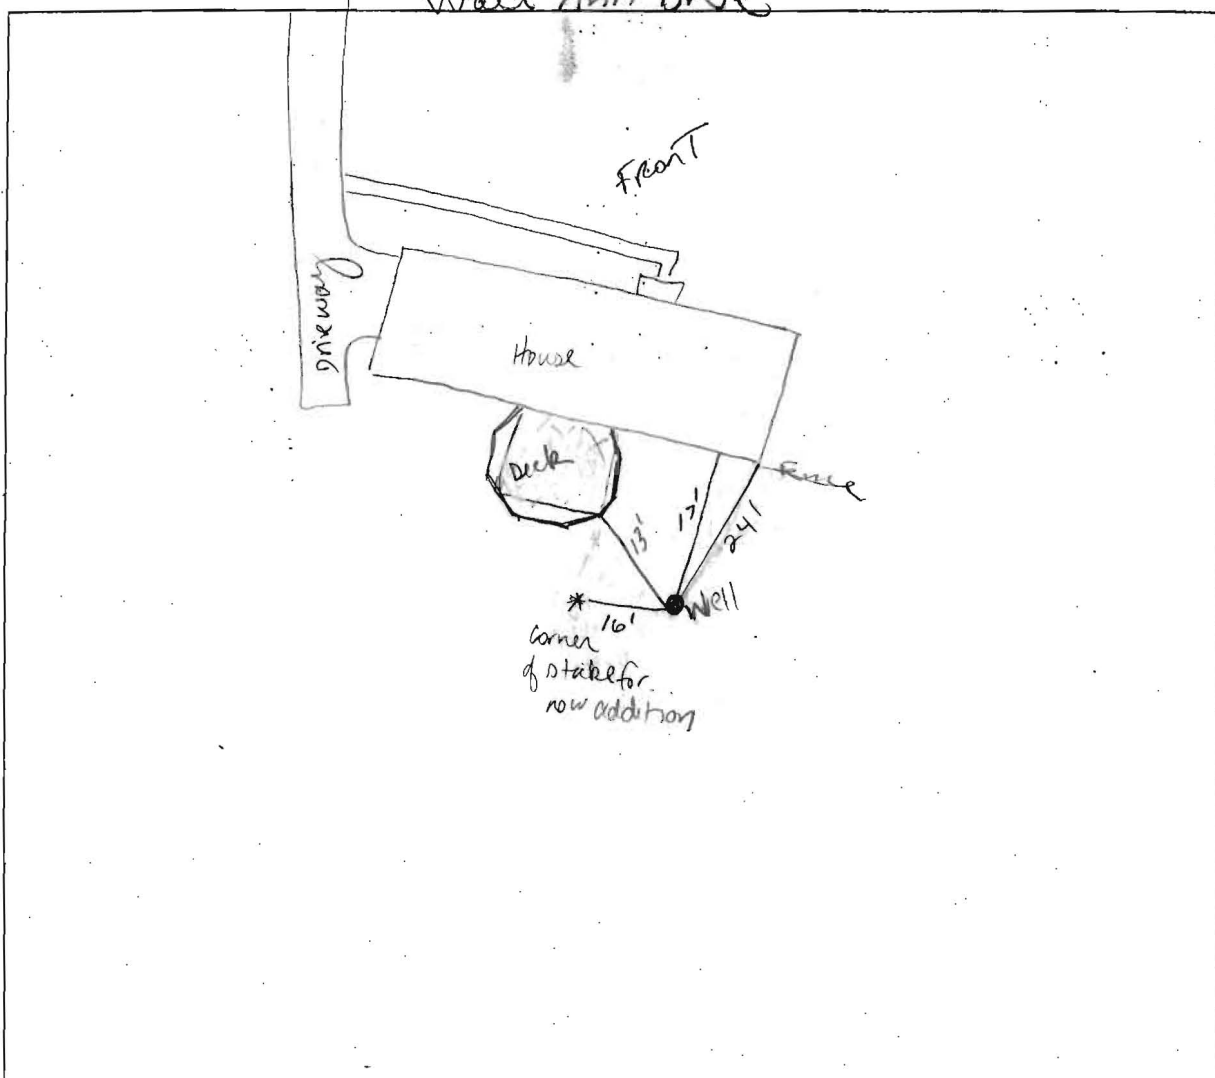

COMMENTS: need letter of variance from home owner
well cap beneath ground.
Septic in front

DATE: 4/11/05 INSPECTOR: PT / SF

LONGWOOD CONSTRUCTION

12311 JESSE SMITH RD. • MT. AIRY, MD 21771
(301) 829-8825 • FAX (301) 865-6222

MHIC 44141

April 13, 2005

Mr. John Boris
Environmental Health
7178 Columbia Gateway Drive
Columbia, Maryland 21046

Re: Building permit application #00152321/ 3905 Walt Ann Drive, Ellicott City, MD

Dear Mr. Boris:


I am writing to request a variance from the required setback from an existing well at the above-referenced property.

As verified in the field by your staff, the well is currently only 16 feet from the existing house. I would ask that we be allowed to build our proposed addition with a minimum setback from the well of 16 feet also.

I am attaching a plat hereto that accurately depicts the conditions in the field.

Thank you for your consideration.

Very Truly Yours,

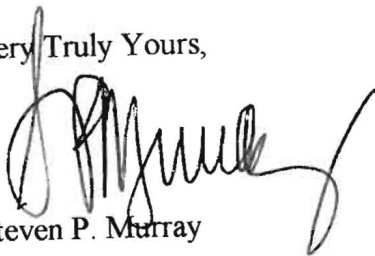
Steven P. Murray

Walt Ann Drive
50' B/W 24' mac.

N 48° 11' E 130.00'

112.13' to the P.C. on
the south side of
Sky Way at Lot 6

SEPIC

75' bldg. setback line

macadam

20'


47'

PROPOSED
SUN ROOM
(16' FROM WELL)

LOT 7

5' utility easement

43577 +/- SQ. FT.

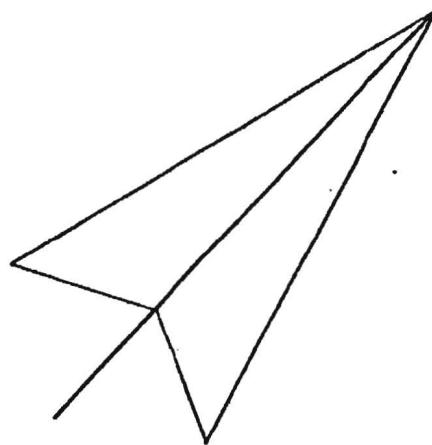

This is to certify that I have
located the improvements on the lot
shown hereon, and that said improve-
ments exist, and that said improve-
ments lie entirely within the bound-
aries