

WR-W-4
4-66

State Office Building
ANNAPOLIS, MARYLAND, 21401

STATE OF MARYLAND
DEPARTMENT OF
WATER RESOURCES

THIS REPORT
MUST BE SUBMITTED
WITHIN 30 DAYS
AFTER COMPLETION
OF THE WELL

WELL COMPLETION REPORT **A09611**

WELL DESCRIPTION

WELL LOG
State the kind of formations penetrated, their color, their depth, their thickness, and if water-bearing

CASING AND SCREEN RECORD
State the kind and size and position of casing, liner, shoe, screen, and other accessories (if no casing used, give diameter of well).

| | FEET from ___ to ___ | | DIAM. (Inches) | FEET from ___ to ___ |
|----------------------|-------------------------|----------------|-------------------|-------------------------|
| Dirt | 0-19 | Well Casing | 5 5/8 | 0-42 |
| Dirt & Shale | 19-32 | | | |
| Brown Shale water | 32-51 | | | |
| Hard Gray Rock | 51-90 | | | |

Permit Number **HO 67 W 220**
Owner **Walter Shank**
Address **Glennely Md**
Subdivision **Shepherds**
Section _____ Lot **7**

PUMPING TEST
Hours Pumped _____
Type of Pump Used **Baler**
Pumping Rate **1 PM**
Gallons per Minute **2**

WATER LEVEL
(Distance from land surface to water)
Before Pumping **40** Ft.
When Pumping **87** Ft.


APPEARANCE OF WATER
Clear Cloudy _____
Taste _____
Odor **NONE**

Height of Casing Above Land
Surface _____ Ft.

PUMP INSTALLED
Type _____
Capacity _____
Gallons per Minute _____
Gallons per Hour _____
Pump Column Length _____ Ft.

HO-67-W-220

LOCATION OF WELL ON LOT
Show permanent structures such as building(s), septic tank, and/or other landmarks and indicate not less than 2 distances (measurements) to well.

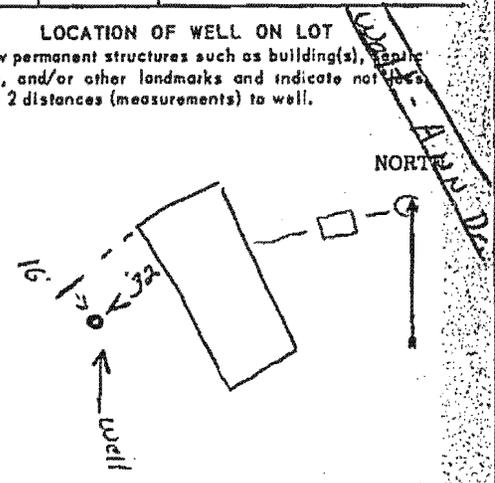

DATE
WELL WAS
COMPLETED


I hereby affirm that this report contains no willful misrepresentations or falsifications and that information given in this report is true, accurate and complete to the best of my knowledge and belief.

67

Walter Barnes, Well Driller

April 29

Well Driller License No.: **58**

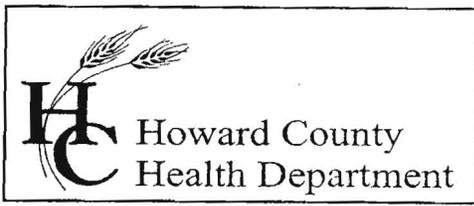

7178 Columbia Gateway Drive, Columbia, MD 21046
(410) 313-2640 Fax (410) 313-2648
TDD (410) 313-2323 Toll Free 1-866-313-6300
website: www.hchealth.org

Penny E. Borenstein, M.D., M.P.H., Health Officer

April 29, 2005

Stephen P. Murray
12311 Jesse Smith Road
Mt. Airy, MD 21771


RE: 3905 Walt Ann Drive

Dear Mr. Murray,

We have received a variance requesting the required 30' setback to a foundation for a well at the above referenced property be waived to 16'. This agency will grant your approval for the variance at the property, as there will be no additional encroachment to the existing condition. As a condition of this approval, and prior to approval of building permit B0015321, the well cap must be extended to at least 8" above grade in order to be in compliance with the Code of Maryland Regulations. Once the cap is extended, field verification will be required and the building permit will be approved.

Any questions regarding this decision may be directed to the Well and Septic Program of the Howard County Health Department.

Respectfully,

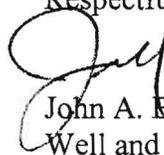

John A. Boris, Jr., R.S., Director
Well and Septic Program

cc: File