

PUB. SEWER STATUS VERIFIED BY _____

ISSUE DATE: 7/21/05

P 522982

APPROVAL DATE: 8/29/05

A REPAIR

PERMIT

INDEXED
04328728

ON-SITE SEWAGE DISPOSAL SYSTEM HOWARD COUNTY HEALTH DEPARTMENT BUREAU OF ENVIRONMENTAL HEALTH

Fogles Septic Clean, Inc IS PERMITTED TO INSTALL ALTER

ADDRESS: 580 Obrecht Road PHONE NUMBER: 410-795-5670

SUBDIVISION: _____ LOT NUMBER: _____

ADDRESS: 1880 Woodbine Road PROPERTY OWNER: Earl Stevens

SEPTIC TANK CAPACITY (GALLONS): 2-Comp. Trench 3' Wide

PUMP CHAMBER CAPACITY (GALLONS): N/A Inlet 3.5'

NUMBER OF BEDROOMS: 3 Bottom 4.5'

SQUARE FEET PER BEDROOM: 210 1' Stone Below Pipe

LINEAR FEET OF TRENCH REQUIRED: 175 2 Trenches

TRENCHES:	Trench to be _____ feet wide. Inlet _____ feet below original grade. Bottom maximum depth _____ feet below original grade. Effective area begins at _____ feet below original grade. _____ feet of stone below distribution pipe.
LOCATION:	<u>Pump Out and Fill in Old Tank and Drywell</u>
PURPOSE:	Existing septic system has failed. Call for inspection when ground is opened so sanitarian can recommend repair.

PLANS APPROVED: _____ DATE: _____

- NOTE: PERMIT VOID AFTER 2 YEARS
- NOTE: CONTRACTOR RESPONSIBLE FOR SCHEDULING A PRE-CONSTRUCTION INSPECTION FOR ALL INSTALLATIONS
- NOTE: WATERTIGHT SEPTIC TANKS REQUIRED
- NOTE: ALL PARTS OF SEPTIC SYSTEM SHALL BE 100 FEET FROM ANY WATER WELL
- NOTE: MANHOLE RISERS REQUIRED ON ALL SEPTIC TANKS AND PUMP CHAMBERS


NEITHER THE HOWARD COUNTY COUNCIL OR THE HEALTH DEPARTMENT IS RESPONSIBLE FOR THE SUCCESSFUL OPERATION OF ANY SYSTEM PERMITTEE RESPONSIBLE FOR OBTAINING FINAL APPROVAL ON THIS PERMIT CALL 410-313-2640 FOR INSPECTION OF SEPTIC SYSTEM

BUILDING PERMIT SIGNED AND RETURNED

2/28/07 - addition - 807000625-

201770

NOT TO SCALE

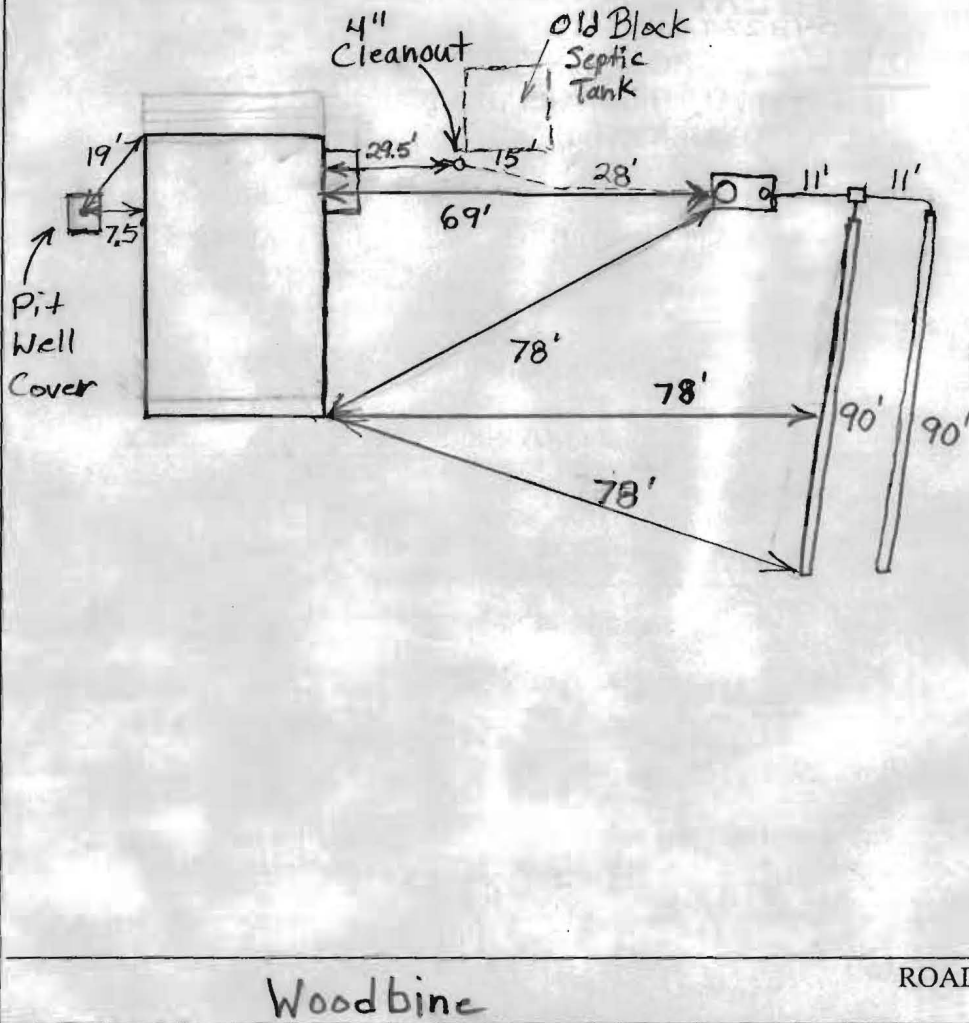

TRENCH/DRAINFIELD DATA		
WIDTH	INLET	BOTTOM
3'	3.5'	4.5'
NUMBER OF TRENCHES		2
TOTAL LENGTH		180'
ABSORPTION AREA		540' + Sidewall
DISTRIBUTION BOX LEVEL		Levelers
DISTRIBUTION BOX BAFFLE		Yes
DISTRIBUTION BOX PORT		No

SEPTIC TANK DATA	
SEPTIC TANK 1 LEVEL	Yes
CAPACITY	1500 GAL
SEAM LOC	Top
TANK LID DEPTH	0.5'-1.5'
BAFFLES	Yes
BAFFLE FILTER	No
MANHOLE LOC	Front
6" PORT LOC	Rear
WATERTIGHT TEST	No
SEPTIC TANK 2 LEVEL	N/A
CAPACITY	_____ GAL
SEAM LOC	_____
TANK LID DEPTH	_____
BAFFLES	_____
BAFFLE FILTER	_____
MANHOLE LOC	_____
6" PORT LOC	_____
WATERTIGHT TEST	_____

Babylon
2-Comp.

PRE-CONSTRUCTION 8/24/05 To install a new 2-compartment septic tank and 175' of trench near the perc test hole.

INSTALLATION Keep tank 100' from well. (BB)

8/25/05 Drywell filled with dirt. Setting tank. (BB)

8/26/05 Old tank filled in. Starting with trenches. Gave installer O.K. to deepen trenches by up to 1' if not getting through upper clay layer (BB)

8/29/05 Installer put trenches in at original depth. He said that the material looked good. O.K. to backfill. (BB)

FINAL INSPECTOR B. Baber DATE OF APPROVAL 8/29/05

AND RETURNED