

LAYOUT _____ INSP 4 _____
INSP 2 _____ INSP 5 _____
INSP 3 _____ INSP 6 _____

ISSUE DATE: 05/22/61

P 03478

APPROVAL DATE: _____

A 523146

PERMIT

INDEXED

TAX ID # 04-323416

**ON-SITE SEWAGE DISPOSAL SYSTEM
HOWARD COUNTY HEALTH DEPARTMENT
BUREAU OF ENVIRONMENTAL HEALTH**

_____ IS PERMITTED TO INSTALL ☒ ALTER ☐

ADDRESS: _____ PHONE NUMBER: _____

SUBDIVISION: _____ LOT NUMBER: _____

ADDRESS: 18609 Windsor Forest Road PROPERTY OWNER: Coy R Morris

SEPTIC TANK CAPACITY (GALLONS): _____ OUTLET BAFFLE FILTER REQUIRED ☐

PUMP CHAMBER CAPACITY (GALLONS): _____ COMPARTMENTED TANK REQUIRED ☐

NUMBER OF BEDROOMS: _____

SQUARE FEET PER BEDROOM: _____

LINEAR FEET OF TRENCH REQUIRED: _____

TRENCHES:	Trench to be _____ feet wide. Inlet _____ feet below original grade. Bottom maximum depth _____ feet below original grade. Effective area begins at _____ feet below original grade. _____ feet of stone below distribution pipe.
LOCATION:	
NOTES:	

PLANS APPROVED: _____ DATE: _____

NOTE: PERMIT VOID AFTER 2 YEARS

NOTE: CONTRACTOR RESPONSIBLE FOR SCHEDULING A PRE-CONSTRUCTION INSPECTION FOR ALL INSTALLATIONS

NOTE: WATERTIGHT SEPTIC TANKS REQUIRED

NOTE: ALL PARTS OF SEPTIC SYSTEM SHALL BE 100 FEET FROM ANY WATER WELL

NOTE: MANHOLE RISERS REQUIRED ON ALL SEPTIC TANKS AND PUMP CHAMBERS UNLESS SPECIFICALLY AUTHORIZED

**NEITHER THE HOWARD COUNTY COUNCIL NOR THE HEALTH DEPARTMENT IS
RESPONSIBLE FOR THE SUCCESSFUL OPERATION OF ANY SYSTEM
PERMITTEE RESPONSIBLE FOR OBTAINING FINAL APPROVAL ON THIS PERMIT
CALL 410-313-2640 FOR INSPECTION OF SEPTIC SYSTEM**

4523146

Ok out
7/13/61

PERMIT

SEWAGE DISPOSAL SYSTEM

MARYLAND STATE DEPARTMENT OF HEALTH

HOWARD COUNTY

ELLICOTT CITY

DISTRICT 4

DATE 5/22/61

INDEXED

Walter S. Johnson

IS PERMITTED TO INSTALL ☒ ALTER

ADDRESS 9150 Main St., Damascus, Md.

PHONE Clearwater 3-2203

A SEWAGE DISPOSAL SYSTEM LOCATED AT Windsor Forest Rd. - Rt. 40 to Long Corner Rd.

turn left about 2 miles back Long Corner Rd. to Windsor Forest Rd. right on WF Rd. .3 mi.
house on left.

SUBDIVISION _____ ROAD _____ LOT _____

PROPERTY OWNER Moore, Richard H.

ADDRESS 4207 Ammondale Rd., Beltsville

SPECIFICATIONS

DRAIN FIELD _____ DEPTH _____ FEET, BOTTOM AREA _____ SQ. FT.

SEEPAGE PITS ☒ ABSORBENT SIDE-WALL AREA 555 SQ. FT.

SEPTIC TANK CAPACITY 1500 GALLONS

FOR GARBAGE GRINDER, INCREASE DISPOSAL AREA 22% & TANK CAPACITY 50%.


OTHER Septic tank cannot be installed more than 3 feet below original grade.

PLANS APPROVED BY Walton T. Loevy DATE 4/21/61

FILL SEPTIC TANK AND DISTRIBUTION BOX WITH WATER BEFORE CALLING FOR AN INSPECTION. COVER NO WORK UNTIL INSPECTED AND APPROVED.

NEITHER THE HOWARD COUNTY COMMISSIONERS NOR THE HEALTH DEPARTMENT IS RESPONSIBLE FOR THE SUCCESSFUL OPERATION OF ANY SYSTEM.

A-03605

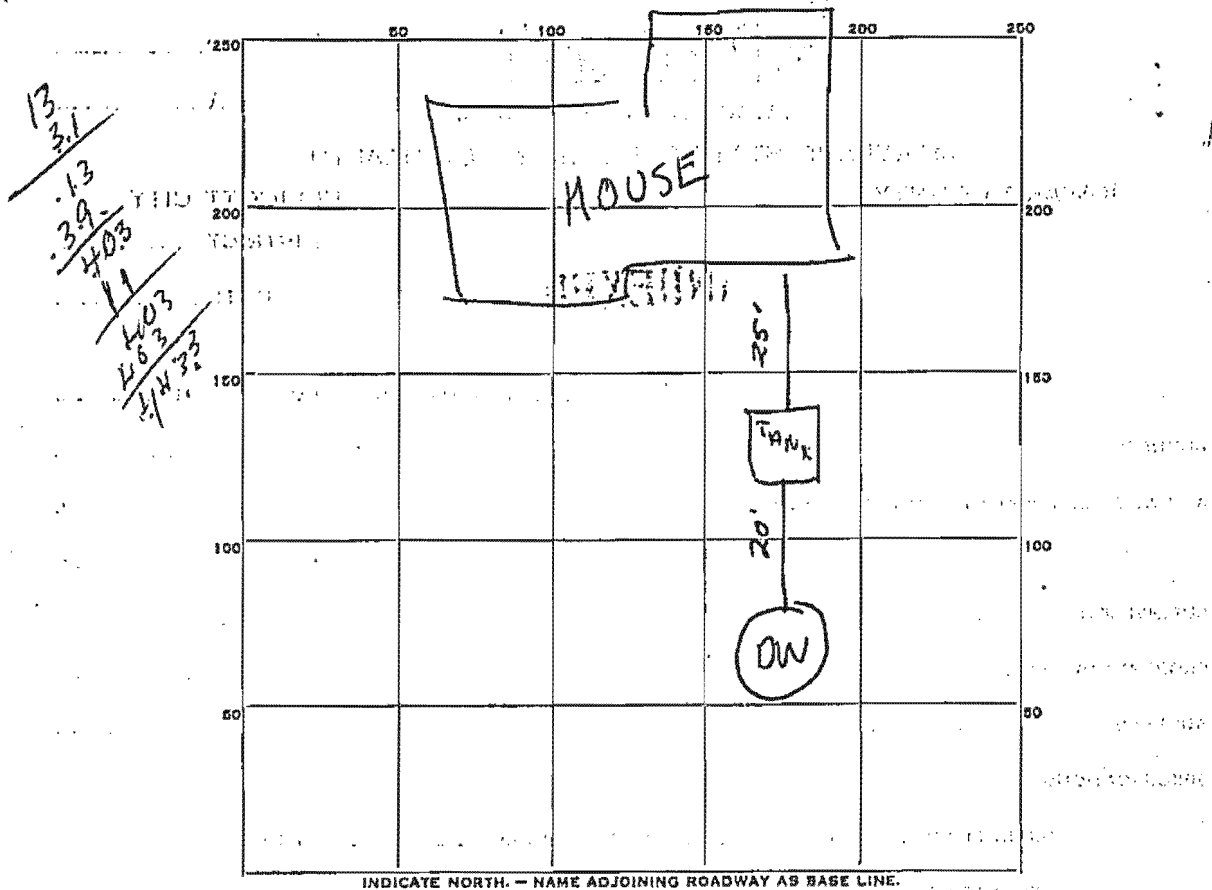

PERMIT CARD ☒

SEPTIC TANK, LEVEL 1500 - concrete

CLEANOUTS ☒

DISTRIBUTION BOX, LEVEL _____

TILE FIELD, DEPTH _____ FT. TRENCH WIDTH _____ FT.

GRAVEL DEPTH _____ IN. TOTAL LENGTH _____ FT.

NUMBER OF TRENCHES _____ TOTAL BOTTOM AREA _____

SEEPAGE PITS, INSIDE DIAMETER 13 FT. DEPTH BELOW INLET 11 FT.

ABSORBENT AREA 443 SQ. FT.

REMARKS _____

Dry well is short about 112 s.f.

System is completed, but not approved by Howard County Health Dept.

completed
DATE SYSTEM APPROVED

7/13/61

INSPECTOR

deery

NOT TO SCALE

18609 Windsor Forest Rd.
Mount Airy, MD 21771-3927
NOT TO SCALE

3726003
741 373

N

Dry Well

Septic Tank

Scattered
Small
Trees

Water Well

Location of Generator


Proposed location of
buried propane tank


Buried Fuel Oil Tank

GAS LINE

NOT TO SCALE

*As shown
see the 4 scale
drawing
1/5/06*

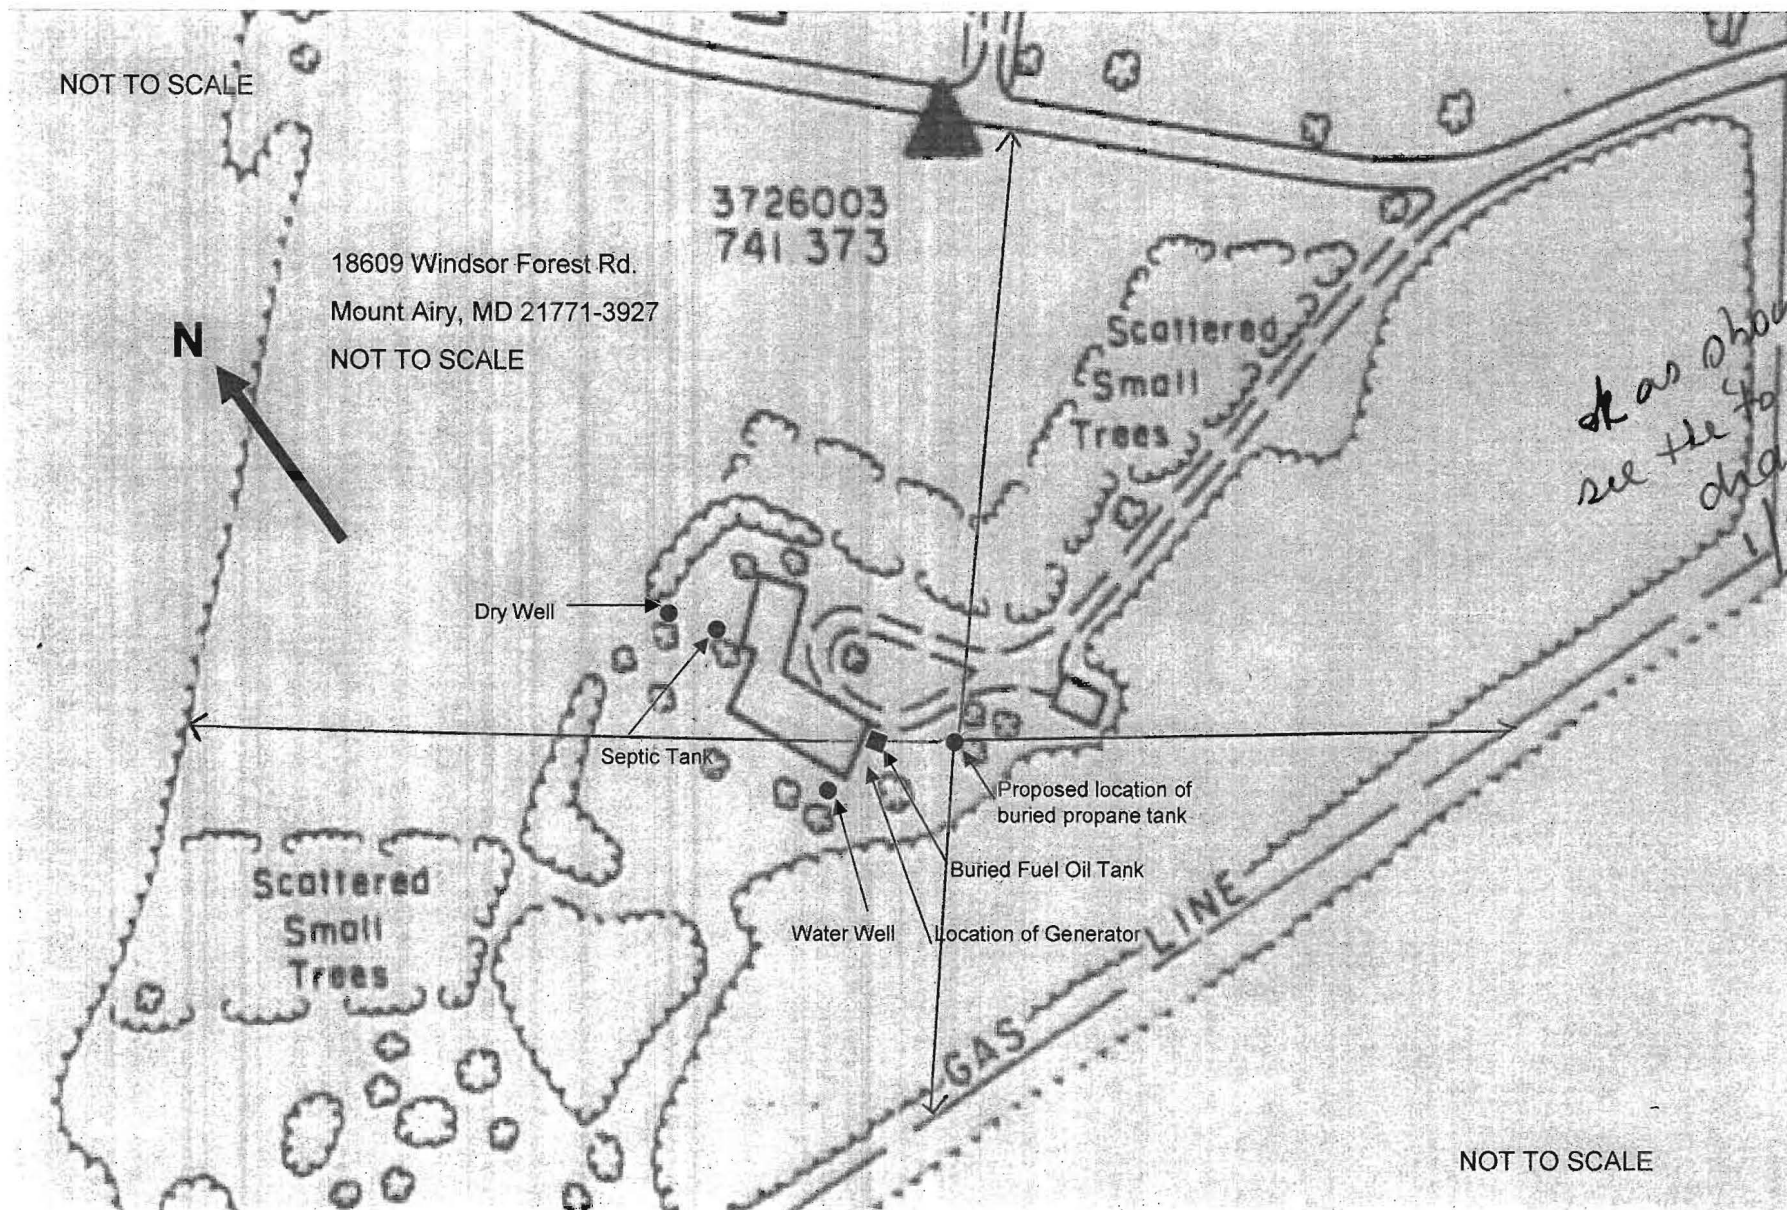

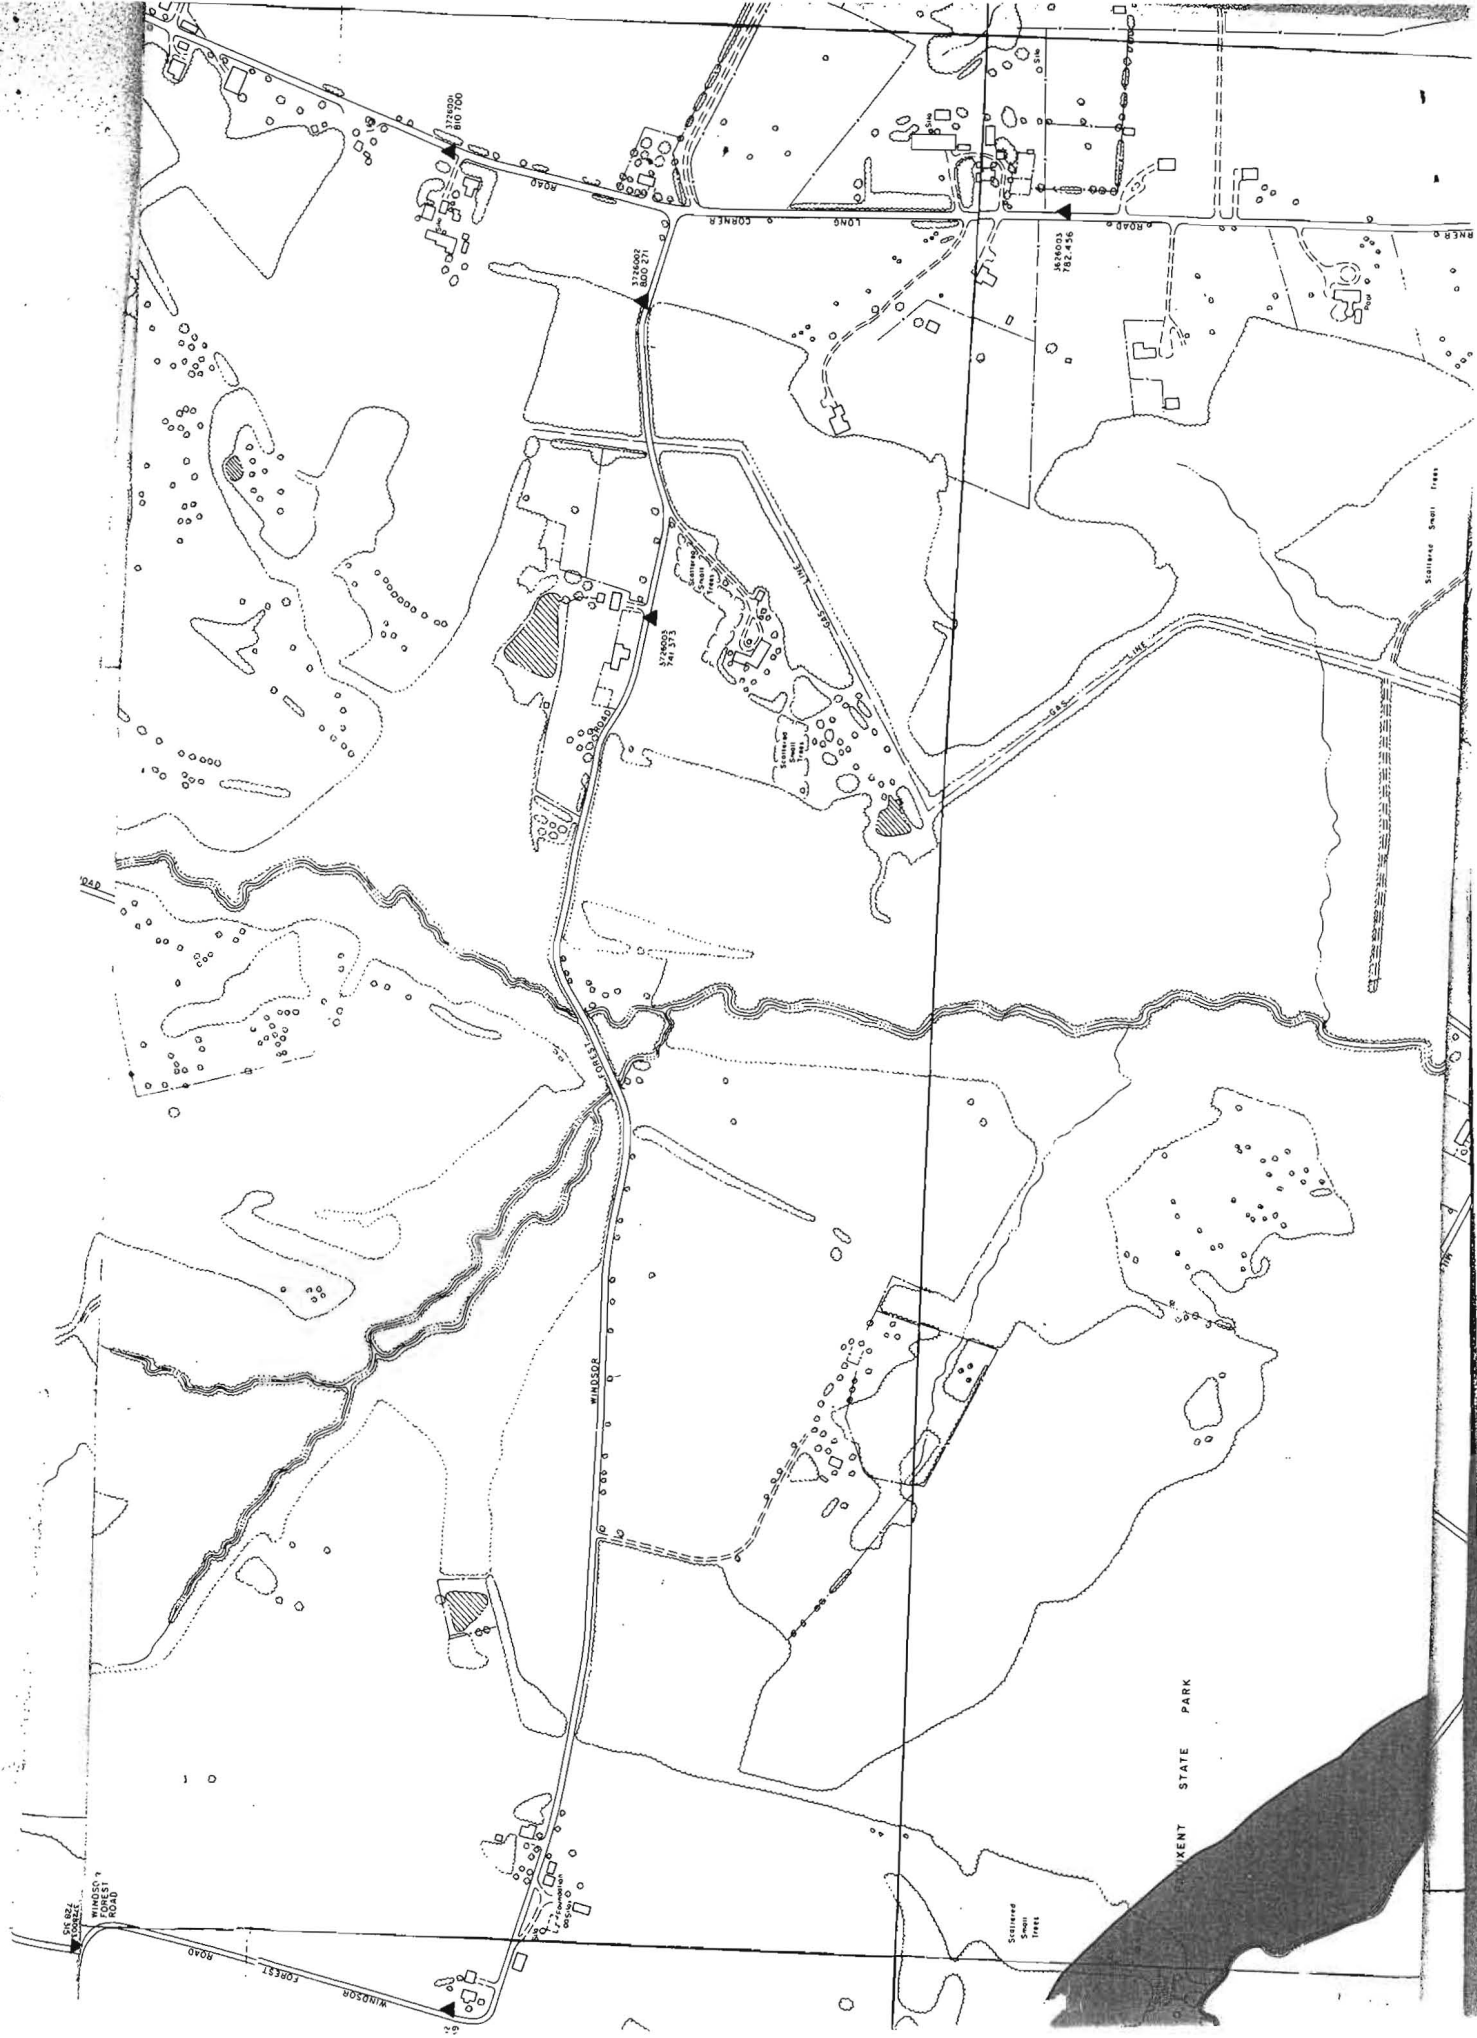

TO SCALE

18609 Windsor Forest Rd.
Mount Airy, MD 21771-3927
TO SCALE

N

3726003
741 373

487'

South East corner
of house

Scattered
Small
Trees

*okay as shown
1/5/06
SF*

Dry Well

75' from north wall of
house, 90' from north
west corner

North West corner of house

Scattered
Small
Trees

Septic Tank
25' from
north wall of
house, 40'
from north
west corner

Water Well
8'x12' from south
west corner of
house

Buried Fuel Oil
Tank 8' from
driveway, adjacent
to south east wall of
house

Location of Generator
3' from south east wall
of house, 18' from
driveway

South West corner
of house

Proposed location of
buried propane tank, 10'
from driveway, 45' from
south east corner of house

375'

200'

.5 inch = 75 feet
.1 inch = 15 feet

TO SCALE

12'

SITE INSPECTION SHEET

OWNER: _____ PHONE #: _____


ADDRESS: 18609 Windsor Forest Rd. CONTRACTOR: _____

_____ WELL TAG #: _____

SUBDIVISION: _____ LOT: _____ COUNTY #: _____

PROPOSAL: verify well location in relation to
new propane tank

LOCATION DIAGRAM

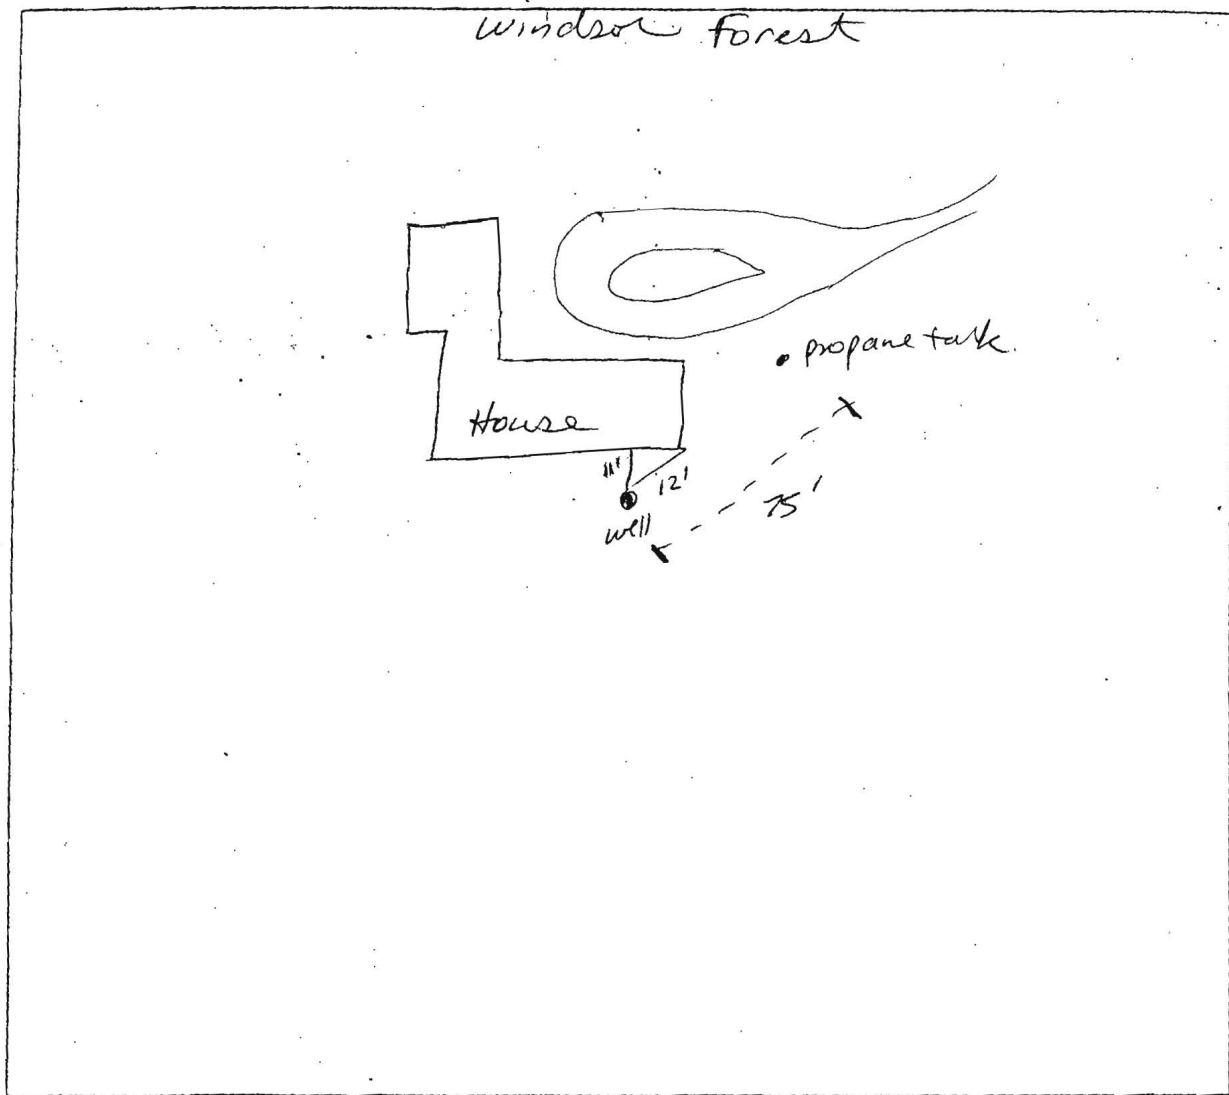

COMMENTS: well ok distance from propane tank

DATE: 1/5/06

(SF)