

APPLICATION

#35803

A 26042

SEWAGE DISPOSAL TESTING

P _____

STATE OF MARYLAND - DEPARTMENT OF HEALTH AND MENTAL HYGIENE

HOWARD COUNTY HEALTH DEPARTMENT
ENVIRONMENTAL HEALTH SERVICES

DISTRICT 3rd

P. O. BOX 476, ELLICOTT CITY, MARYLAND 21043
TELEPHONE: 465-5000, EXT. 356

DATE 6/7/77

TO: THE COUNTY HEALTH OFFICER
ELLICOTT CITY, MARYLAND

I, HEREBY, APPLY FOR THE NECESSARY TEST IN ORDER TO CONSTRUCT (OR RECONSTRUCT) A SEWAGE DISPOSAL SYSTEM.

PROPERTY OWNER William B. Ridgely

ADDRESS Spring Meadow Farm Cooksville, Md. 21728 PHONE Carol Clark
531-5115

PROPERTY LOCATION:

SUBDIVISION Ridgely Property (Friendship Manor) LOT NO. 19 22

ROAD AND DESCRIPTION Rte. 144 - Rte. 32

SIZE OF LOT 2 TYPE BLDG. 3 or 4 bedroom
NUMBER OF BEDROOMS

IF NOT SINGLE RESIDENCE DESCRIBE _____

THE SYSTEM INSTALLED UNDER THIS APPLICATION IS ACCEPTABLE ONLY UNTIL PUBLIC FACILITIES BECOME AVAILABLE.

SIGNATURE OF APPLICANT /s/ Albert Scheel


APPROVED BY Rm & DON FOR [Signature] DATE 6/7/77 2:23 PM
(KIND OF SYSTEM)REJECTED BY _____ FOR _____ DATE _____
(KIND OF SYSTEM)

HOLD PENDING FURTHER TESTS _____ DATE _____

REASONS FOR REJECTION OR HOLDING _____

BLDG. PERMIT, SIGNED
AND RETURNED 6/13/78
serial # 35803

THIS IS NOT A PERMIT

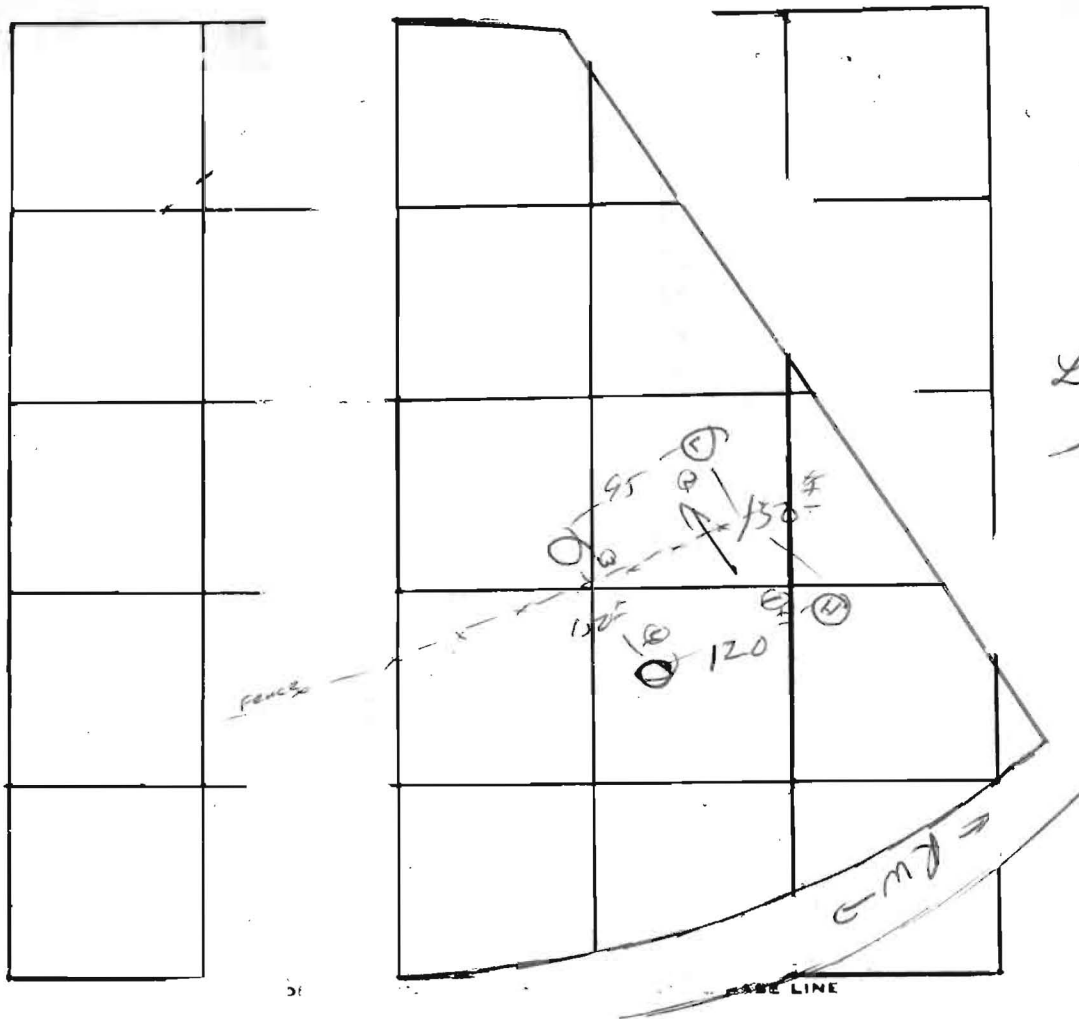

DATE	TEST NO.	DEPTH	PRE-WET		TEST - 1" DROP		TIME
			START	STOP	START	STOP	
July 7	1	2	10 ⁰⁵	10 ¹⁰	10 ¹⁰	10 ¹⁵	5
		13		10 ¹⁵	10 ¹⁵	10 ³⁴	19
	2	2		10 ¹¹	10 ¹¹	10 ¹⁹	8
		13		10 ¹⁵	10 ¹⁵	10 ³⁸	23
	3	2½		10 ⁰⁹	10 ⁰⁹	10 ¹⁶	7
		13	↓	10 ¹³	10 ¹³	10 ²⁷	14
	4	12	✓ 15				

REMARKS

TYPE OF SOIL

TESTED BY

ALSO PRESENT:

School