

LAYOUT \_\_\_\_\_

INSP 1 \_\_\_\_\_ INSP 3 \_\_\_\_\_

INSP 2 \_\_\_\_\_ INSP 4 \_\_\_\_\_

ISSUE DATE: 9/12/06

P 52553-A

APPROVAL  
DATE:

11/1/06

TAX ID# \_\_\_\_\_

A \_\_\_\_\_

**PERMIT  
INDEXED**

**COMMUNITY SEPTIC SYSTEM  
COMMUNITY CENTER SEWER LINE CONNECTION**

**HOWARD COUNTY HEALTH DEPARTMENT  
BUREAU OF ENVIRONMENTAL HEALTH**

Ryan Homes - Adam Bennett IS PERMITTED TO INSTALL  ALTER

ADDRESS: 12081 Windsor Moss PHONE NUMBER: 410-796-0980

SUBDIVISION Homeland Unit # 25

ADDRESS: 12081 Windsor Moss PROPERTY OWNER: NVR, Inc. t/a Ryan Homes

**COMMUNITY BUILDING SERVED BY A COMMUNITY SEPTIC SYSTEM & PUBLIC  
WATER SUPPLY.**

|           |                                                                                                                                                                                   |
|-----------|-----------------------------------------------------------------------------------------------------------------------------------------------------------------------------------|
| LOCATION: | Install 4" house sewer line connection per the approved site plan. Final acceptance of the sewer system will be subject to the approval of the Maryland Dept. of the Environment. |
| NOTES:    | This permit is limited to the installation of the individual house sewer line connection.                                                                                         |

PLANS APPROVED: Gabriel A. Creighton DATE: 8/11/06


**PERMIT VOID AFTER 2 YEARS**

1. CONTRACTOR IS RESPONSIBLE FOR SCHEDULING A PRE-CONSTRUCTION INSPECTION FOR ALL INSTALLATIONS.
2. ALL PARTS OF SEPTIC SYSTEM SHALL BE 100 FEET FROM ANY WATER WELL UNLESS SPECIFICALLY AUTHORIZED.
3. CONTRACTOR RESPONSIBLE FOR COMPLIANCE WITH APPLICABLE REGULATIONS, GUIDELINES AND THE TERMS OF THIS PERMIT.
4. NEITHER THE HOWARD COUNTY COUNCIL OR THE HEALTH DEPARTMENT IS RESPONSIBLE FOR THE SUCCESSFUL OPERATION OF ANY SYSTEM.
5. PERMITTEE RESPONSIBLE FOR OBTAINING FINAL APPROVAL ON THIS PERMIT.

**CALL 410-313-1771 FOR INSPECTION OF SEPTIC CONNECTION**

P52553-A

NOT TO SCALE

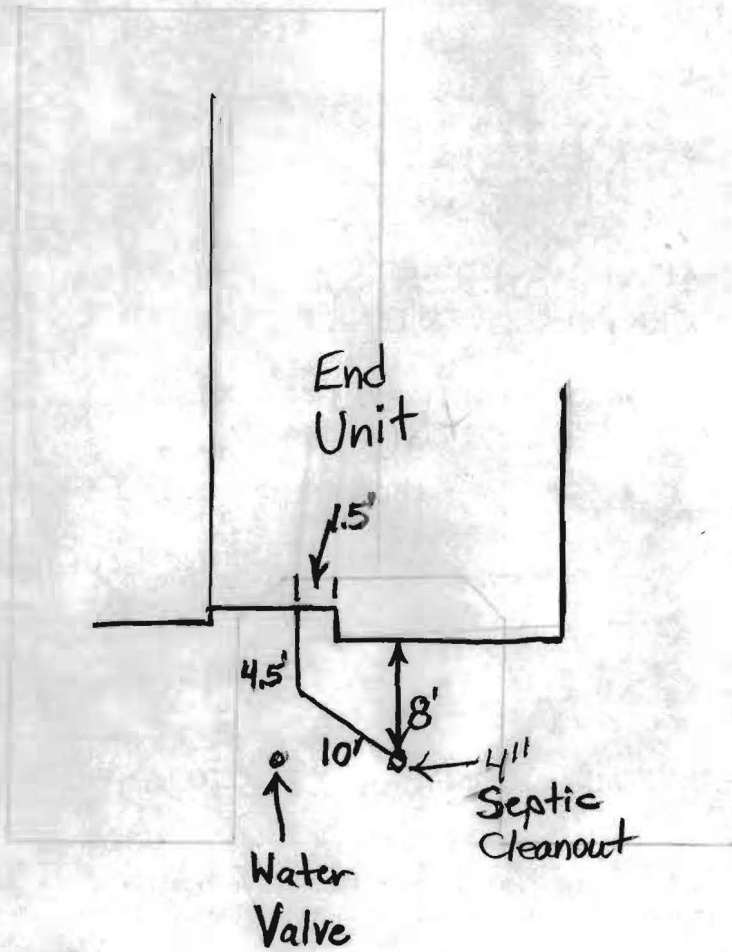

Windsor Mass

| TRENCH/DRAINFIELD DATA        |       |        |
|-------------------------------|-------|--------|
| WIDTH                         | INLET | BOTTOM |
| _____                         | _____ | _____  |
| NUMBER OF TRENCHES _____      |       |        |
| TOTAL LENGTH _____            |       |        |
| ABSORPTION AREA _____         |       |        |
| DISTRIBUTION BOX LEVEL _____  |       |        |
| DISTRIBUTION BOX BAFFLE _____ |       |        |
| DISTRIBUTION BOX PORT _____   |       |        |

| SEPTIC TANK DATA          |     |
|---------------------------|-----|
| SEPTIC TANK 1 LEVEL _____ |     |
| CAPACITY _____            | GAL |
| SEAM LOC _____            |     |
| TANK LID DEPTH _____      |     |
| BAFFLES _____             |     |
| BAFFLE FILTER _____       |     |
| MANHOLE LOC _____         |     |
| 6" PORT LOC _____         |     |
| WATERTIGHT TEST _____     |     |
| SEPTIC TANK 2 LEVEL _____ |     |
| CAPACITY _____            | GAL |
| SEAM LOC _____            |     |
| TANK LID DEPTH _____      |     |
| BAFFLES _____             |     |
| BAFFLE FILTER _____       |     |
| MANHOLE LOC _____         |     |
| 6" PORT LOC _____         |     |
| WATERTIGHT TEST _____     |     |

PRE-CONSTRUCTION 11/1/06 Septic connection made BB

INSTALLATION \_\_\_\_\_

\_\_\_\_\_  
\_\_\_\_\_  
\_\_\_\_\_  
\_\_\_\_\_

FINAL INSPECTOR 11/1/06

DATE OF APPROVAL B. Baker



25A (25)

Lot \_\_\_\_\_ Block \_\_\_\_\_

Community Ellicott Meadows (ET)

**BEDROOM RESTRICTION ACKNOWLEDGMENT**  
Hearthstone at Ellicott Meadows

The undersigned Purchaser has entered into a Purchase Agreement for the Property known as EI 25A (25) and located in the Ellicott Meadows Community (the "Property").

By signing below, Purchaser acknowledges they have been informed of and understand the following information relating to the Property:


The Hearthstone at Ellicott Meadows is served by a community private sewage disposal system which can only accommodate a maximum of two bedrooms per Unit. Howard County will enforce this restriction and will not issue any building permits for modifications to any Unit where the number of bedrooms will be increased beyond two.

ACKNOWLEDGED BY PURCHASER

Purchaser: \_\_\_\_\_

Purchaser: \_\_\_\_\_

Date: \_\_\_\_\_

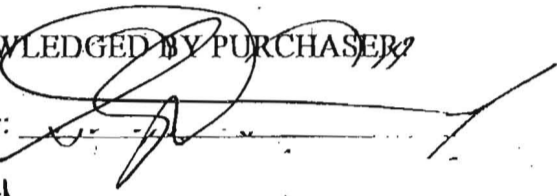

7/24/06

12081 WINDSOR NESS

EI 25A