

APPLICATION

PERCOLATION TESTING

A 46659

P _____

HOWARD COUNTY HEALTH DEPARTMENT
BUREAU OF ENVIRONMENTAL HEALTH
P.O. BOX 476 ELLICOTT CITY, MARYLAND 21043
TELEPHONE 461-9933

DISTRICT _____

DATE 12/4/90

TO: THE COUNTY HEALTH OFFICER
ELLICOTT CITY, MARYLAND

I, HEREBY, APPLY FOR THE NECESSARY TEST IN ORDER TO CONSTRUCT (OR RECONSTRUCT) A SEWAGE DISPOSAL SYSTEM.

PROPERTY OWNER CHARLES GOSHEN

ADDRESS 14831 TRIADELPHIA Rd. Glenely 2/737 PHONE 442-1568

PROSPECTIVE BUYER _____

ADDRESS _____ PHONE _____

PROPERTY LOCATION:

SUBDIVISION N/A LOT NO NEW LOT ? TENANT HOUSE

ROAD AND DESCRIPTION Triadelphia Rd.

RENOVATION OF EXISTING OUT BUILDING INTO A HOUSE - ? SUBDIVISION REQUIRED

TAX MAP 27 PARCEL # 93

SIZE OF LOT _____ TYPE BLDG _____
(SINGLE FAMILY DWELLING OR COMMERCIAL)

THE SYSTEM INSTALLED UNDER THIS APPLICATION IS ACCEPTABLE ONLY UNTIL PUBLIC FACILITIES BECOME AVAILABLE. I FULLY UNDERSTAND THE FEE CONNECTED WITH THE FILING OF THIS PERC TEST APPLICATION IS NON-REFUNDABLE UNDER ANY CIRCUMSTANCES. I ALSO AGREE TO COMPLY WITH ALL M.O.S.H.A. REQUIREMENTS IN TESTING THIS LOT.

(SIGNATURE OF APPLICANT)

APPROVED BY C. Williams FOR BARN DATE 1/25/91

REJECTED BY _____ FOR _____ DATE _____


HOLD PENDING FURTHER TESTS _____ DATE _____

NOTE:

REASONS FOR REJECTION OR HOLDING OWNER HAS MOVED TENANT HOUSE UPHILL TO A LOCATION THAT WOULD

HD-216

THIS IS NOT A PERMIT

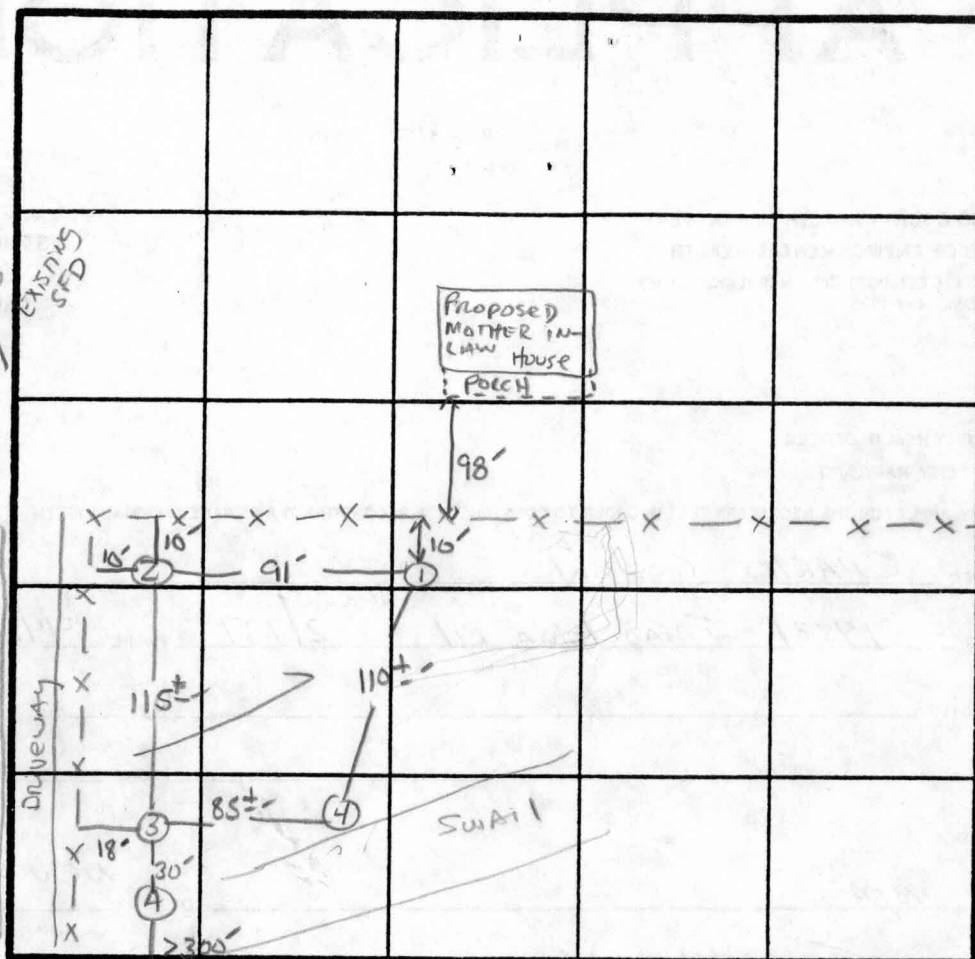

200 ϕ /BR

CL TRIADeLphiA Rd

low 4.0'

Shallow SYST

Chester

Ans. S. Abel

ARNOLD (Wayne)

HOWARD COUNTY HEALTH DEPARTMENT

JOYCE M. BOYD, M.D., M.P.H.
COUNTY HEALTH OFFICER



Bureau of Environmental Health
3525 Ellicott Mills Drive
Ellicott City, Maryland 21043

Director - 461-9956
Water & Sewerage, Permits - 461-9933
Community Environmental Health - 461-9944
Technical Services - 461-9955

August 9, 1988

Mr. Charles Coshen
14831 Triadelphia Road
Glenelg, Maryland 21732

RE: Tax Map 27 Parcel 93
Tenant/Mother-in-Law House

Dear Mr. Coshen:

Percolation testing conducted on August 1, 1988 on the above referenced property indicated satisfactory soil conditions in a area upslope of the tenant house renovation. Due to this location it will be necessary to install a dual sewage pump system for the house.

Approval of the tenant house is contingent upon the following:

1. Submission of a plat showing all percolation test holes.
2. Location of approvable water source (well location) and conveyance system to new house.
3. Submission of a check for \$90.00 - balance of fee for new percolation testing. Testing was not conducted to repair an existing septic system.

Enclosed is a copy of the septic system specifications. If you should have any questions concerning the above, please feel free to contact me at the above address or by calling 461-9933.

Very truly yours,


A handwritten signature in cursive script that reads "Craig Williams".

Craig Williams, Director
Water and Sewerage Program

CW:JR

Enclosure

Signed
Revised
Perc Cert

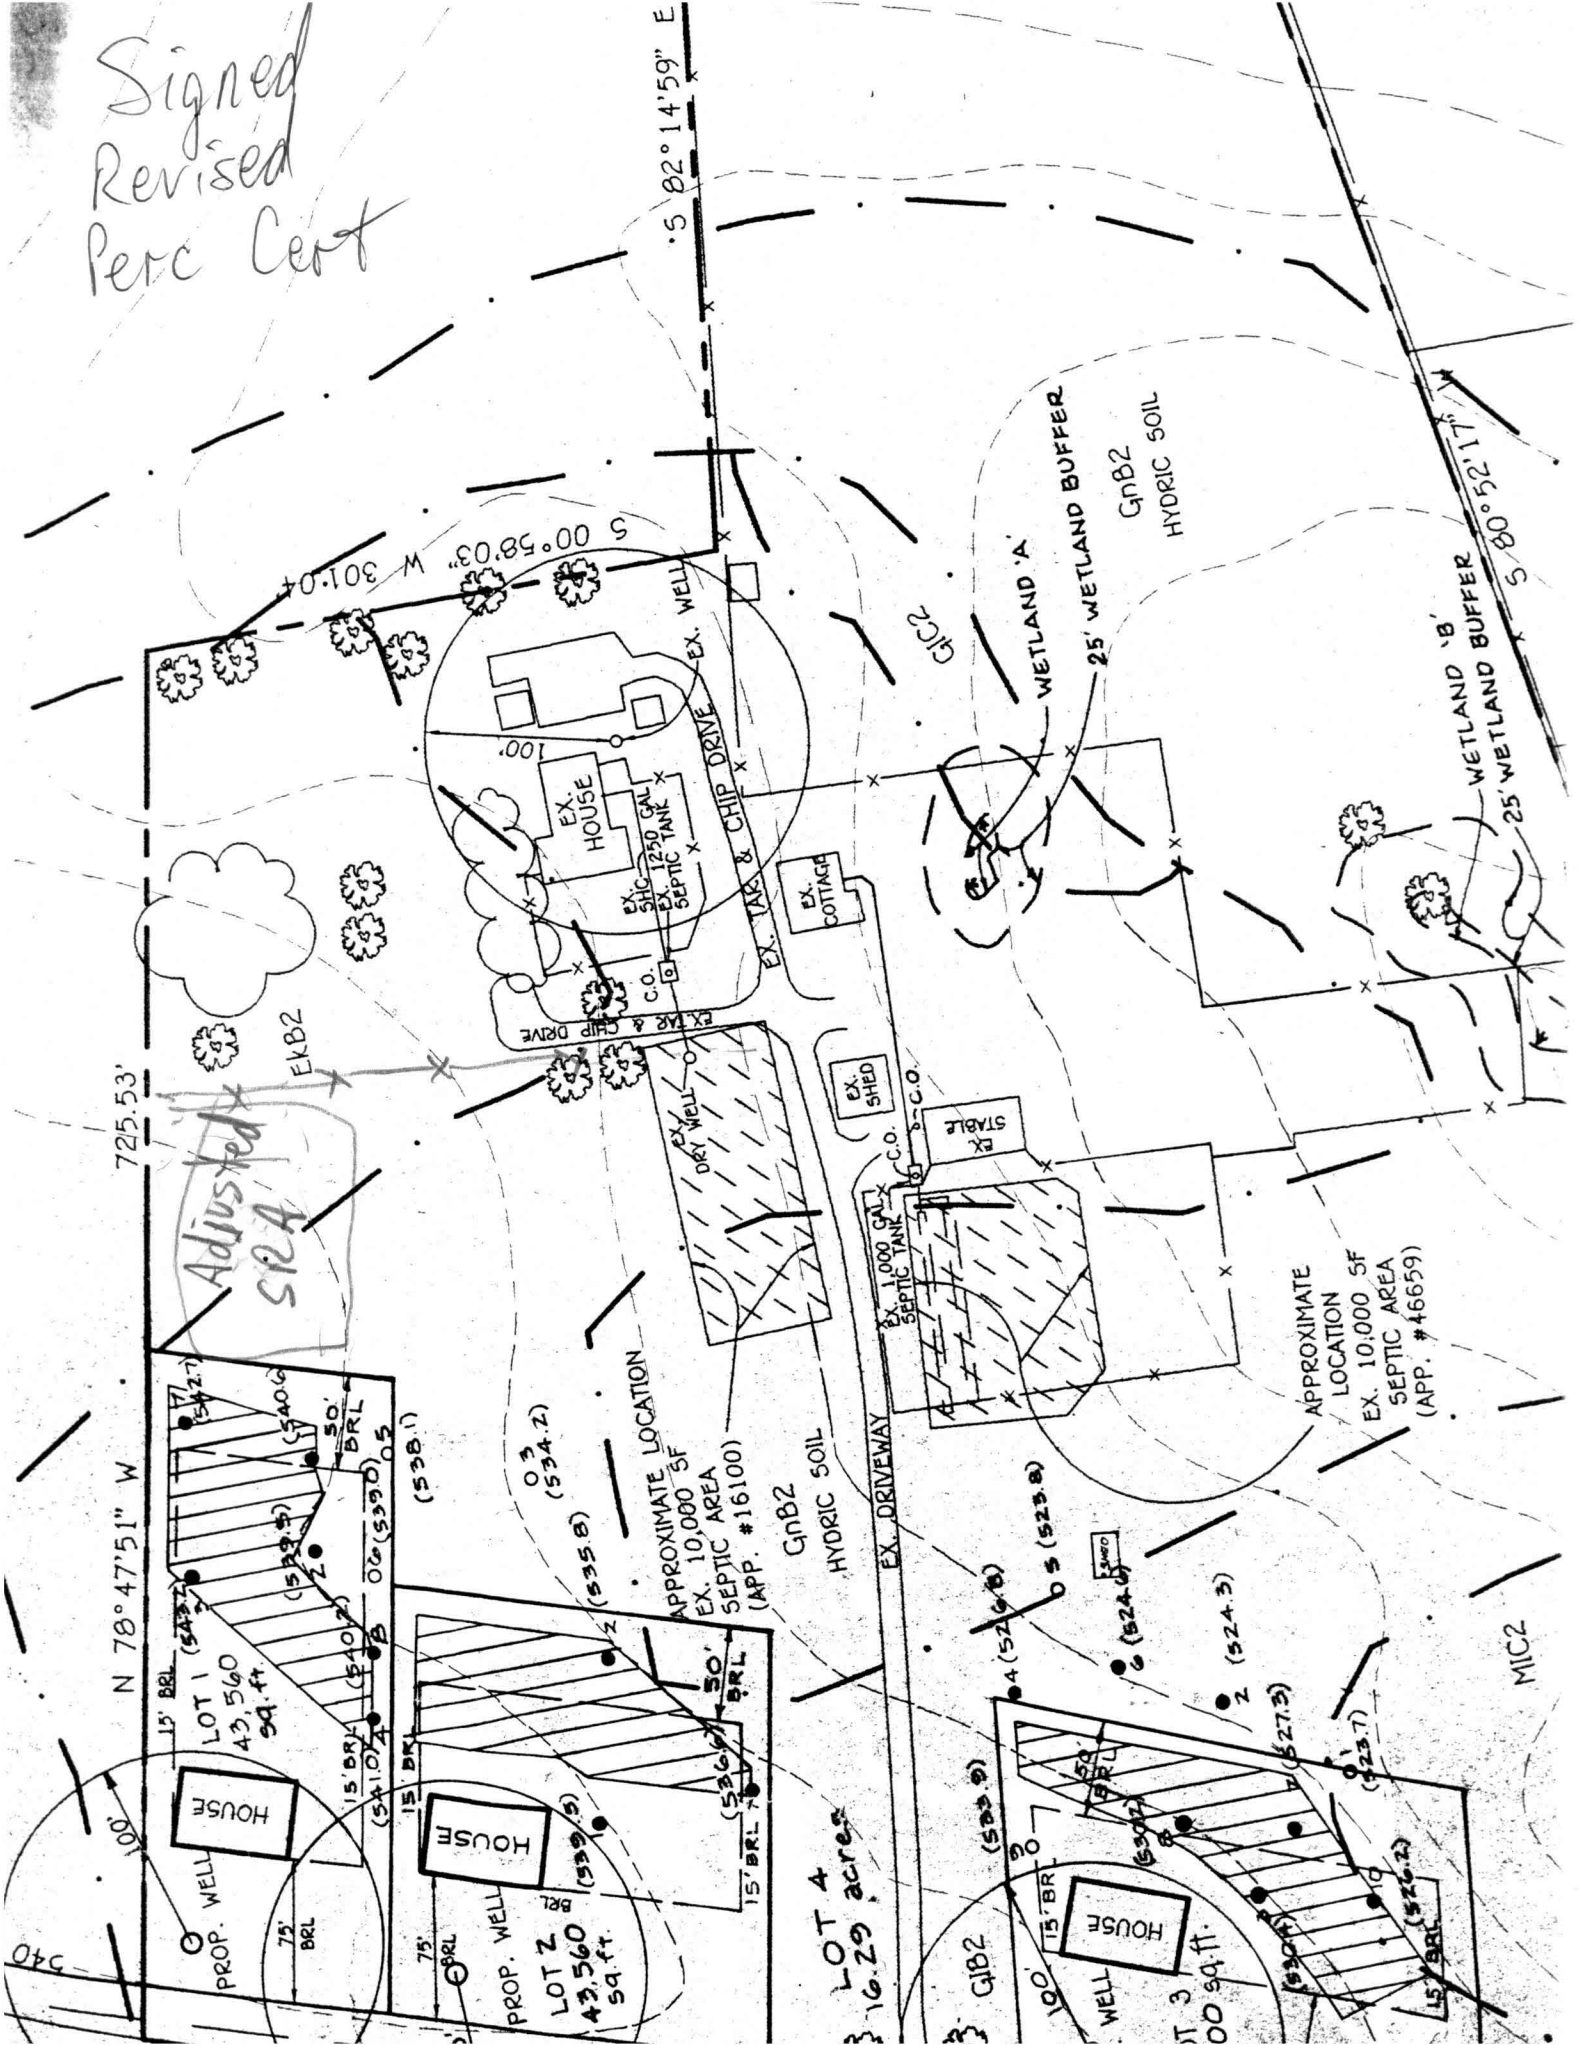

ROAD
(PUBLIC ROAD - MINOR COLLECTOR)
R=3028.00' L=433.06'

D.I. (NOT FND.)

51

S 70°47'50" E

726.37'


E 1307' N 576500

Signed
E-95-57 Plat


I.P. CALLED
670/109
(FND. & HLD.)

5 82

PRE
(U

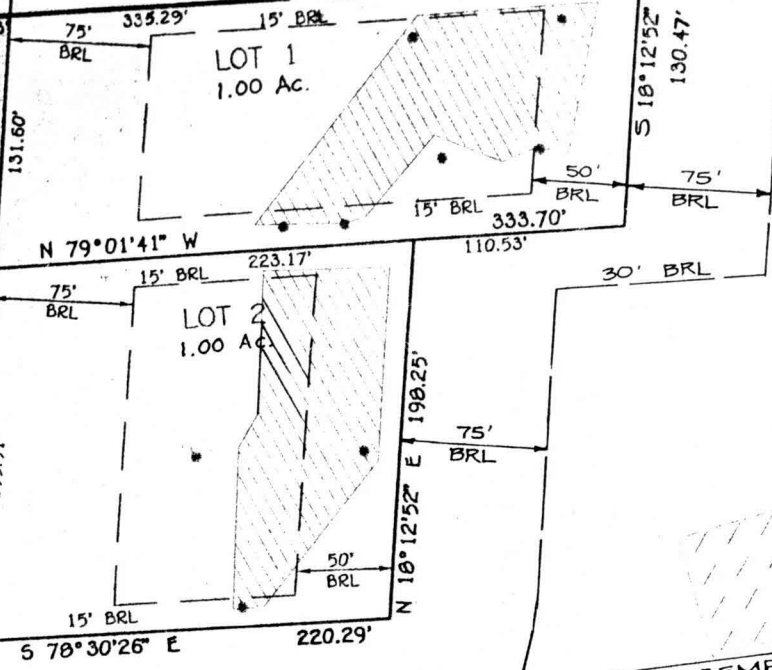

APPROXIMATE LOCATION B.G. & E. R/W EASEMENT 2419 / 212

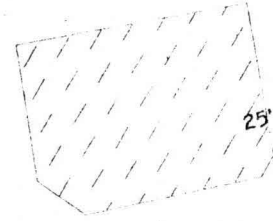

25' WETLAND BUFFER

LIMIT OF WETLAND

100 YEAR FLOODPLAIN DRAINAGE
AND UTILITY EASEMENT (PUBLIC)



LIMIT OF WETLAND

502.7

504.2

504.2


510.0

25' WETLAND BUFFER
75' STREAM
BUFFER

S 80°54'51" W

I.P. CALLED
554/644
(HLD.)

LOT 2

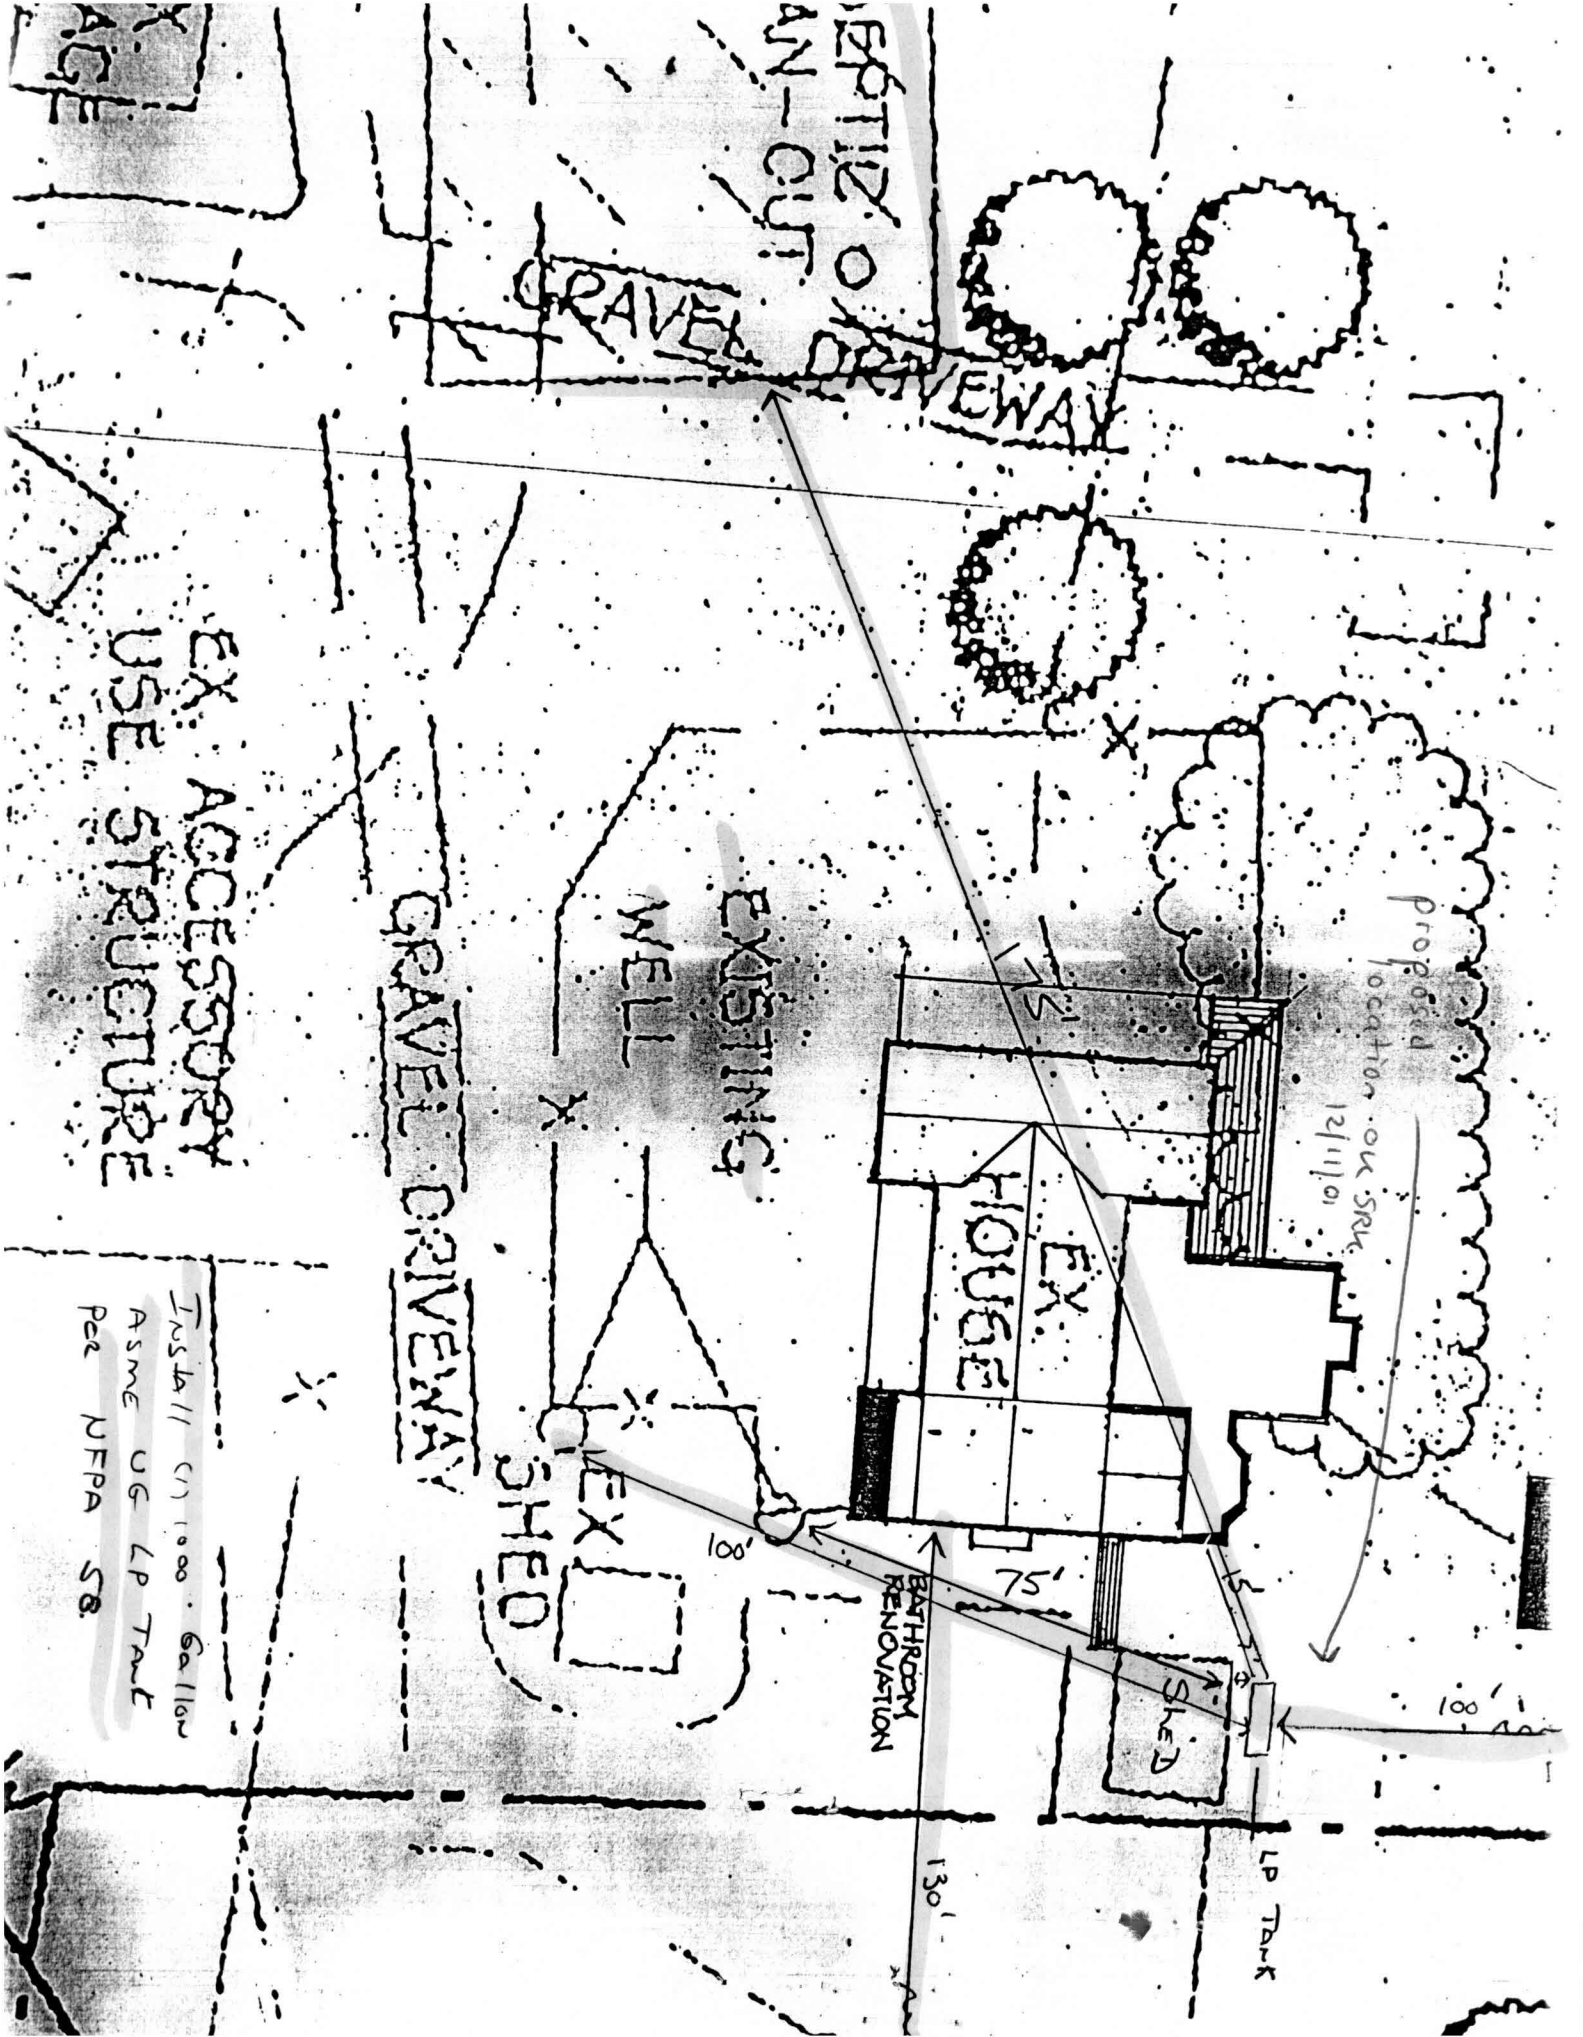

REPORT OF
AN-OUT

GRAVEL DRIVEWAY

GRAVEL DRIVEWAY

EX ACCESSORY
USE STRUCTURE

GRAVEL DRIVEWAY

EXISTING

WELL

EX SHED

EX HOUSE

BATHROOM
RENOVATION

SHED

LP TANK

Proposed
location on SRV
12/11/01

Installed (1) 1000 Gallon
ASME UG LP Tank
Per NFPA 58

1/23/91

I request a Septic System permit
for barn shown on attached plat.
Residence Septic System is now only a
Secondary consideration.


Charles Robert Goshen

PREPARE BARN SEPTIC SYSTEM PERMIT

- BILL INGRAHAM¹⁵ - FARM & HOME EXCAVATING TO INSTALL
- ~~NO~~ SEPTIC INSTALLATION PERMIT REQUIRED

THIS IS A NEW SYSTEM, NOT A REPAIR

- SPECIFY LOCATION IN MIDDLE OF PLATTED AREA.
- IF INFORMAL TEST HOLE LOWER ON PROPERTY AT
TIME OF INSTALLATION IS ACCEPTABLE,
SYSTEM CAN BE MOVED DOWNHILL TO ACCOMMODATE
HOUSE WHICH MAY BE REMODELED.

SITE INSPECTION SHEET

OWNER: GOSHEN

DATE REQUESTED: 1/10/91

ADDRESS: 14831 Triadelphia Rd


~~DRILLER~~: Bill Ingram

WELL TAG # _____

COUNTY # _____

PROPOSAL: Desires new barn and refurbished cottage on one
septic; otherwise reduced individual systems

LOCATION DIAGRAM

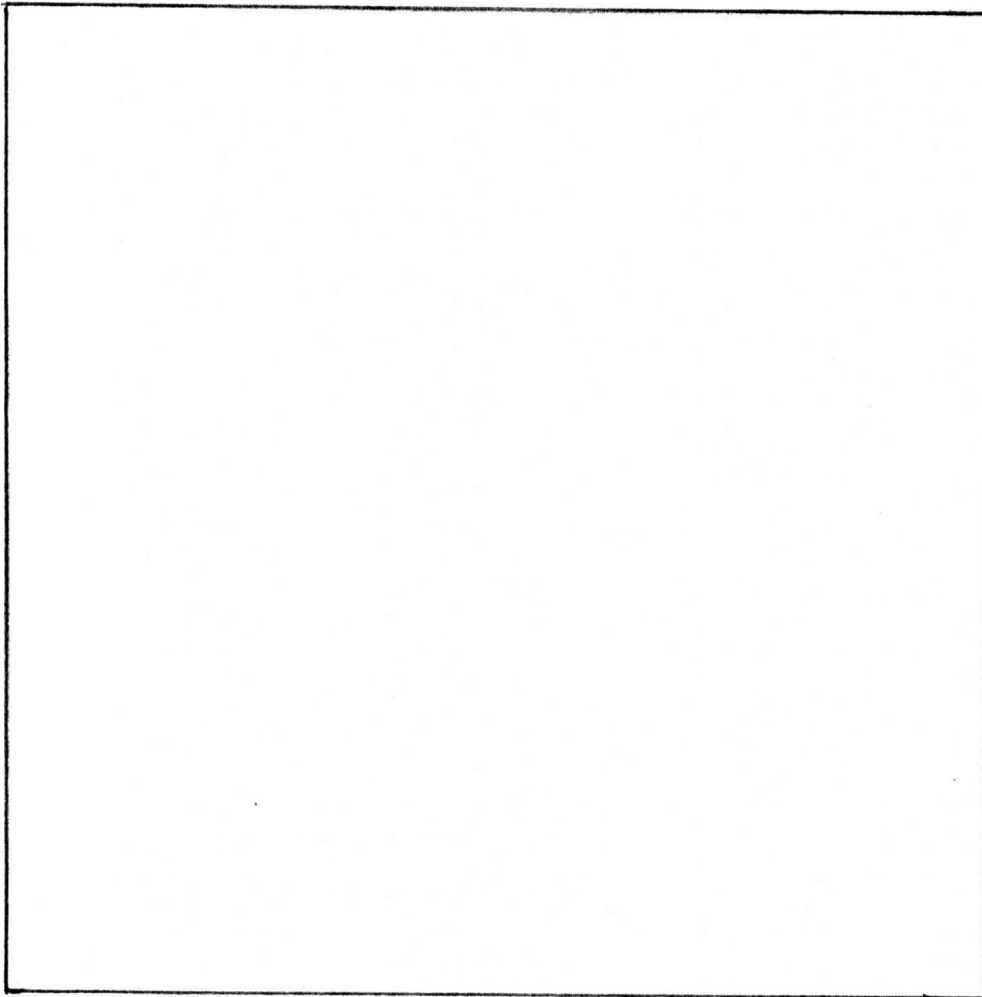

COMMENTS: SEE SEPTIC PERMIT MR

DATE: _____ INSPECTOR: _____