

930
10/15/76
a.m. if possible

PERMIT

SEWAGE DISPOSAL SYSTEM

MARYLAND STATE DEPARTMENT OF HEALTH

HOWARD COUNTY

ELLICOTT CITY

DISTRICT 5

DATE 8/9/76

INDEXED

P 2-36-92

A 22959

Donald Parlette IS PERMITTED TO INSTALL ALTER

ADDRESS Clarksville, Maryland PHONE 286-2140

A SEWAGE DISPOSAL SYSTEM LOCATED AT _____

SUBDIVISION 6485 Trotter Road ROAD Trotter Road LOT 1

PROPERTY OWNER Elizabeth Scott

ADDRESS _____

SPECIFICATIONS - 4 bedrooms

DRAIN FIELD _____ DEPTH _____ FEET, BOTTOM AREA _____ SQ. FT.

SEEPAGE PITS _____ ABSORBENT SIDE-WALL AREA _____ SQ. FT.

SEPTIC TANK CAPACITY 1,250 GALLONS

FOR GARBAGE GRINDER, INCREASE DISPOSAL AREA 22% & TANK CAPACITY 50%.
9/17/76 *on Dry Well + Trench*
OTHER Dry well to have 125 sq. ft. effective absorbant sidewall area per bedroom below

inlet. Inlet to be 4 ft. below original grade and maximum depth 12 ft. Location 60 ft. from rear property line and 45 ft. from right property line when facing lot from road (perc hole 1 & 2)

NOTE: ALL PIPE FROM HOUSE TO DISPOSAL AREA MUST BE CAST IRON. *Trench needs 2 inspections*
PERMIT VOID AFTER THREE YEARS.

NOTE: INSTALL STAND PIPE ON SEPTIC TANK AND DRY WELL. STAND PIPE MUST BE 6" IN DIA., CAST IRON, CONCRETE OR TERRA COTTA ACCEPTED.

PLANS APPROVED BY C. B. Streaker DATE 7/7/76

FILL SEPTIC TANK AND DISTRIBUTION BOX WITH WATER BEFORE CALLING FOR AN INSPECTION. COVER NO WORK UNTIL INSPECTED AND APPROVED. *1 before gravel installed + 1 after*

NEITHER THE HOWARD COUNTY COMMISSIONERS NOR THE HEALTH DEPARTMENT IS RESPONSIBLE FOR THE SUCCESSFUL OPERATION OF ANY SYSTEM. *Trench need 2 inspections between it*

Trench Bucket Width 18" to 2'

28959

PERMIT

SEWAGE DISPOSAL SYSTEM

MARYLAND STATE DEPARTMENT OF HEALTH

HOWARD COUNTY

ELLICOTT CITY

DISTRICT 5

DATE 8/9/76

P. 29692

A. 22959

Donald Parlette IS PERMITTED TO INSTALL ALTER

ADDRESS Clarksville, Maryland PHONE 286-2140

A SEWAGE DISPOSAL SYSTEM LOCATED AT _____

SUBDIVISION _____ ROAD Trotter Road LOT 1

PROPERTY OWNER Elizabeth Scott

ADDRESS _____

SPECIFICATIONS - 4 bedrooms

DRAIN FIELD _____ DEPTH _____ FEET, BOTTOM AREA _____ SQ. FT.

SEEPAGE PITS _____ ABSORBENT SIDE-WALL AREA _____ SQ. FT.

SEPTIC TANK CAPACITY 1,250 GALLONS

FOR GARBAGE GRINDER, INCREASE DISPOSAL AREA 22% & TANK CAPACITY 50%.

OTHER Dry Well & Trench Dry well to have 125 sq. ft. effective absorbent sidewall area per bedroom below

inlet. Inlet to be 4 ft. below original grade and maximum depth 12 ft. Location 60 ft. from rear property line and 45 ft. from right property line when facing lot from road (perc hole 1 & 2).


NOTE: ALL PIPE FROM HOUSE TO DISPOSAL AREA MUST BE CAST IRON. Trench needs 2 inspections before gravel installed
PERMIT VOID AFTER THREE YEARS.

NOTE: INSTALL STAND/PIPE ON SEPTIC TANK AND DRY WELL. STAND PIPE MUST BE 6" IN DIA., CAST IRON, CONCRETE OR TERRA COTTA ACCEPTED.

PLANS APPROVED BY C. B. Streaker DATE 7/7/76


FILL SEPTIC TANK AND DISTRIBUTION BOX WITH WATER BEFORE CALLING FOR AN INSPECTION. COVER NO WORK UNTIL INSPECTED AND APPROVED. +1. after trench needs 5' earth buffer between it and dry well.

NEITHER THE HOWARD COUNTY COMMISSIONERS NOR THE HEALTH DEPARTMENT IS RESPONSIBLE FOR THE SUCCESSFUL OPERATION OF ANY SYSTEM. CBG

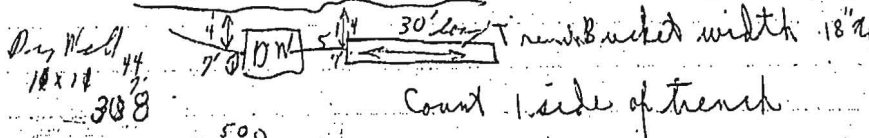

500
707
21200 30

Count side of trench

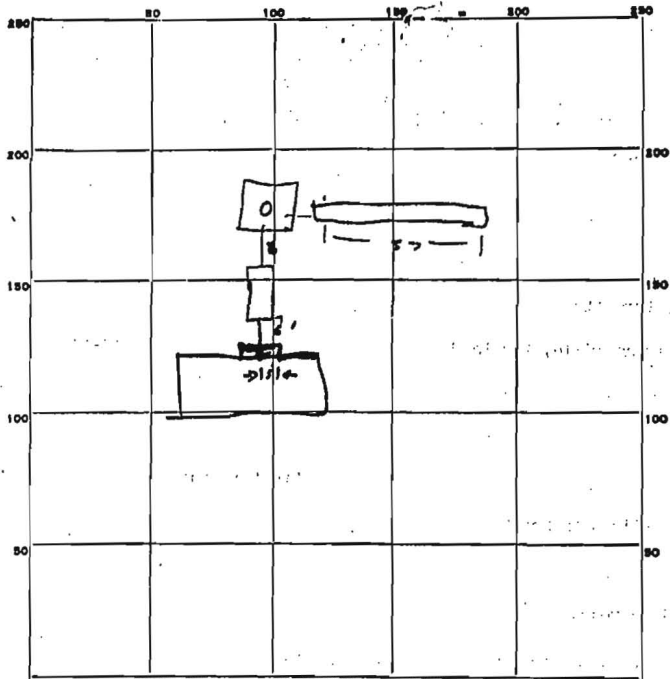

125
4
500

37
8
296
48
7
335

INDICATE NORTH. - NAME ADJOINING ROADWAY AS BASE LINE.

PERMIT CARD

SEPTIC TANK, LEVEL

CLEANOUTS

DISTRIBUTION BOX, LEVEL

TILE FIELD, DEPTH 12 FT. TRENCH WIDTH 2 FT.

GRAVEL DEPTH 8 9 FT. TOTAL LENGTH 37 FT.

NUMBER OF TRENCHES 1 TOTAL BOTTOM AREA 296

SEE PAGE PITS, INSIDE DIAMETER 48 FT. DEPTH BELOW INLET 7 1/2 FT. (line @ 35)

ABSORBENT AREA 6 34 SQ. FT.

REMARKS 10/14/76 - Moorfield inspected
10/15/76 - Rocks put in ditch today
Ditch has 9 ft of Rock it is 37 ft long
& 4 x 125 = 600 sq ft needed
Water well not seen

DATE SYSTEM APPROVED 10/15/76 R/H INSPECTOR R Moorfield