

Fill out this form.
Make \$10.00 cash payable to
Howard County Health Dept. (Sanitation)

4-13' Releasement plot must be submitted.
and 10,000 ft.

APPLICATION

A 22959

F. Nelson

SEWAGE DISPOSAL TESTING

STATE OF MARYLAND - DEPARTMENT OF HEALTH AND MENTAL HYGIENE

HOWARD COUNTY HEALTH DEPARTMENT
ENVIRONMENTAL HEALTH SERVICES
P. O. BOX 476, ELLICOTT CITY, MARYLAND 21043
TELEPHONE: 443-5000, EXT. 358

Bedrooms 1-3 Septic Tank 1000 gallons
Bedrooms 4 Septic Tank 1250 gallons
DISTRICT 13
DATE 7/15/76

4/1/76
3/1/76
9:30

My well to have 125' effective
absorbant sidewall area per bedroom below
init. Well to be 4' below original grade and maximum
depth 12'. Location 60' from rear property line
and 45' from right property line when plumb lot
from road. (Here hole 12)

TO: THE COUNTY HEALTH OFFICER
ELLICOTT CITY, MARYLAND

I, HEREBY, APPLY FOR THE NECESSARY TEST IN ORDER TO CONSTRUCT (OR RECONSTRUCT) A SEWAGE
DISPOSAL SYSTEM.

PROPERTY OWNER Elizabeth Scott

ADDRESS Route 32, Clarksville, Maryland PHONE _____

PROPERTY LOCATION:

SUBDIVISION _____ LOT NO. 1

ROAD AND DESCRIPTION Trotter Road

SIZE OF LOT 5.53149 TYPE BLDG. 3 or 4

IF NOT SINGLE RESIDENCE DESCRIBE _____
(Single Famly. Dully.)

THE SYSTEM INSTALLED UNDER THIS APPLICATION IS ACCEPTABLE ONLY UNTIL PUBLIC
FACILITIES BECOME AVAILABLE.

SIGNATURE OF APPLICANT /s/ Elizabeth Scott

APPROVED BY C. B. Stucker FOR Reg. Well DATE 7/7/76

REJECTED BY _____ FOR _____ DATE _____
(KIND OF SYSTEM)

HOLD PENDING FURTHER TESTS _____ DATE _____

REASONS FOR REJECTION OR HOLDING 4/1/76 Hold for house plan. & alterations

BLDG. PERMIT SIGNED _____
AND RETURNED 7/7/76 C.B.S.

THIS IS NOT A PERMIT

Preliminary

APPLICATION

A22959

SEWAGE DISPOSAL TESTING

P _____

STATE OF MARYLAND - DEPARTMENT OF HEALTH AND MENTAL HYGIENE

HOWARD COUNTY HEALTH DEPARTMENT
ENVIRONMENTAL HEALTH SERVICES
P. O. BOX 476, ELLICOTT CITY, MARYLAND 21043
TELEPHONE: 443-5000, EXT. 356

DISTRICT 5

DATE 3/15/76

TO: THE COUNTY HEALTH OFFICER
ELLICOTT CITY, MARYLAND

I, HEREBY, APPLY FOR THE NECESSARY TEST IN ORDER TO CONSTRUCT (OR RECONSTRUCT) A SEWAGE DISPOSAL SYSTEM.

PROPERTY OWNER Elizabeth Scott

ADDRESS Route 32, Clarksville, Maryland PHONE _____

PROPERTY LOCATION:

SUBDIVISION _____ LOT NO. 1

ROAD AND DESCRIPTION Trotter Road

SIZE OF LOT 5.53149 TYPE BLDG. 1 or 4

IF NOT SINGLE RESIDENCE DESCRIBE _____
NUMBER OF BEDROOMS
(Single Fmly. Donly.)

THE SYSTEM INSTALLED UNDER THIS APPLICATION IS ACCEPTABLE ONLY UNTIL PUBLIC FACILITIES BECOME AVAILABLE.

SIGNATURE OF APPLICANT /s/ Elizabeth Scott


APPROVED BY _____ FOR _____ DATE _____
(KIND OF SYSTEM)

REJECTED BY _____ FOR _____ DATE _____
(KIND OF SYSTEM)

HOLD PENDING FURTHER TESTS _____ DATE _____

REASONS FOR REJECTION OR HOLDING _____

THIS IS NOT A PERMIT

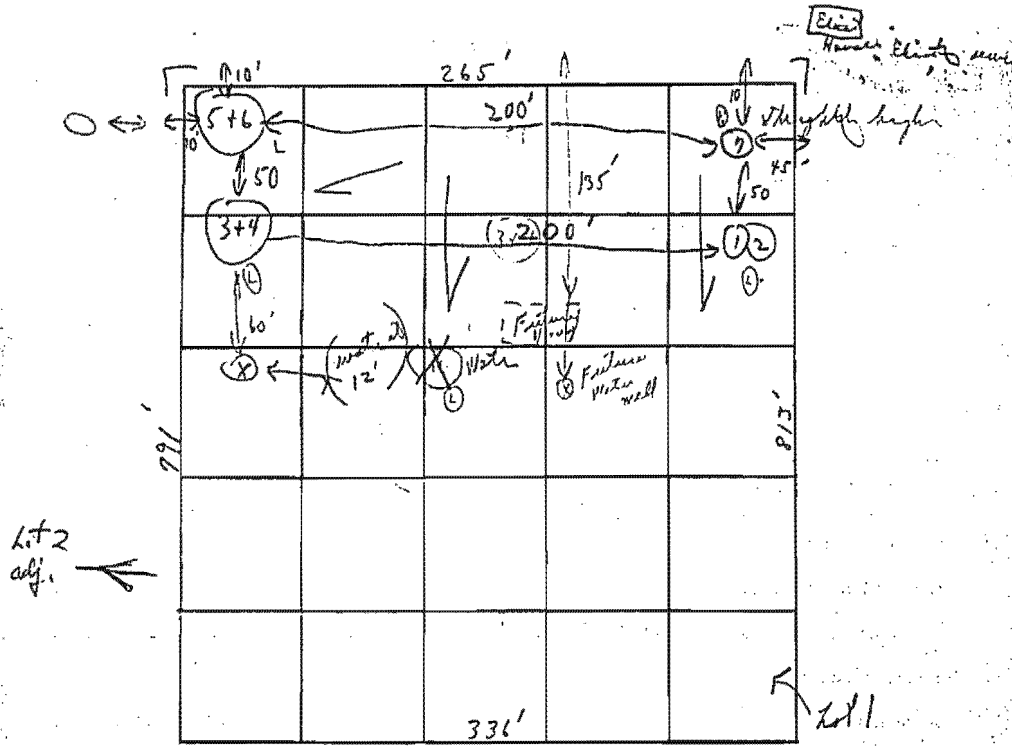

INDICATE NORTH - NAME ADJOINING ROADWAY AS BASE LINE.

← Trotter Road


DATE	TEST NO.	DEPTH	PRE-WET		TEST - 1" DROP		TIME	
			START	STOP	START	STOP		
4/1/76	1	4 1/2'	10:45	10:47	10:47	10:50	3 min	
	2	13'	10:45	10:47	10:47	10:54	7 min	
	3	4'	11:08	11:10	11:10	11:15	5 min	
	4	13'	11:08	11:10	11:10	11:16	6 min	
	5	4 1/2'	10:59	11:01	11:01	11:04	3 min	
	6	13 1/2'	10:58	11:01	11:01	11:07	6 min	
	7	12'	Visual similarities to other				6	30 min

REMARKS: Open field Note differences in 135' sites only in elevations

TYPE OF SOIL: Hard pan in yellow clay

TESTED BY: C. B. J. ALSO PRESENT: Paul Stewartman

34. Hunt 25880

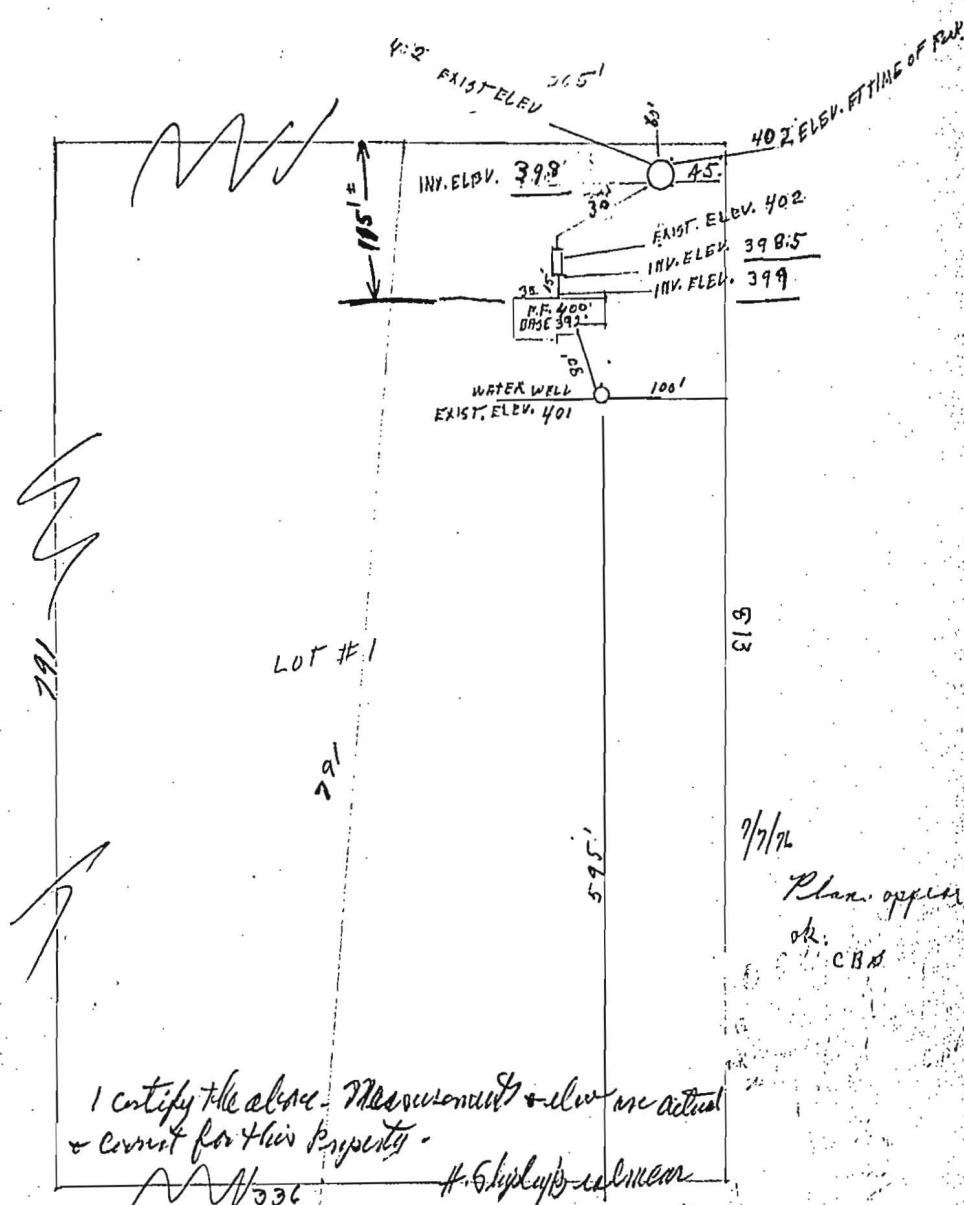

I certify the above measurements & elevations are actual
 & correct for this property.

[Signature]

TROTTER ROAD

6791 RT. 32
 531-5602

MRS. E.P. SCOTT
 TROTTER RD - ROUT 32
 5TH. ELECT. DIST.

P. 23692 A. 22959
DATE 8/2/76 3/15/76

6485

LOCATION Trotter Road

APPLICATION

HOLD
APPROVED
REJECTED

LOT 1

APPLICANT Elizabeth Scott

INSTALLATION

OWNER Elizabeth Scott

HOLD
APPROVED

PERMITTEE Donald Parlette

APPROVED DATE 10/15/76