

DEPARTMENT OF INSPECTIONS, LICENSES AND PERMITS
3430 COURT HOUSE DRIVE
ELLICOTT CITY, MD 21043
PERMITS (410)313-2455 INSPECTIONS (410)313-1810
AUTOMATED INFORMATION (410) 313-3800

HOWARD COUNTY PERMIT APPLICATION

PERMIT NUMBER

200131416 4

Building Address 3500 Winding Path Ct.
Glenwood, MD 21738
Suite /Ap L #: N/A SDP/WP/P etition #: GP-99-208
Census Tract 6040 Subdivision Cattail Ridge
Section N/A Area N/A Lot 19
Tax Map 21 Parcel 228 Grid
Zoning RCDEO Map Coordinates 9A8 Lot size

Property Owner's Name Goodier Builders, Inc.
Address 10705 Charter Dr.
City Columbia State MD Zip Code 21044
Home Phone Work Phone 410-997-7400
Applicant's Name & Mailing Address, (if other than stated hereon):
Building Permit Services, Inc. - Pat Orla
7806 Deboy Ave., Balto., MD 21222
Phone 410-477-9666 Fax 410-477-8437

Existing Use Vacant Lot
Proposed Use SFD
Estimated Construction Cost \$ 150,000.00
Description of Work Const SFD-"AG"- 2sty,full basmt, R
FB, HB,FP & Garage(4 Br) w/ Driv

Contractor Company Owner
Contact Person Michael McDonald
Address
City State Zip Code
License No. MHBR# 130
Phone Fax

Occupant or Tenant
Contact Name
Address
City State Zip Code
Phone Fax

Engineer or Architect Company
Contact Person
Address
City State Zip Code
Phone Fax

BUILDING DESCRIPTION - COMMERCIAL

Building Characteristics	Utilities
Height: _____	Water Supply: _____ Public _____ Private _____
No. of stories: _____	Sewage Disposal _____ Public _____ Private _____
Gross area, sq. ft. per floor: _____	Electric Yes ☐ No ☐ Gas Yes ☐ No ☐
Use group _____	Heating System: _____ Electric ☐ Oil ☐ Natural Gas ☐ Propane Gas ☐
Construction type: _____ Reinforced Concrete _____ Structural Steel _____ Masonry _____ Wood Frame _____	Sprinkler system: <u>N/A</u> ☐ Full _____ Partial _____ Other Suppression _____ # of Heads _____
State Certified Modular _____	

BUILDING DESCRIPTION - RESIDENTIAL

Building Characteristics	Utilities
SF Dwelling ☒ SF Townhouse ☐ Depth Width 1st floor: _____ 2nd floor: _____ Basement: _____ Finished Basement ☐ Unfinished Basement ☒ Crawl space ☐ Slab on Grade ☐ No. of Bedrooms <u>4</u> Multi-family dwellings: No. of efficiency units: _____ No. of 1 BR units: _____ No. of 2 BR units: _____ No. of 3 BR units: _____ Other Structure: _____ Dimensions: _____ Footings: _____ Roof: _____ State Certified Modular _____ Manufactured Home _____	Water Supply: _____ Public _____ Private ☒ Sewage Disposal _____ Public _____ Private ☒ Electric Yes ☒ No ☐ Gas Yes ☒ No ☐ Heating System: _____ Electric ☐ Oil ☐ Natural Gas ☒ Propane Gas ☐ Sprinkler system: <u>N/A</u> ☐ NFPA #13D _____ NFPA#13R _____ Other: _____

THE UNDERSIGNED HEREBY CERTIFIES AND AGREES AS FOLLOWS: (1) THAT HE/SHE IS AUTHORIZED TO MAKE THIS APPLICATION; (2) THAT THE INFORMATION IS CORRECT; (3) THAT HE/SHE WILL COMPLY WITH ALL REGULATIONS OF HOWARD COUNTY WHICH ARE APPLICABLE HERETO; (4) THAT HE/SHE WILL PERFORM NO WORK ABOVE REFERENCED PROPERTY NOT SPECIFICALLY DESCRIBED IN THIS APPLICATION; (5) THAT HE/SHE WANTS COUNTY OFFICIALS THE RIGHT TO ENTER ONTO THIS PROPERTY FOR THE PURPOSE OF INSPECTING THE WORK PERMITTED AND POSTING NOTICES.

Applicant's Signature Agent
Title/Company

Building Permit Services, Inc. - Pat Orla
Print Name
7/10/01
Date


Checks payable to: **DIRECTOR OF FINANCE OF HOWARD COUNTY**
** PLEASE WRITE NEATLY AND LEGIBLY. **
- FOR OFFICE USE ONLY -

AGENCY	DATE	SIGNATURE APPROVAL
Land Development DPZ		
State Highways		
Building Official		
Dev. Engineering DPZ	7/30/01	M. P. Orla
Health		
Fire Protection		
Sediment Control approval required prior to issuance?		
YES ☐ NO ☐		


DPZ SETBACK INFORMATION	PROPERTY ID#
Front: _____	Filling fee \$ <u>25.00</u>
Rear: _____	Permit fee \$ _____
Side: _____	Excise tax \$ _____
Side St.: _____	Subtotal paid \$ _____
All minimum setbacks met? YES ☐ NO ☐	Add'l permit fee \$ _____
Is Entrance Permit required? YES ☐ NO ☐	TOTAL FEES \$ _____
Historic District? YES ☐ NO ☐	Balance due \$ _____
Lot Coverage for New Town Zone _____	Check # <u>253</u>
SDP/Red-line, approval date _____	Validation # <u>1102</u>
Accepted by _____	

Distribution of Copies- White: Building Official Green: LDD, DPZ Yellow: DED, DPZ Pink: Health Gold: SHA

20

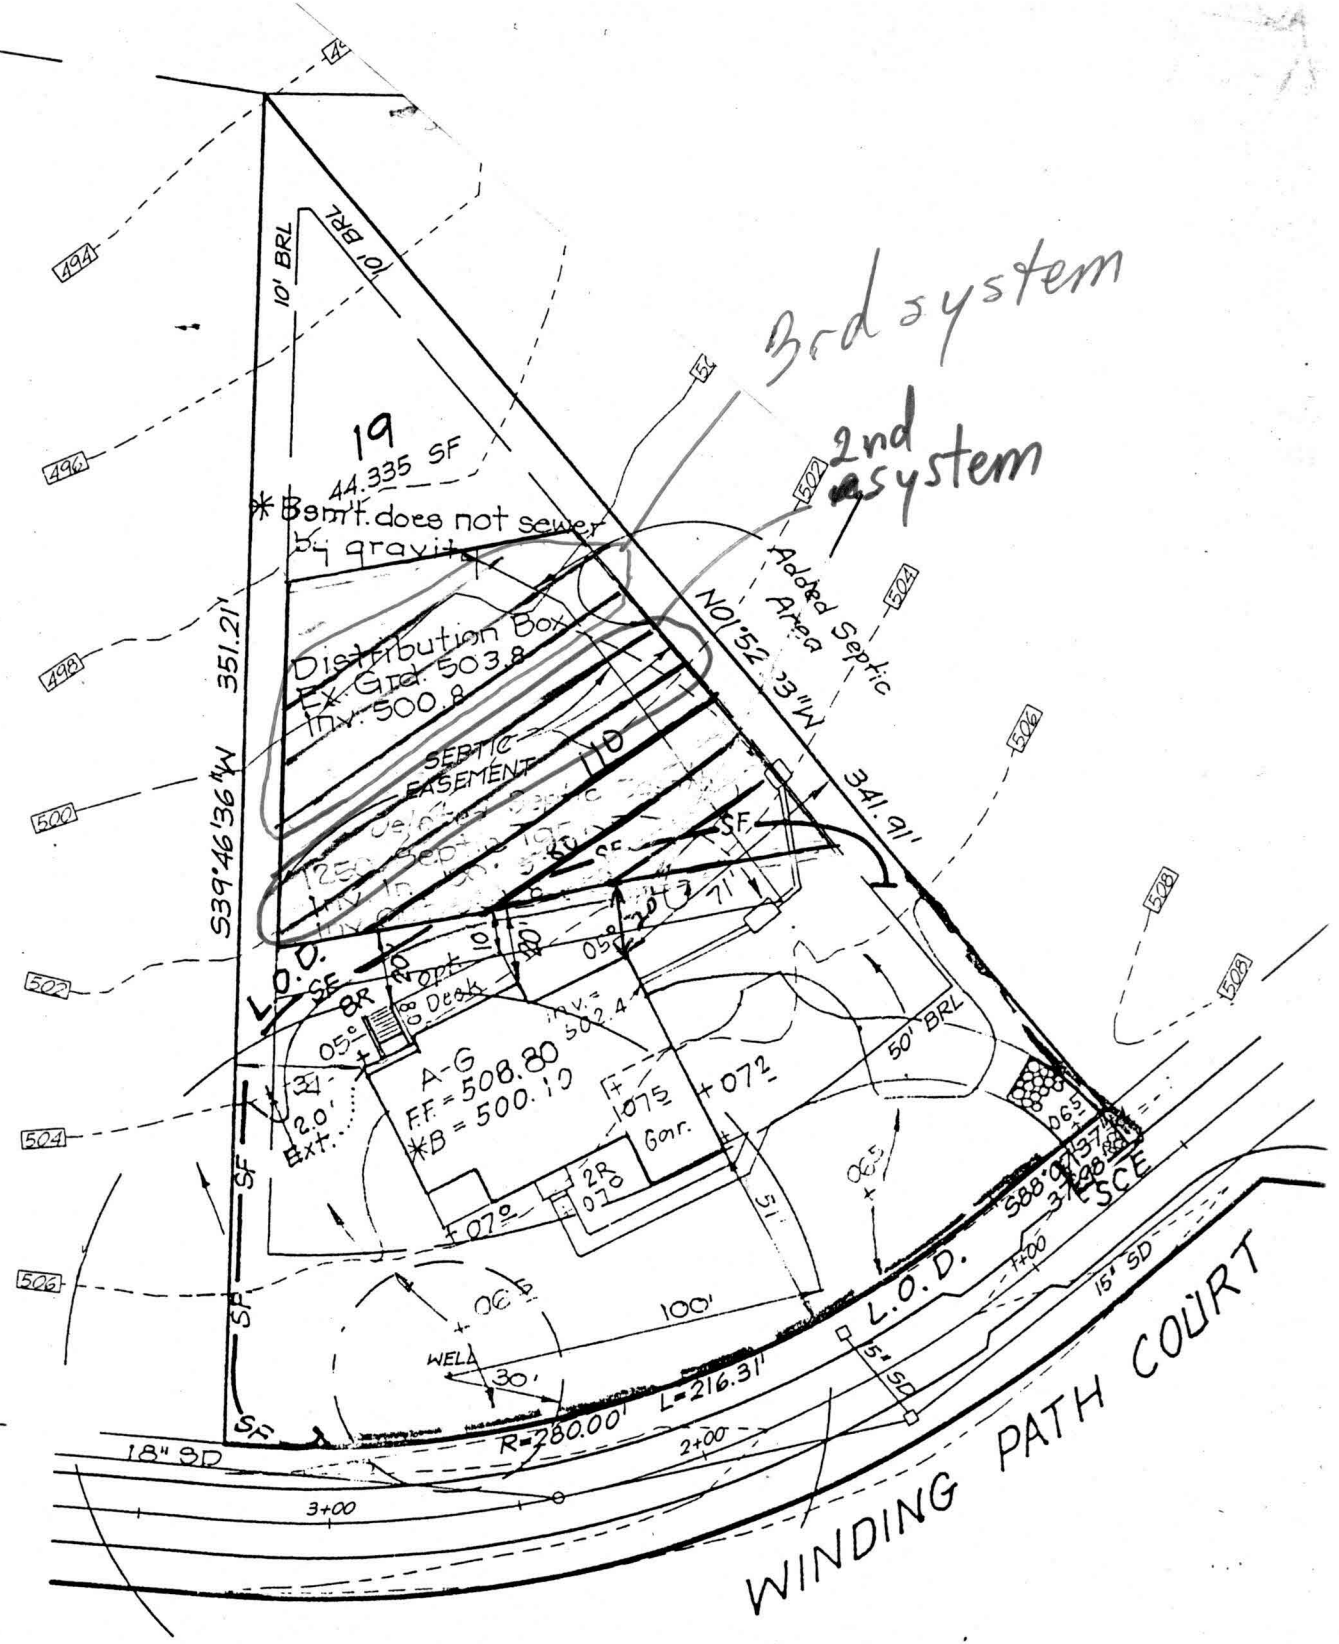


20

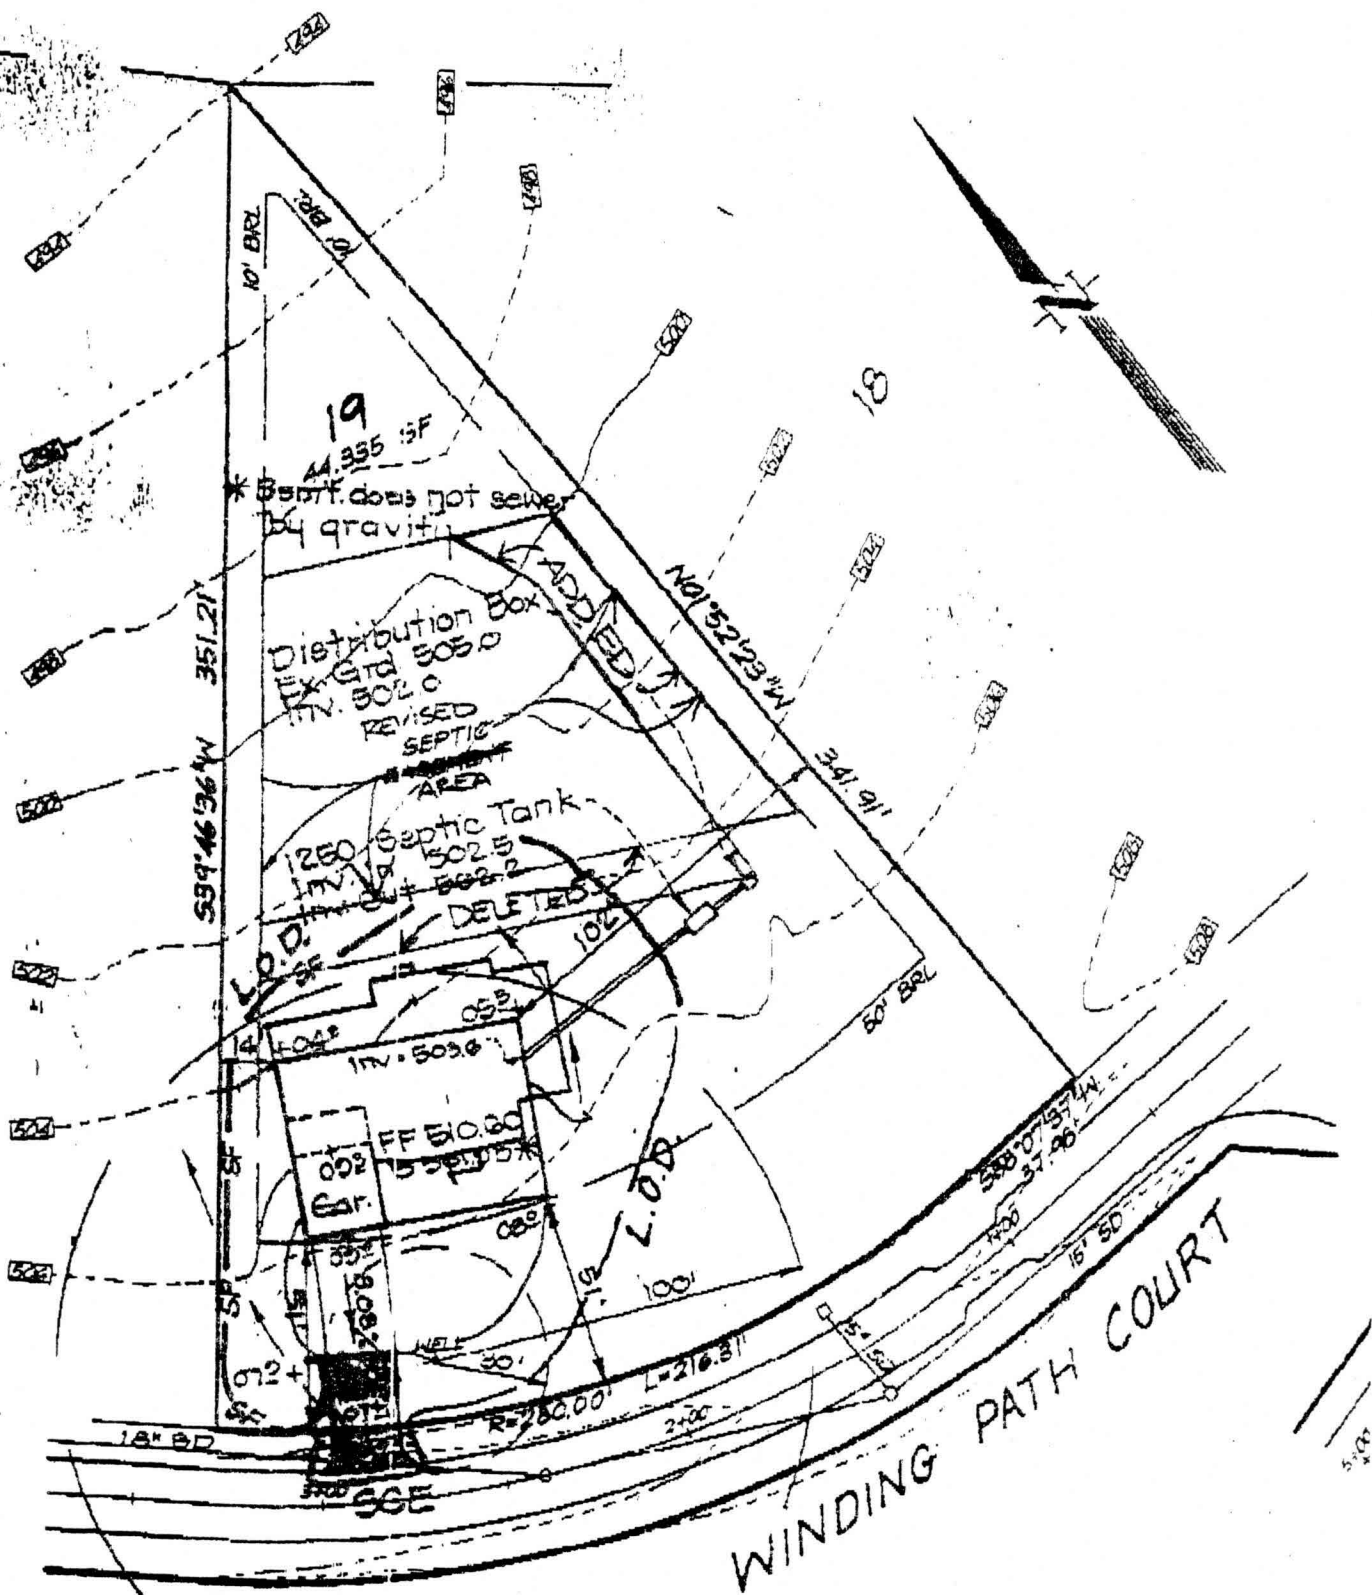

3'

33.6'

6'

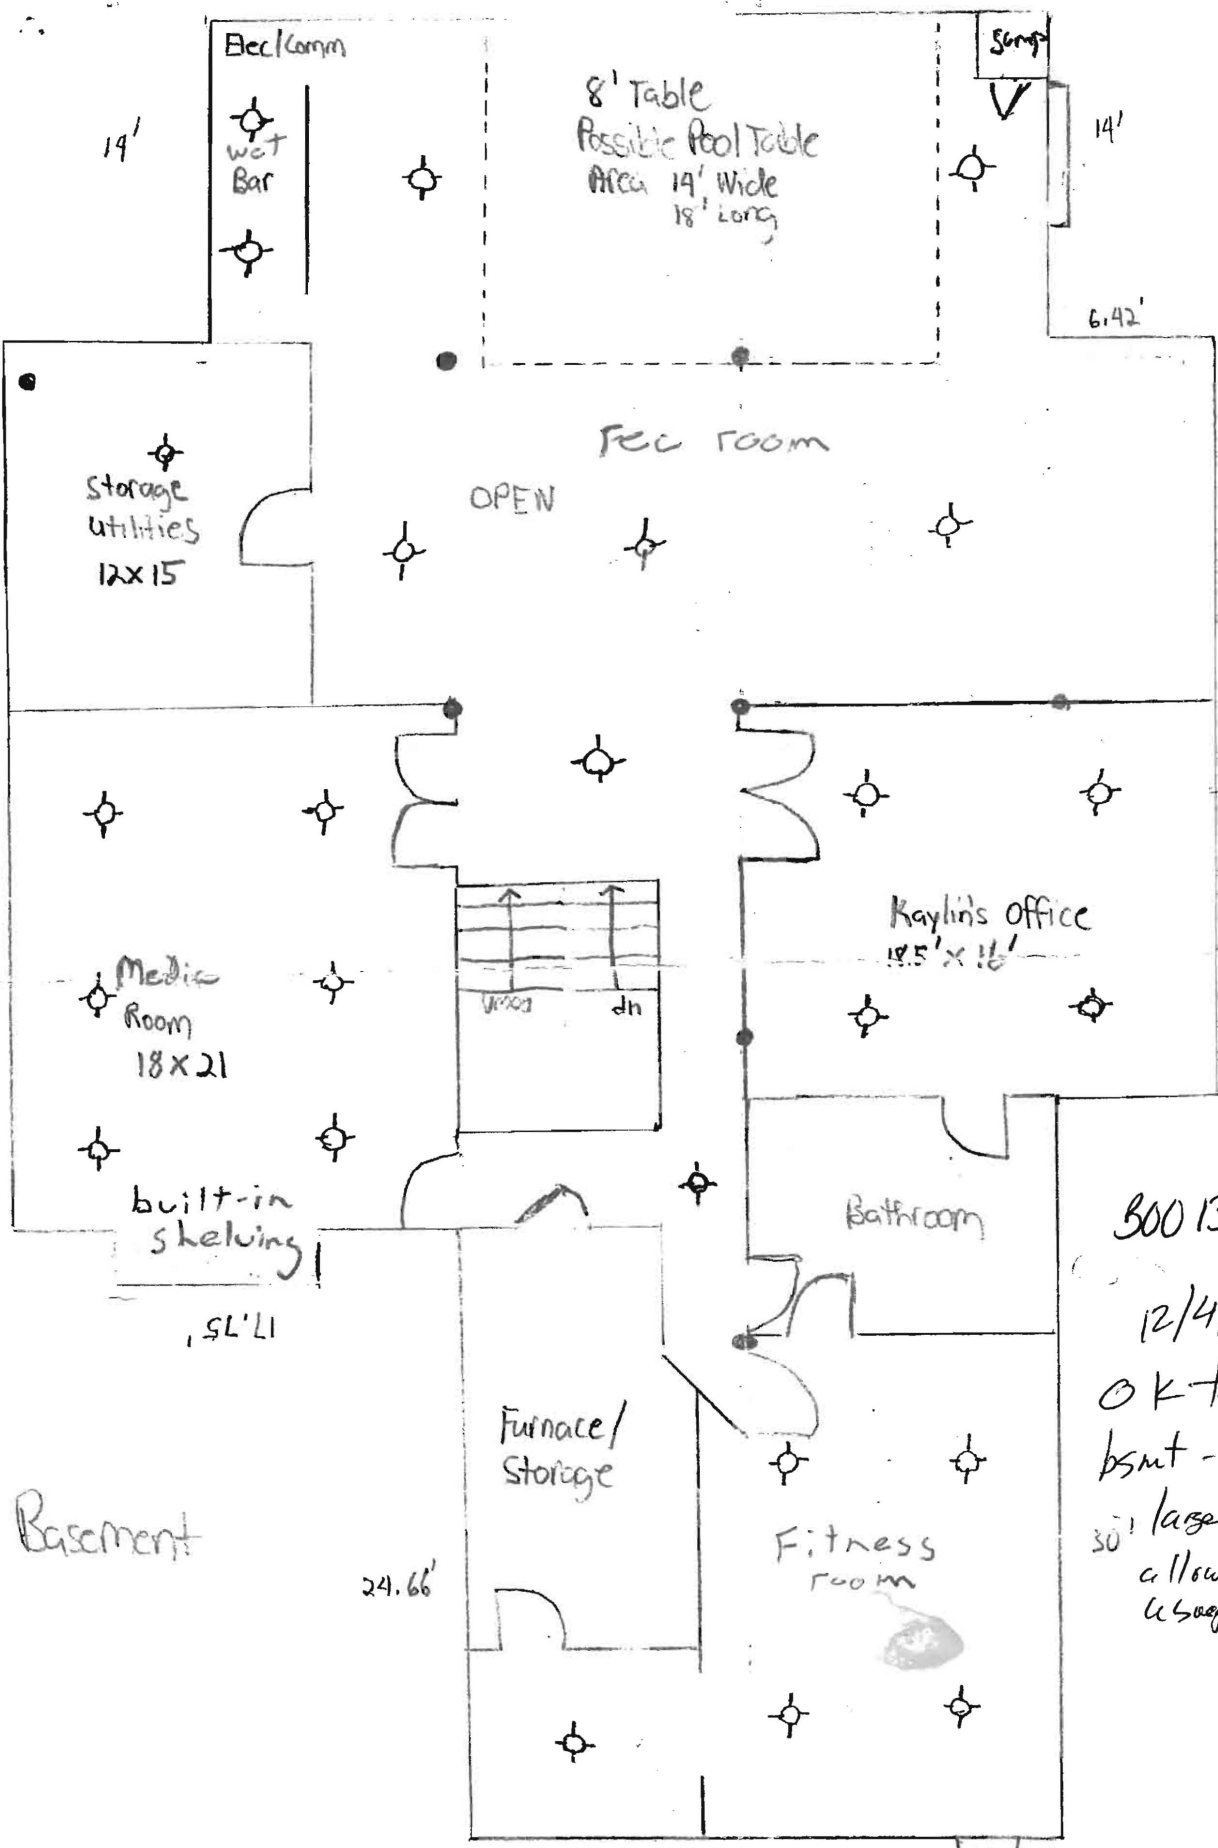

Basement

800 139598

12/4/02

OK to finish
bsmt - window not
so large enough to
allow bedroom
usage